


PARENT PARCEL: 10-00-003-101-003, -004, -005, -009

CHILD PARCEL: XX-XX-XXX-XXX-XXX

STARTING POINT: SOUTHWEST CORNER OF S/L 21

17-03609-D

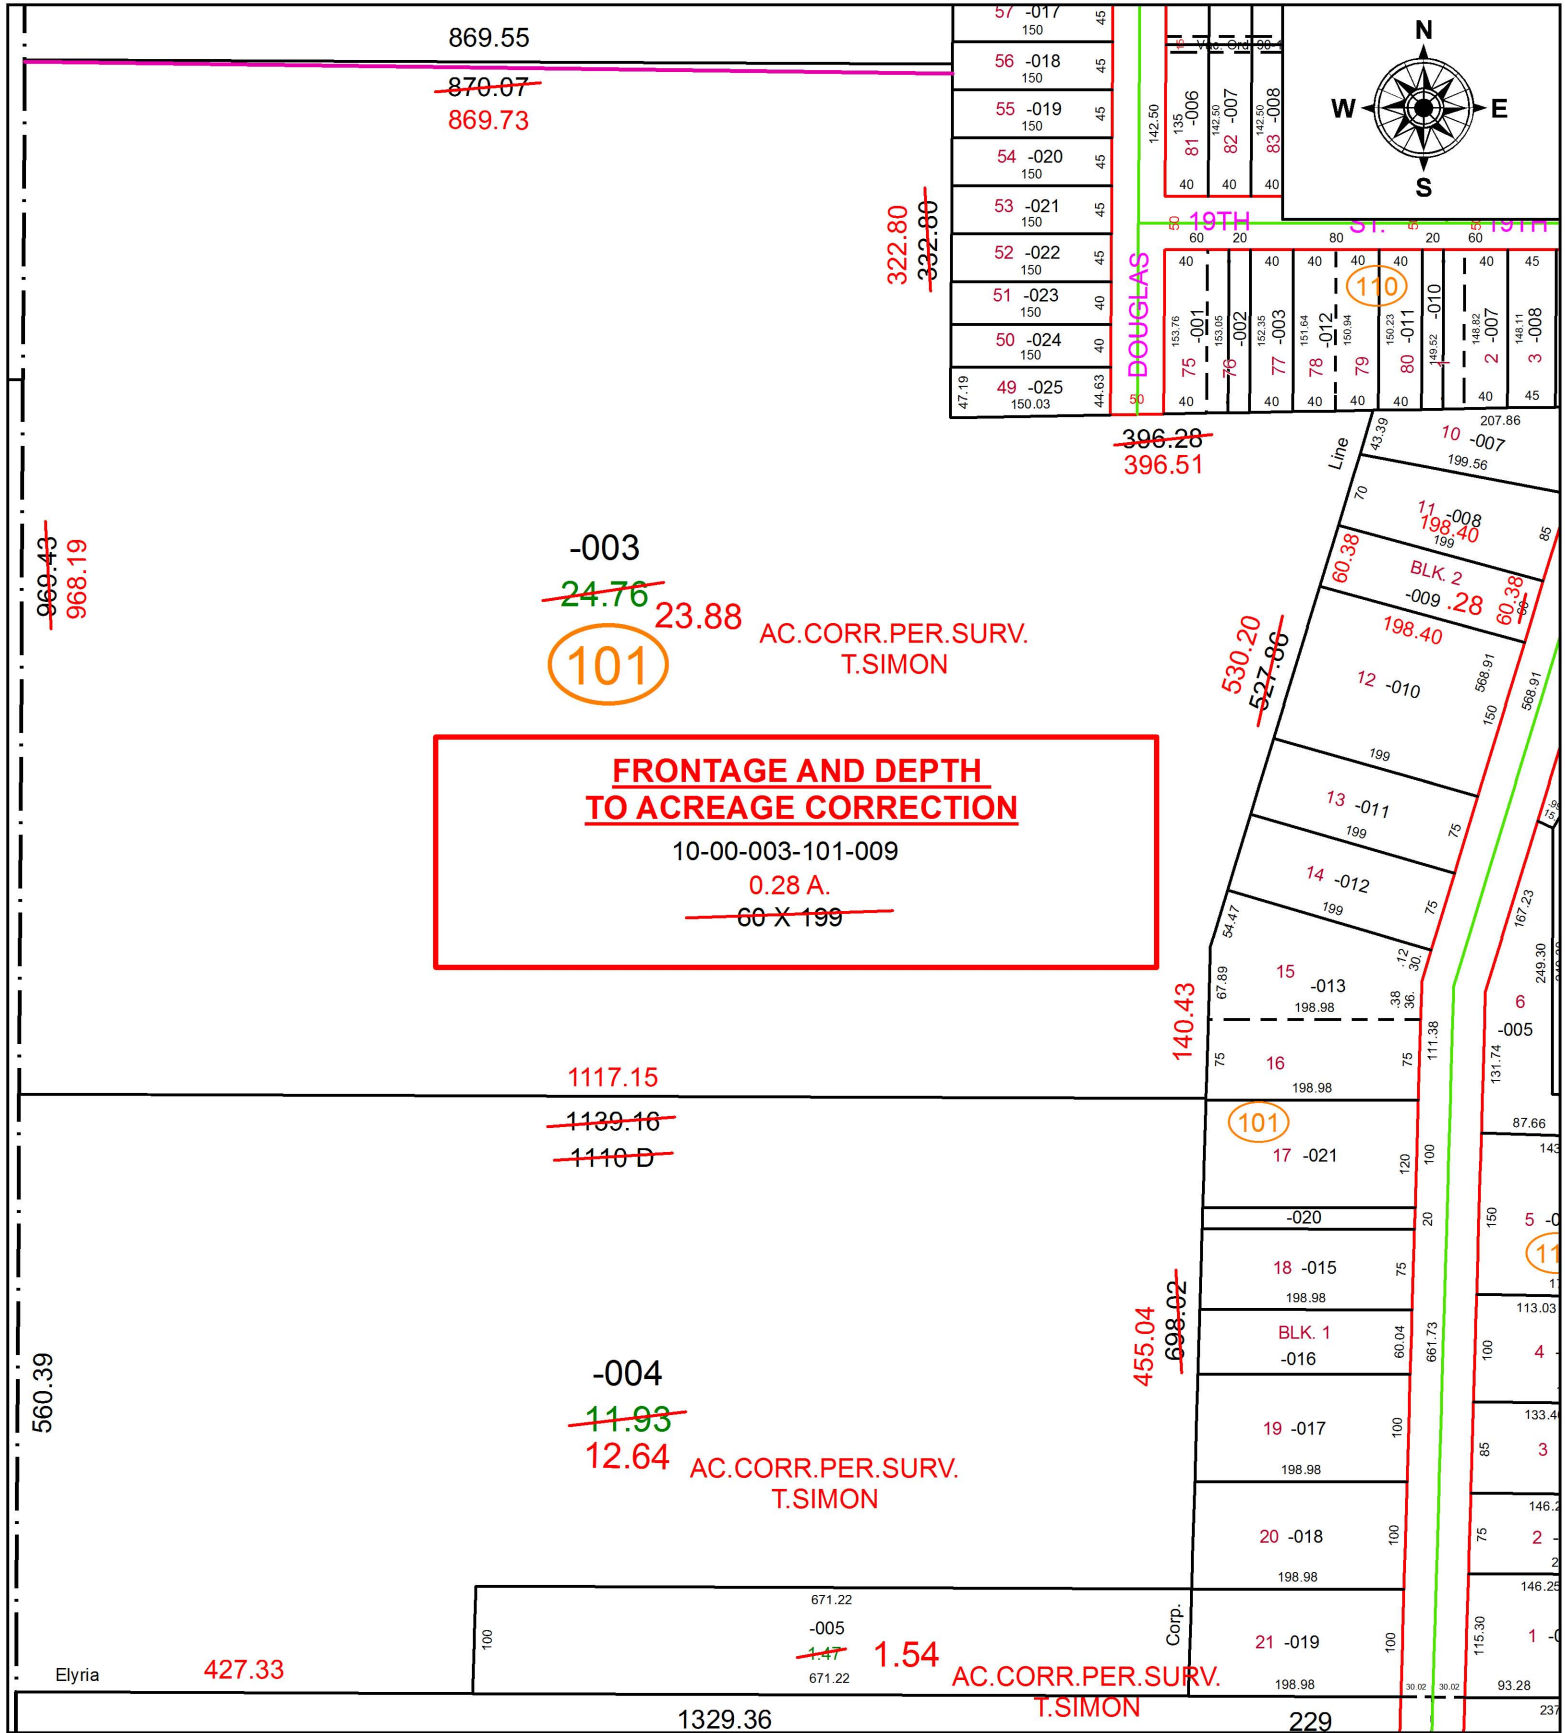


**FRONTAGE AND DEPTH
TO ACREAGE CORRECTION**

10-00-003-101-009
0.28 A.
~~60 X 199~~

-003
~~24.76~~ 23.88 AC. CORR. PER. SURV.
101 T. SIMON

-004
~~11.93~~ 12.64 AC. CORR. PER. SURV.
T. SIMON

-005
~~1.47~~ 1.54 AC. CORR. PER. SURV.
T. SIMON

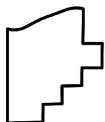

SPLITS/DEEDS PROCESSED
LORAIN COUNTY TAX MAP DEPARTMENT
226 MIDDLE AVE. ELYRIA, OH

SURVEYED BY: THOMAS A. SIMON
CLOSURE: 1: 532,482
MAP PAGE(S): 10-00-003
APPROVED BY: RRM DATE: 2-14-17
SCALE: 1" = 180 PRIOR INSTRUMENT: 20160613446