


PARENT PARCEL: 05-00-064-000-079



CHILD PARCEL: 05-00-064-000-081, -082

STARTING POINT: SOUTHEAST CORNER OF O.L.64

16-03611

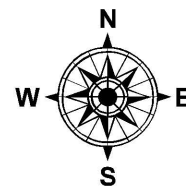

922.73

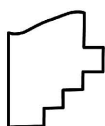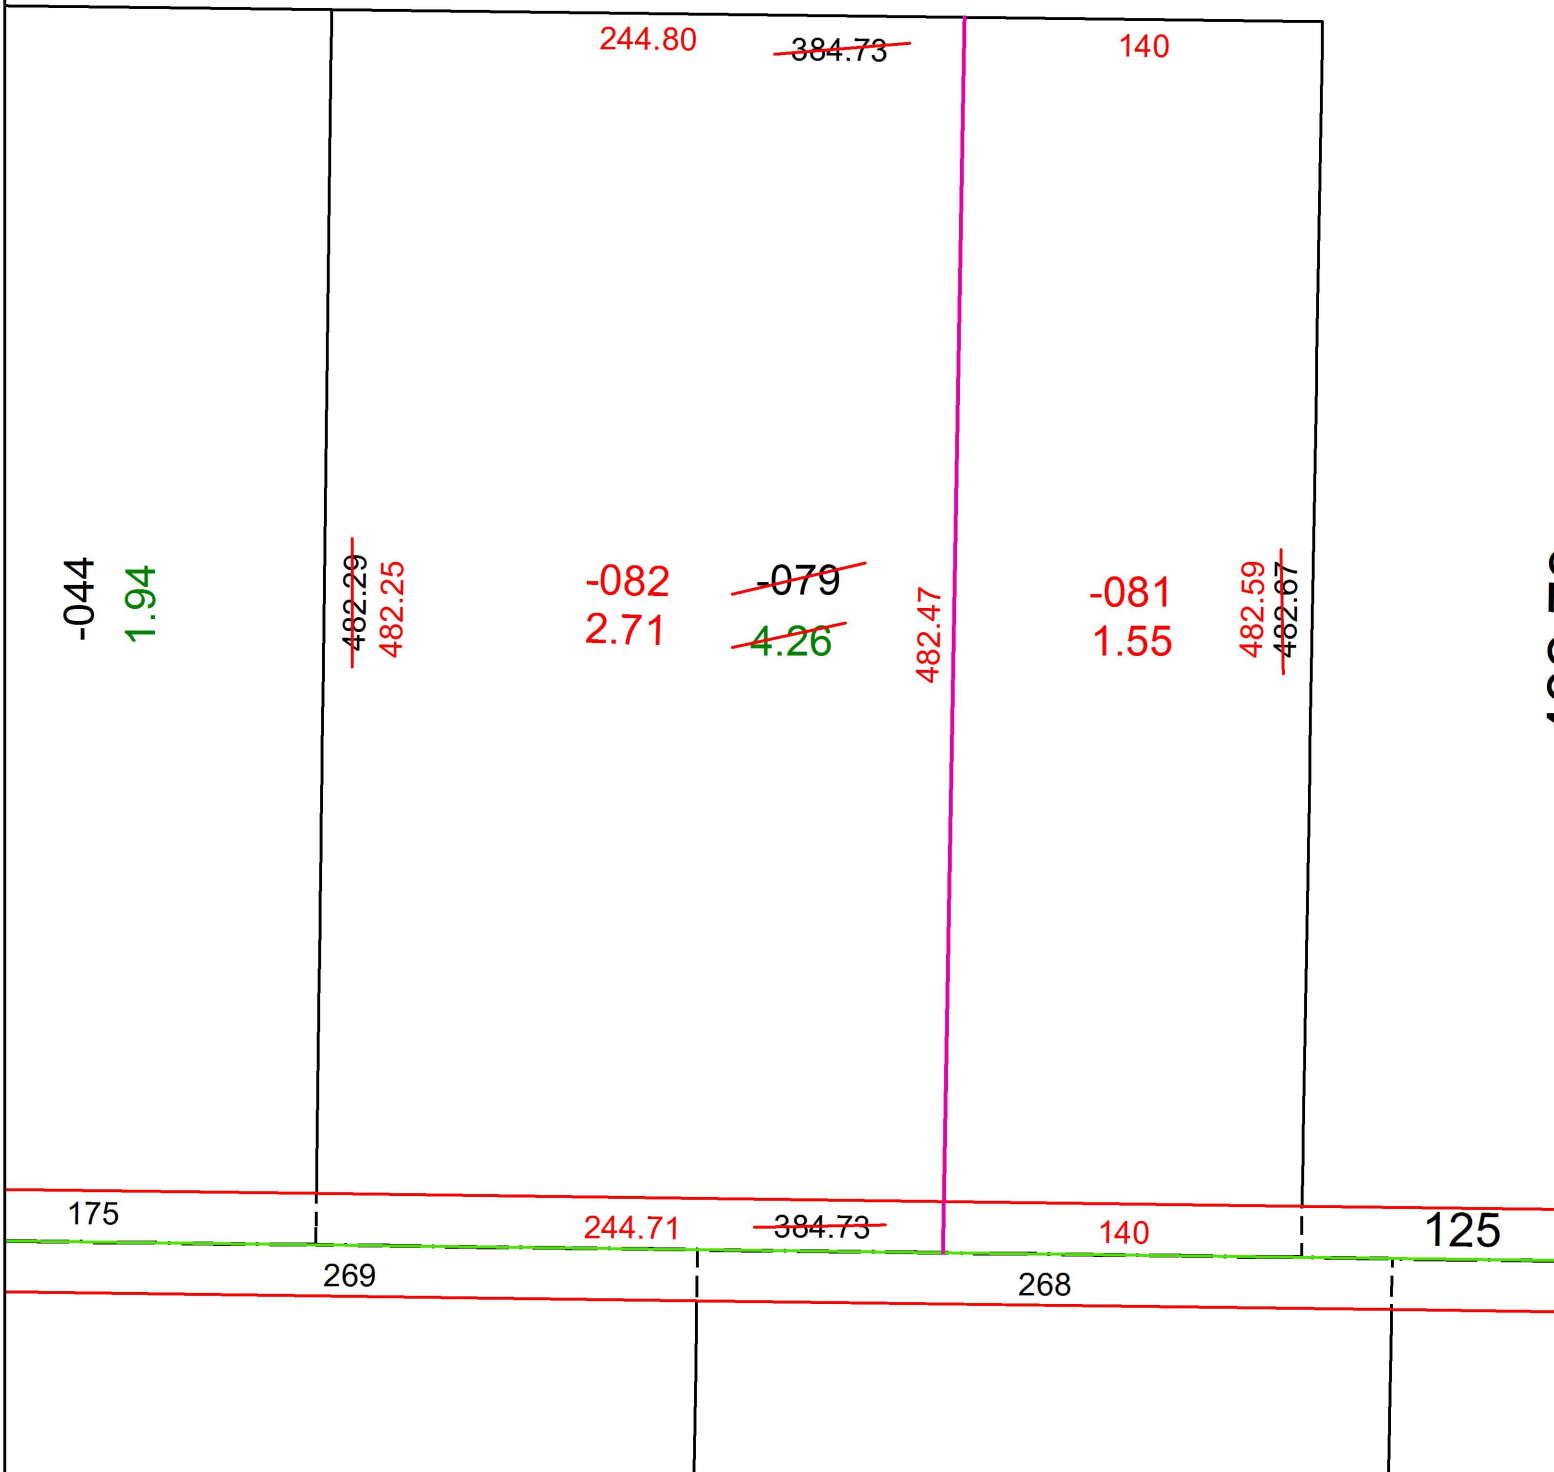

**SPLITS/DEEDS PROCESSED**  
 LORAIN COUNTY TAX MAP DEPARTMENT  
 226 MIDDLE AVE. ELYRIA, OH

SURVEYED BY: TIMOTHY D. HOZALSKI

CLOSURE: 1: 222,533

MAP PAGE(S): 5-00-064

APPROVED BY: RRM DATE: 12-7-16

SCALE: 1" = 75 PRIOR INSTRUMENT: 20090320771