


PARENT PARCEL: 09-00-041-000-001, -006

CHILD PARCEL: 09-00-041-000-007

STARTING POINT: INTERSECTION OF C/L OF GARFIELD RD. AND C/L OF QUARRY RD.

17-03612-C

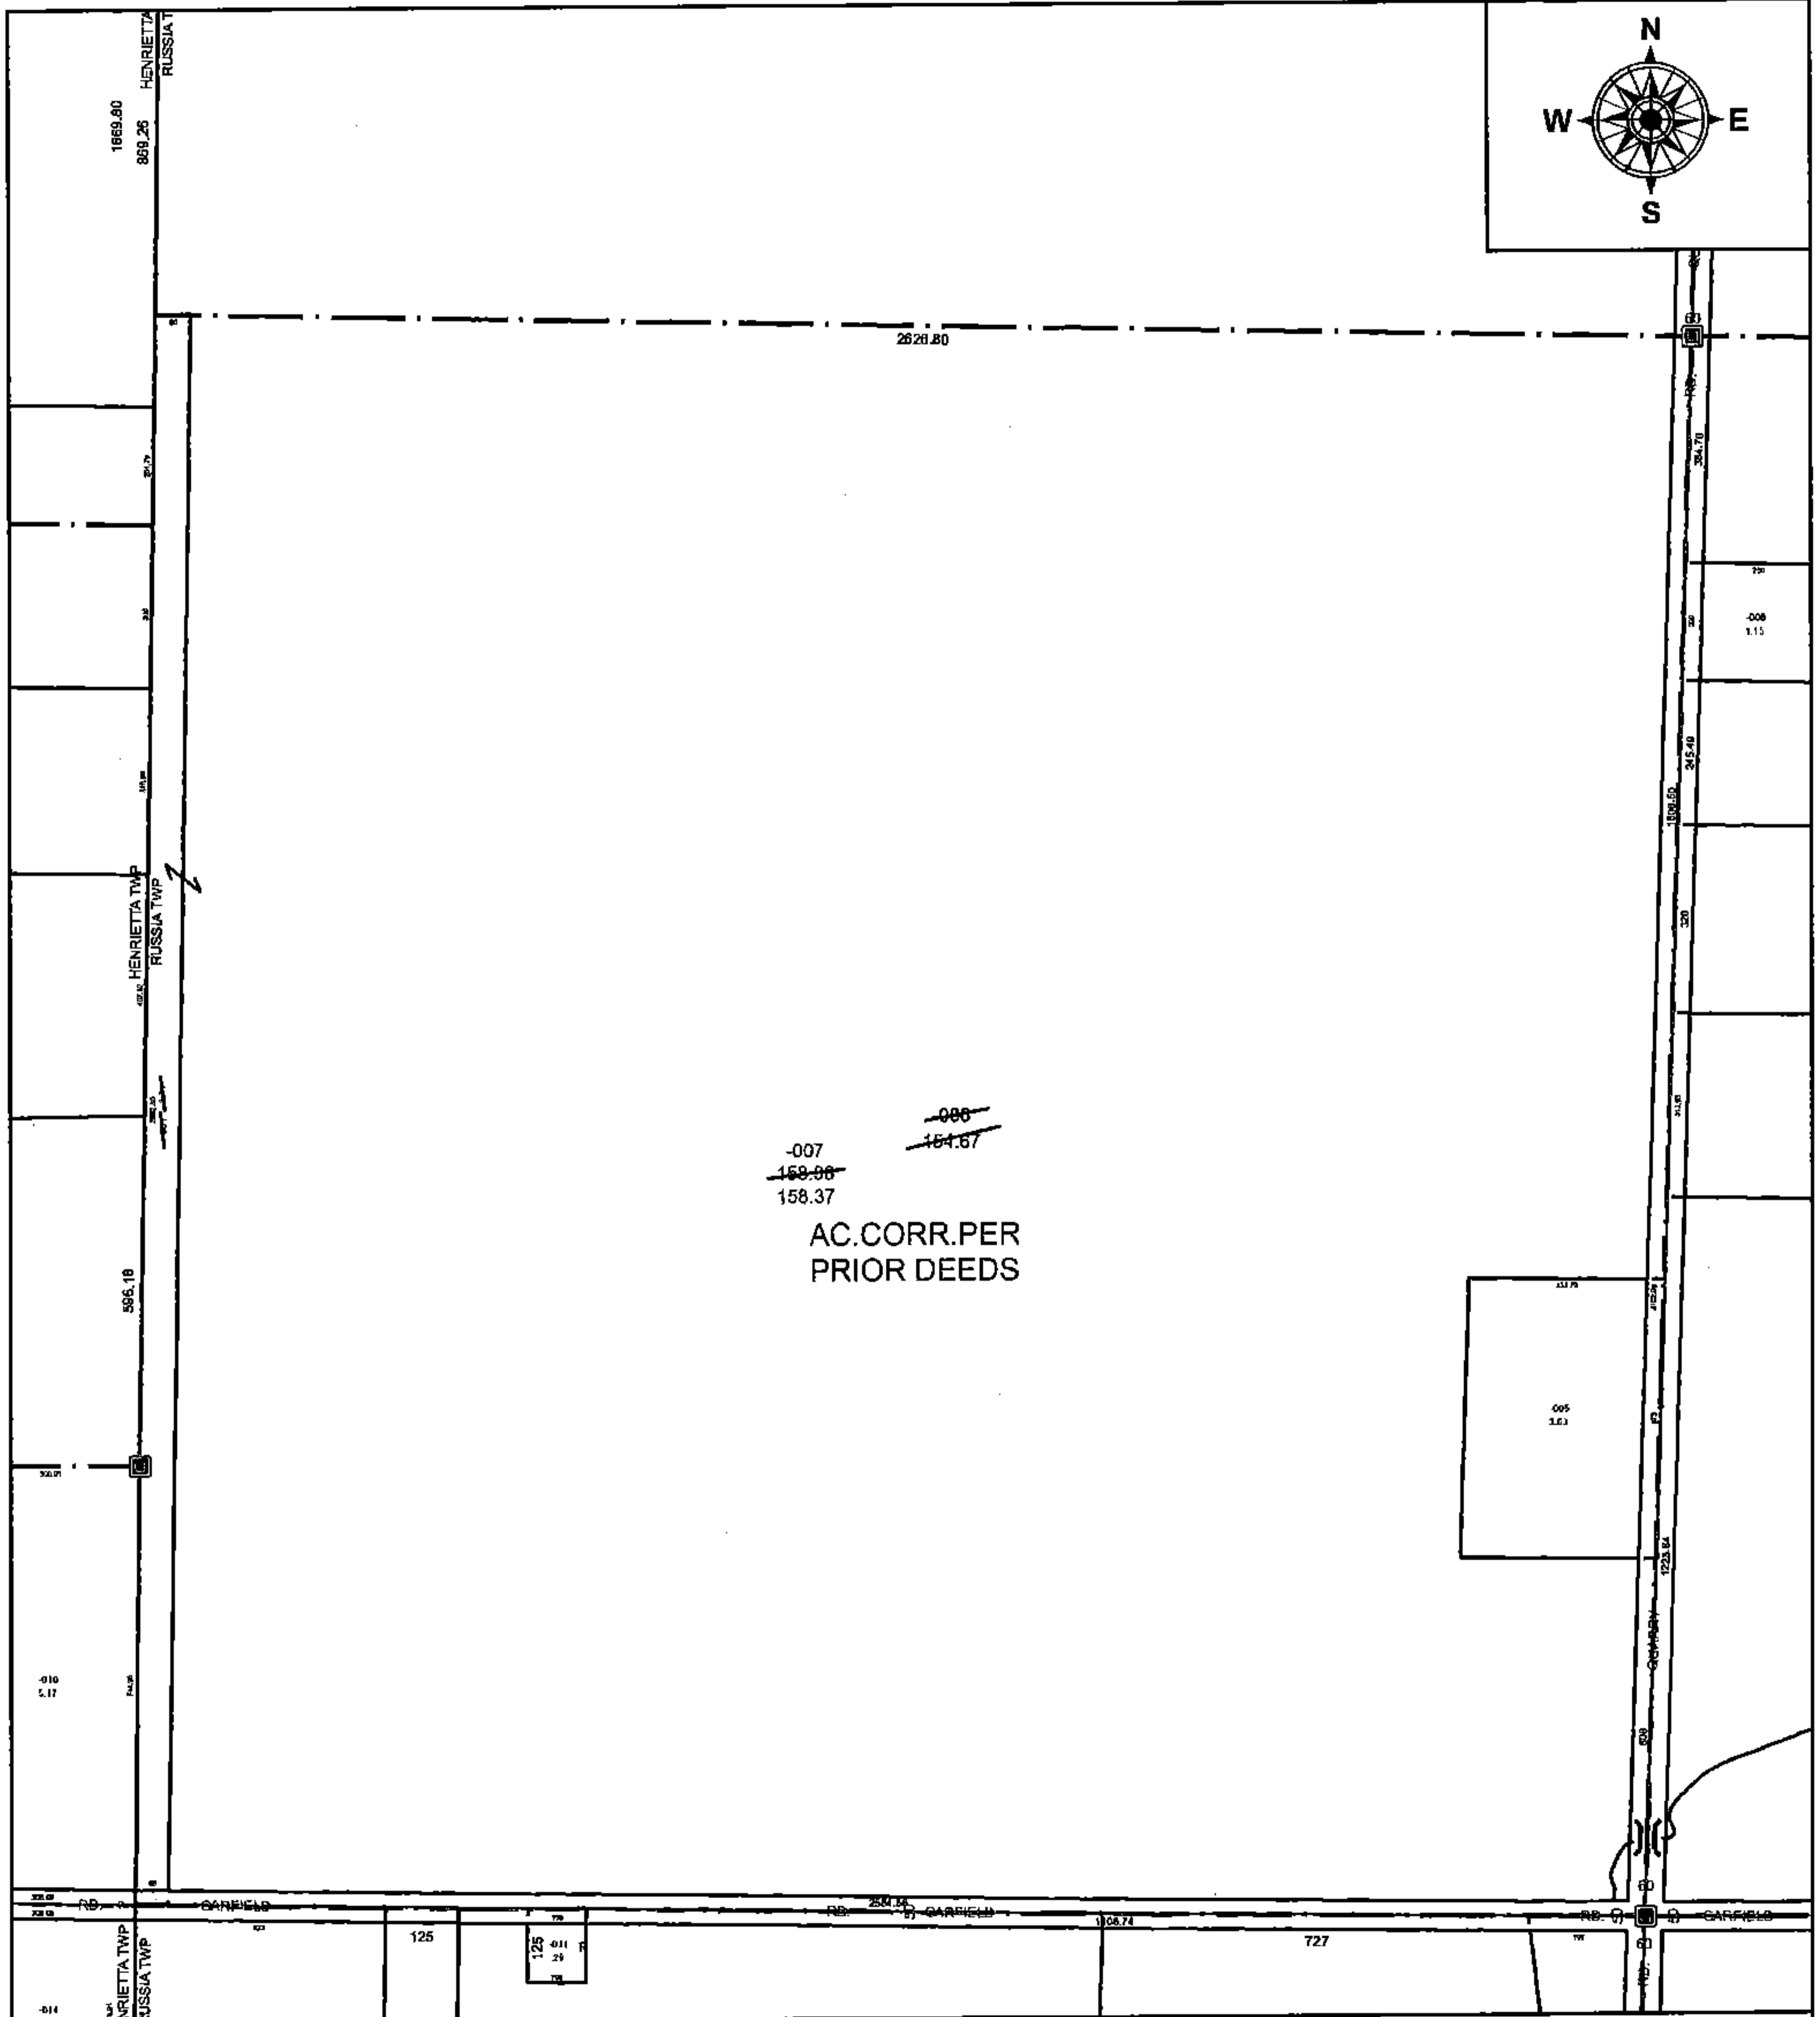

SPLITS/DEEDS PROCESSED
 LORAIN COUNTY TAX MAP DEPARTMENT
 226 MIDDLE AVE. ELYRIA, OH

SURVEYED BY: N/A
 CLOSURE: N/A
 MAP PAGE(S): 9-00-041
 APPROVED BY: RRM DATE: 2-21-17
 SCALE: 1" = 380 PRIOR INSTRUMENT: 20170619358