


PARENT PARCEL: 05-00-096-500-001

CHILD PARCEL: 05-00-096-000-020

STARTING POINT: RE-NUMBER FOR PRIVATE OWNERSHIP - NO LONGER A RAILROAD

17-03613-R

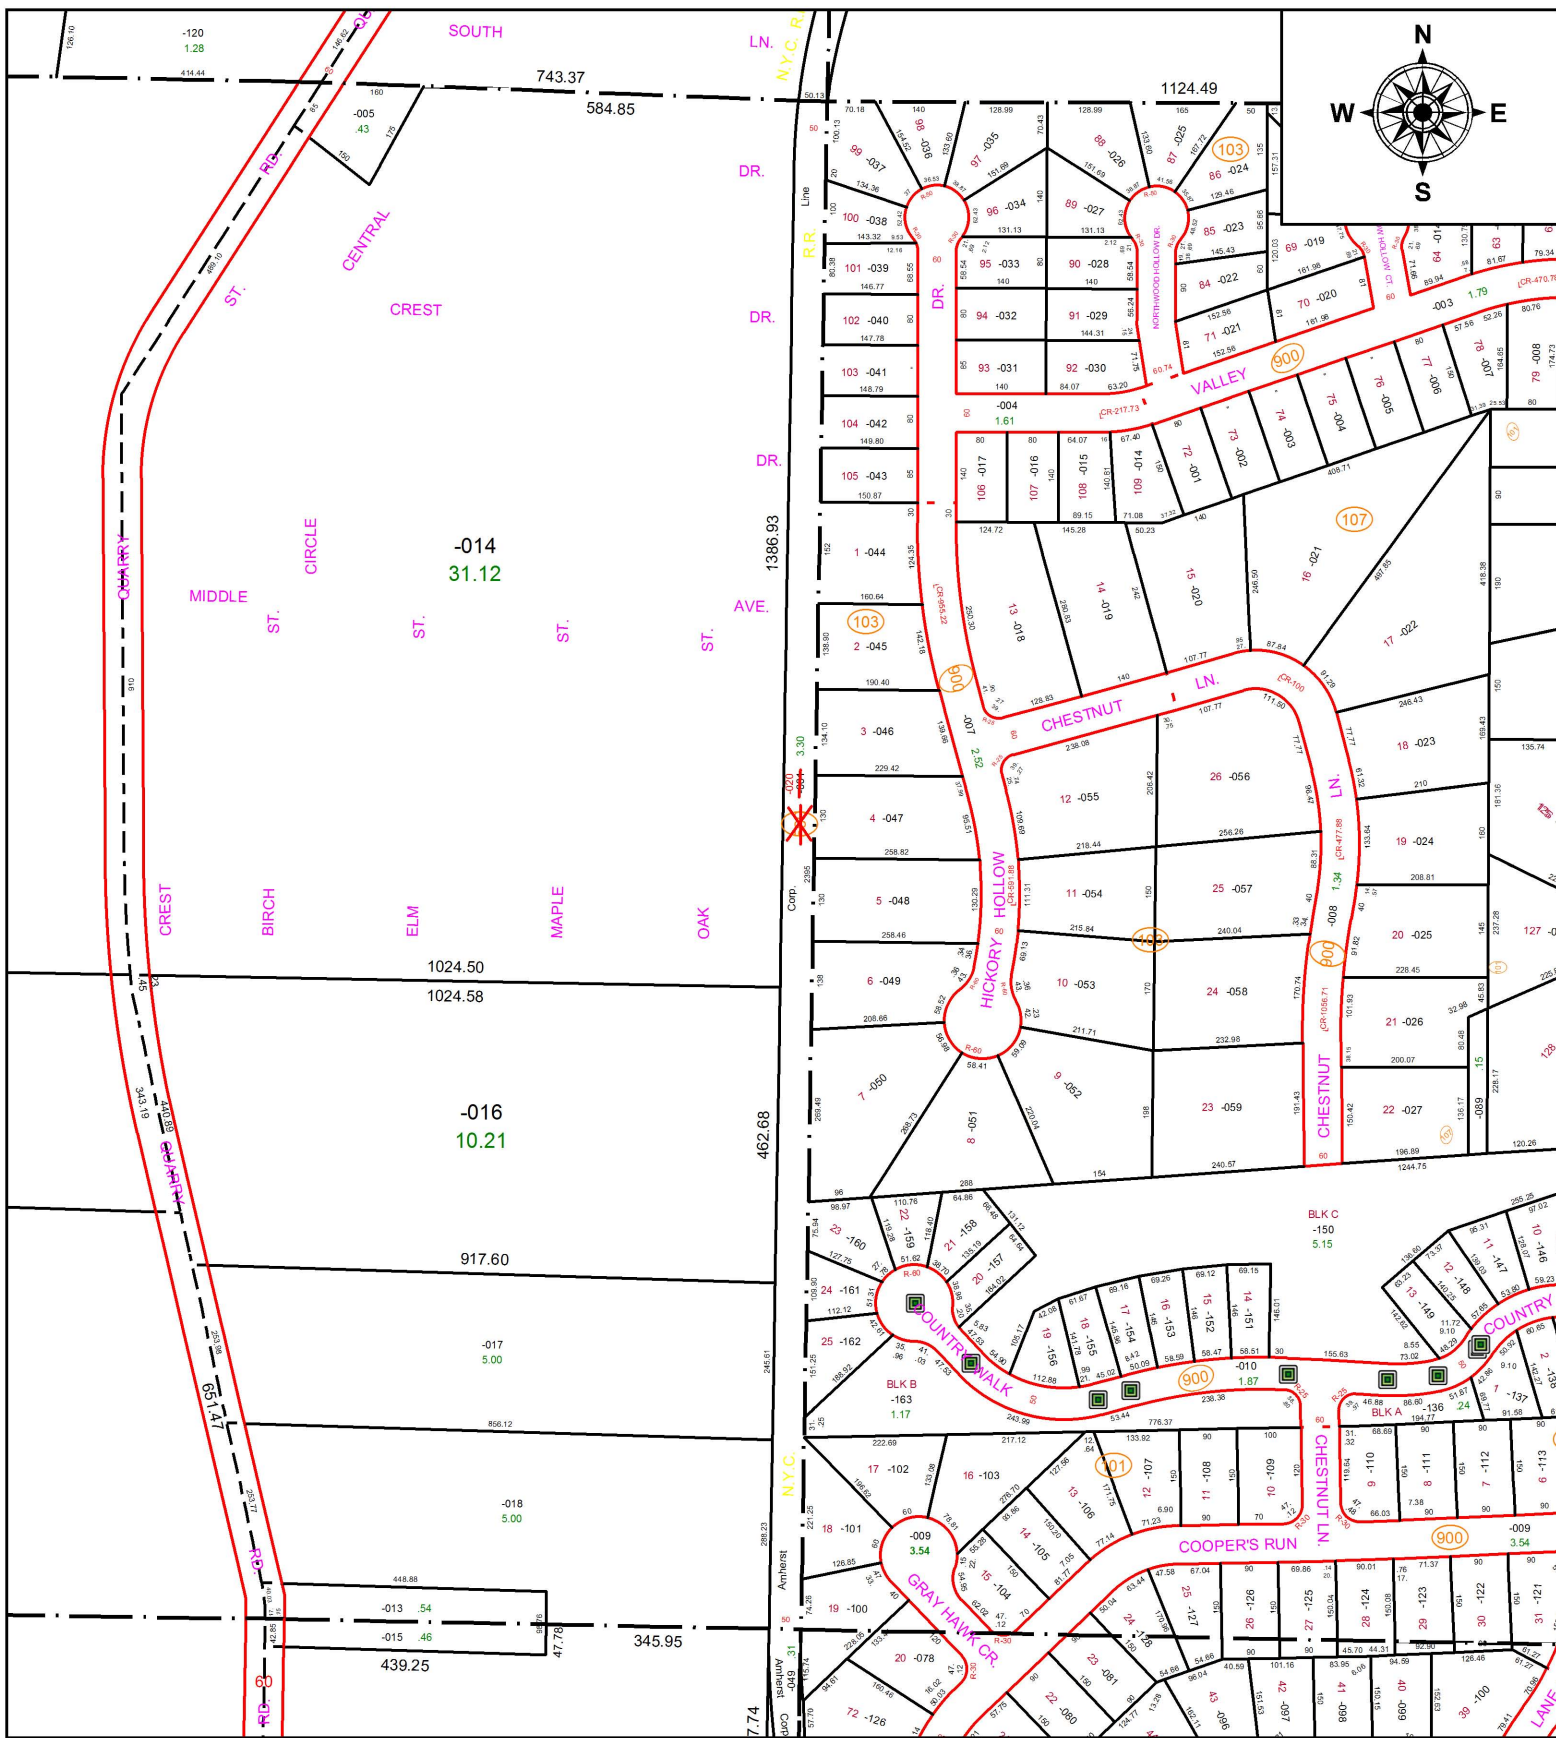

SPLITS/DEEDS PROCESSED
 LORAIN COUNTY TAX MAP DEPARTMENT
 226 MIDDLE AVE. ELYRIA, OH

SURVEYED BY: NA
 CLOSURE: 1: 33,000
 MAP PAGE(S): 05-00-096
 APPROVED BY: TJS DATE: 2/22/17
 SCALE: 1" = 300 PRIOR INSTRUMENT: 2002-0850200