


PARENT PARCEL: 10-00-007-109-030

CHILD PARCEL: XX-XX-XXX-XXX-XXX

STARTING POINT: NORTHEAST CORNER OF LAND CONVEYED TO FAHRNEY(DV 998/814)

17-03616-A

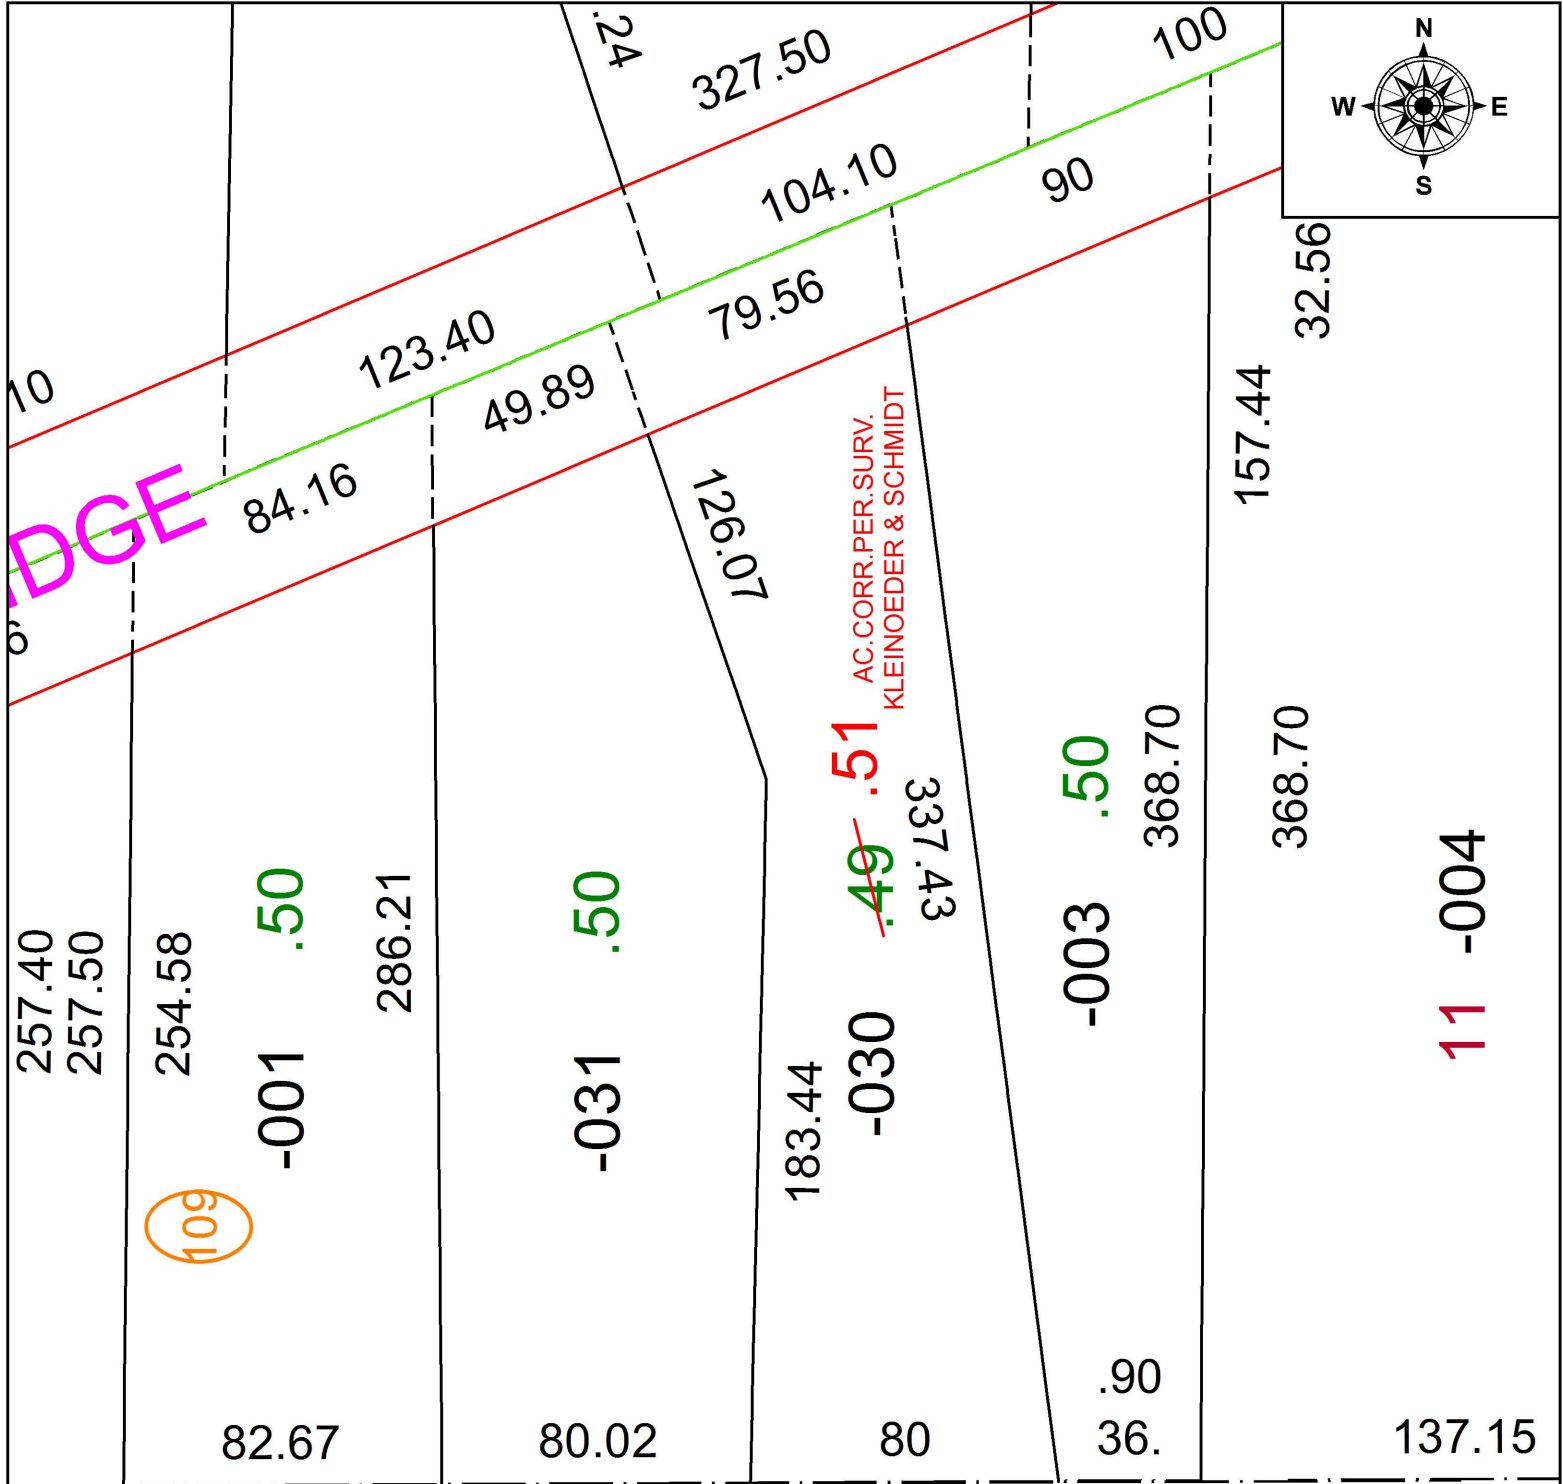

SPLITS/DEEDS PROCESSED
 LORAIN COUNTY TAX MAP DEPARTMENT
 226 MIDDLE AVE. ELYRIA, OH

SURVEYED BY: KLEINOEDER & SCHMIDT

CLOSURE: 1: 568,829

MAP PAGE(S): 10-00-007

APPROVED BY: RRM DATE: 2-24-17

SCALE: 1" = 50 PRIOR INSTRUMENT: 20150551832