
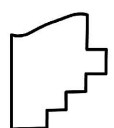
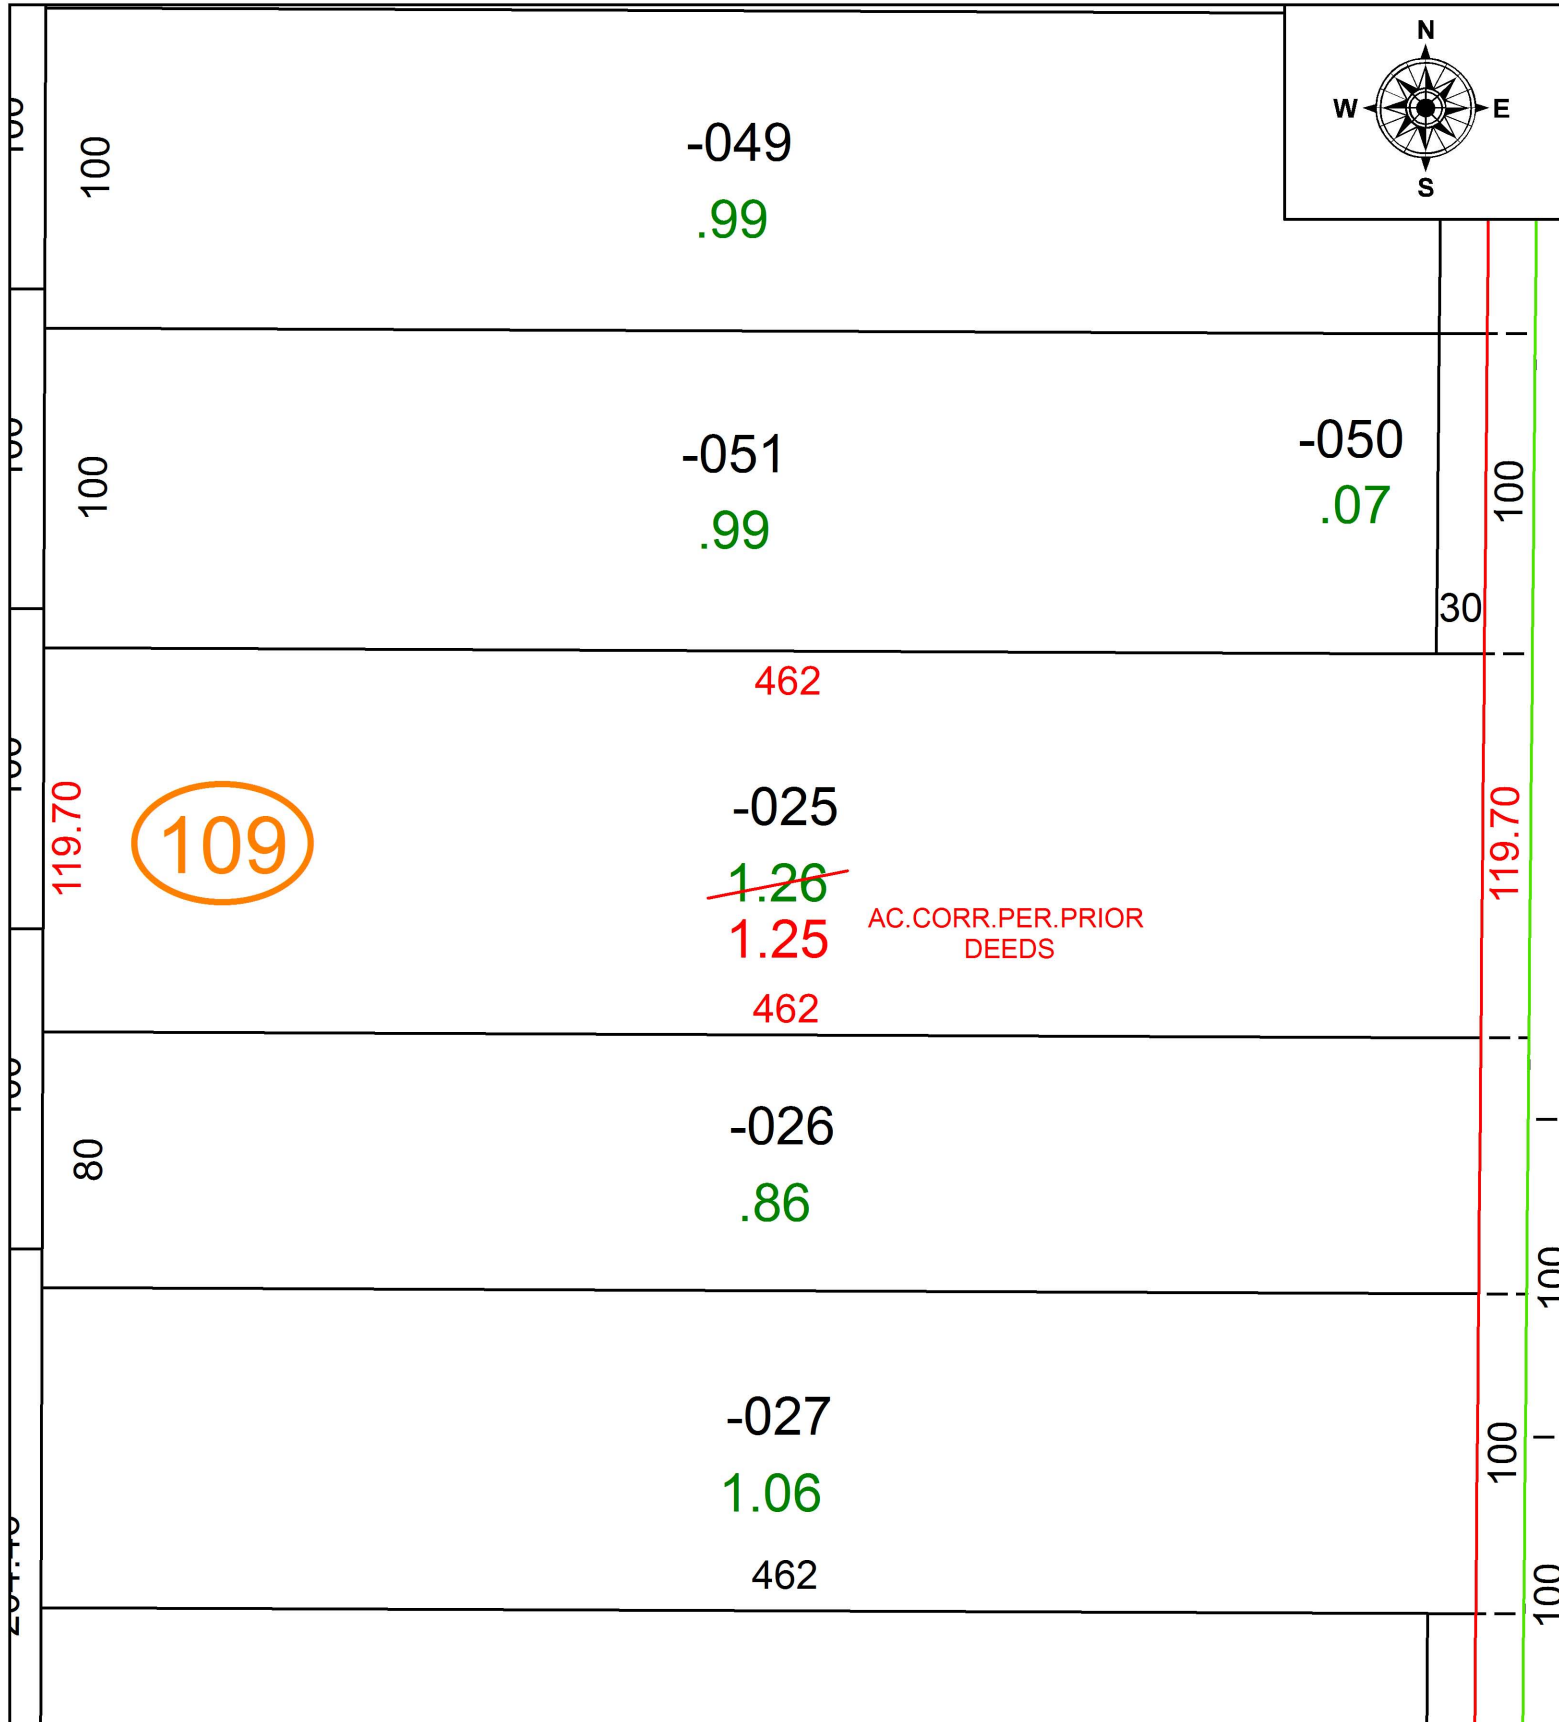


PARENT PARCEL: 04-00-026-109-025

CHILD PARCEL: XX-XX-XXX-XXX-XXX

STARTING POINT: INTERSECTION OF C/L OF WILLIAMS CT. AND C/L OF SCHWARTZ RD.

17-03617-A

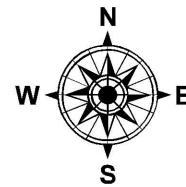

SPLITS/DEEDS PROCESSED
 LORAIN COUNTY TAX MAP DEPARTMENT
 226 MIDDLE AVE. ELYRIA, OH

SURVEYED BY: _____ N/A
 CLOSURE: 1: 2147483648
 MAP PAGE(S): 4-00-026
 APPROVED BY: RRM DATE: 2-24-17
 SCALE: 1" = 60' PRIOR INSTRUMENT: 20160603662