
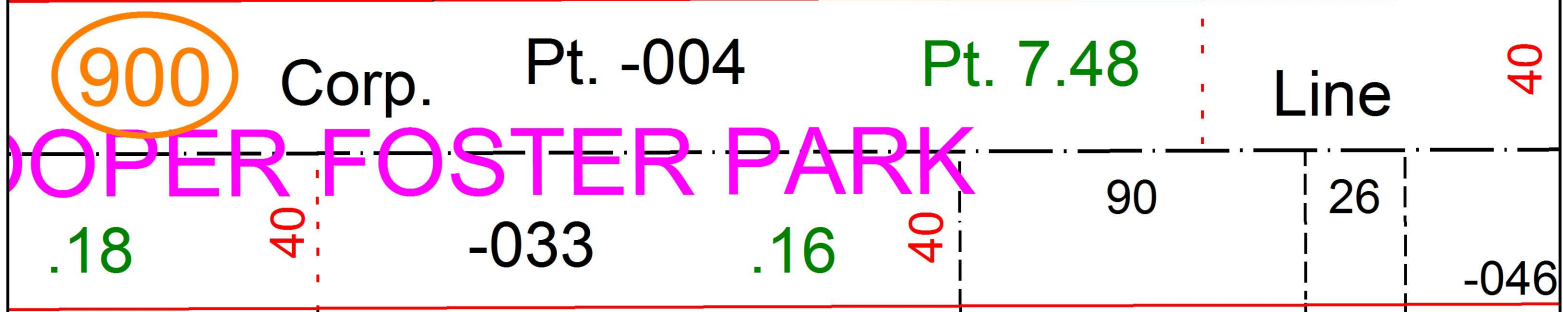



PARENT PARCEL: 02-02-005-114-048 & -052

CHILD PARCEL: 02-02-005-114-066 THRU -068

STARTING POINT: I.P. FD., S.E. CORNER OF BLOCK "C" IN ASHWOOD ACRES SUBDIVISION

16-03618

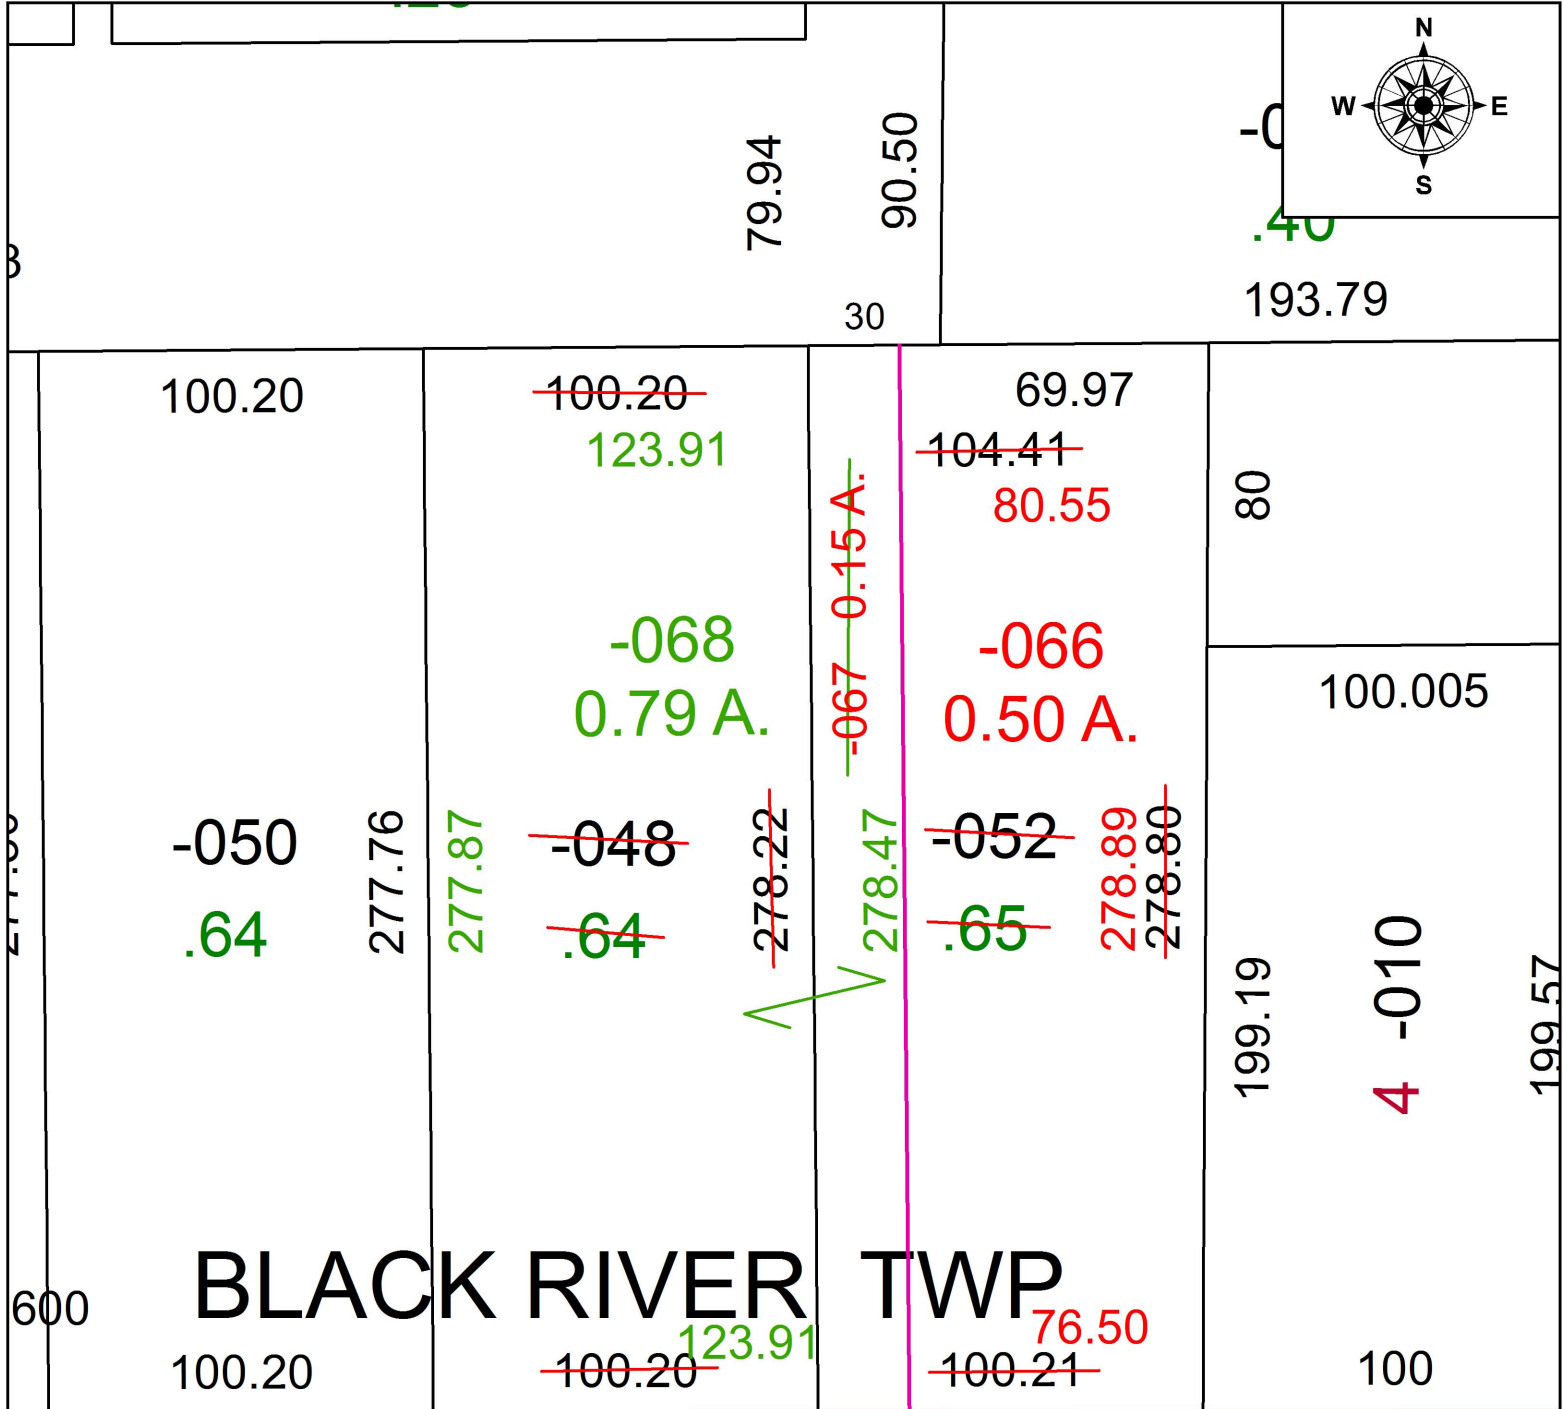

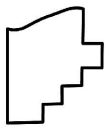 **SPLITS/DEEDS PROCESSED**  
 LORAIN COUNTY TAX MAP DEPARTMENT  
 226 MIDDLE AVE. ELYRIA, OH

SURVEYED BY: RICHARD A. FREDRICKSON  
 CLOSURE: 1: 33,000  
 MAP PAGE(S): 02-02-005  
 APPROVED BY: TJS DATE: 12/21/16  
 SCALE: 1" = 50' PRIOR INSTRUMENT: 2007-0203331 & 2