
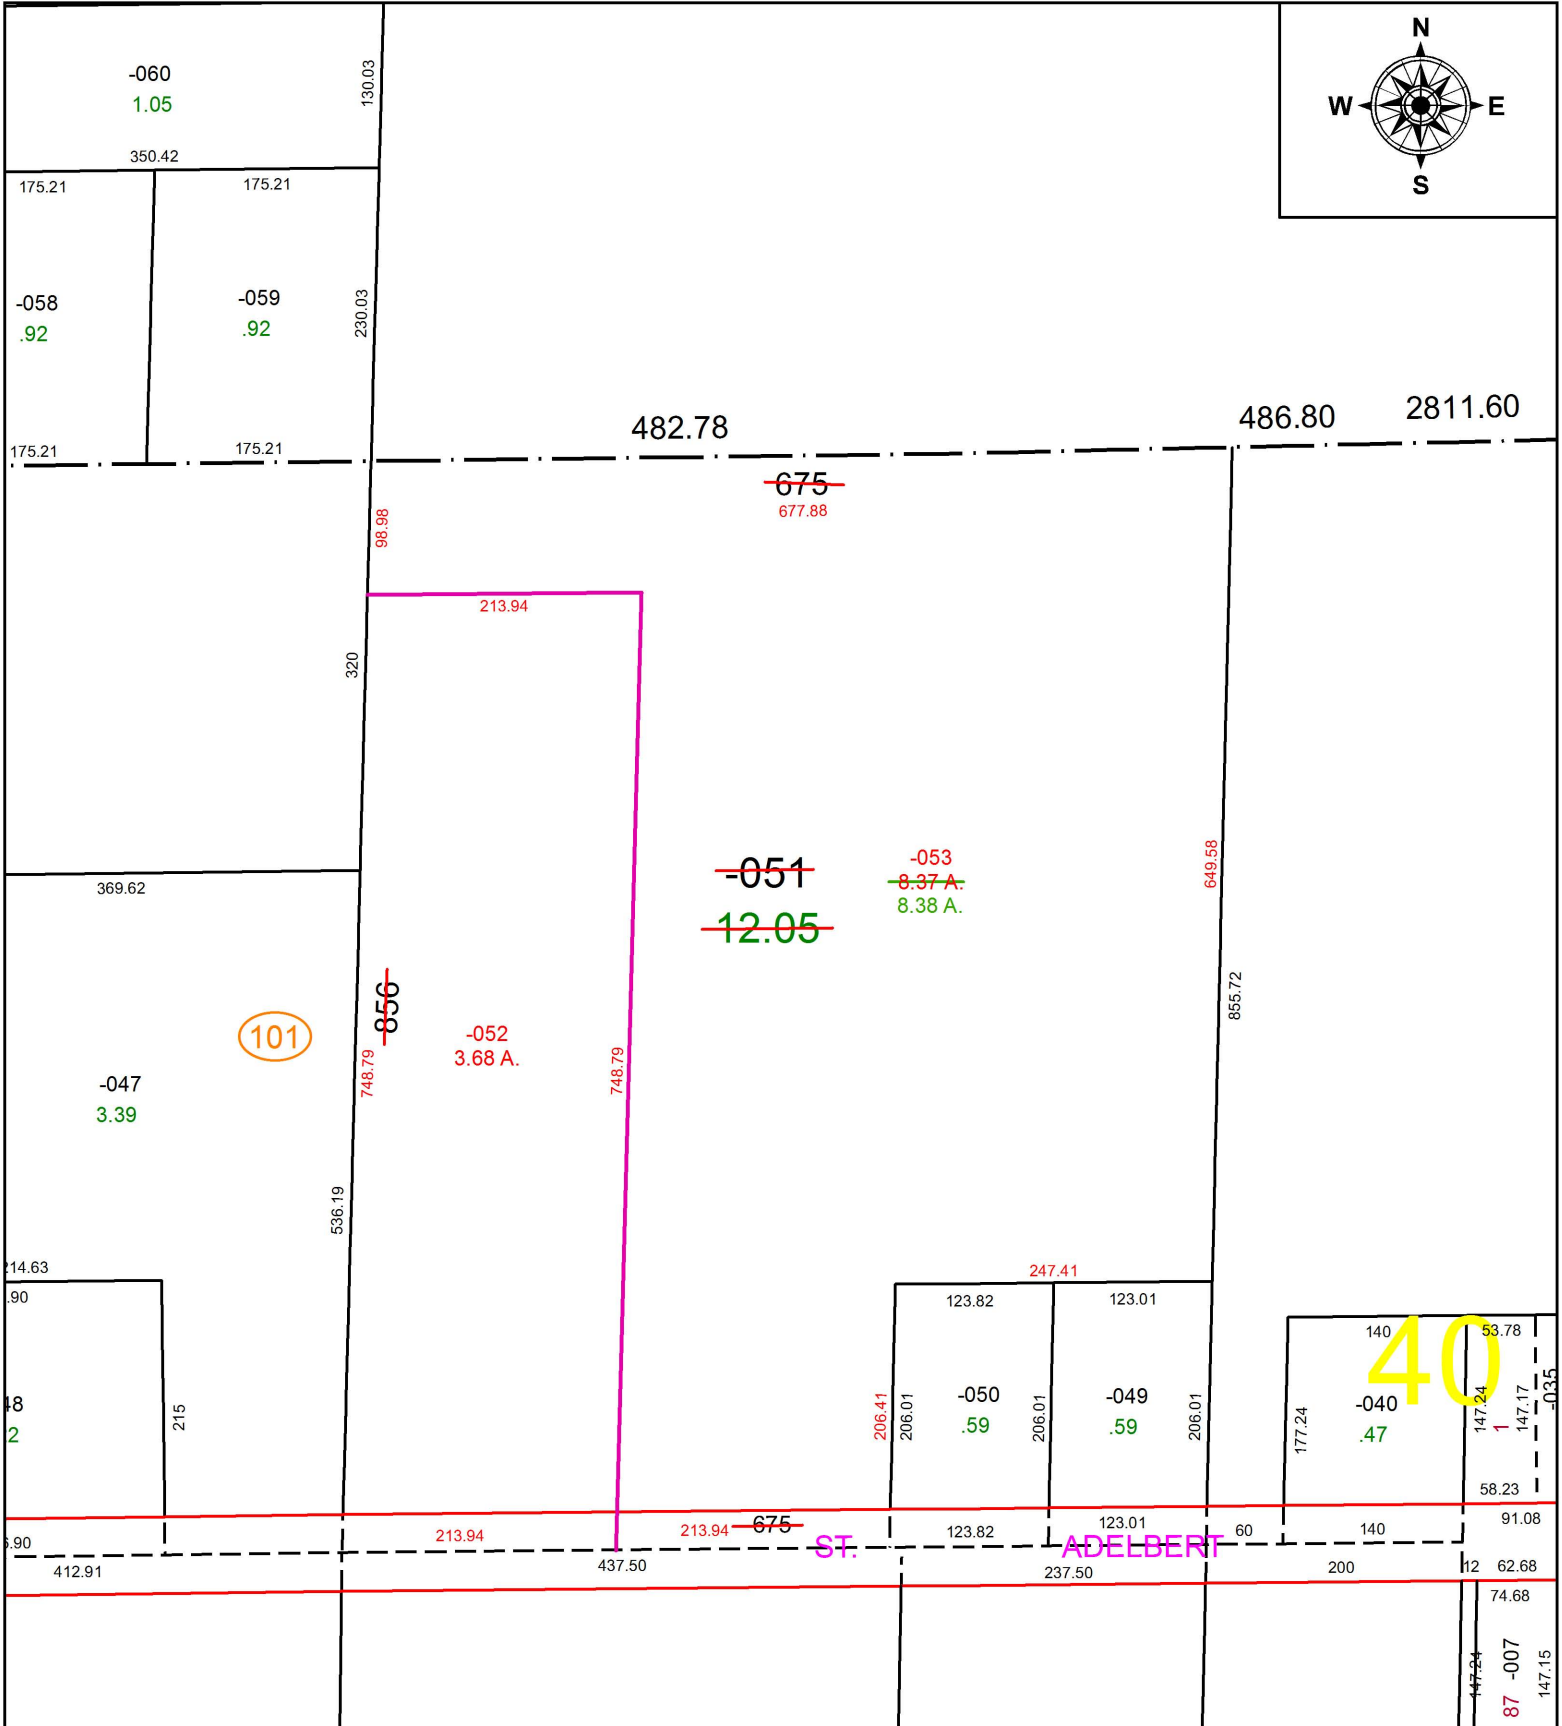


PARENT PARCEL: 06-24-040-101-051

CHILD PARCEL: 06-24-040-101-052 & -053

STARTING POINT: I.P. FOUND, WEST LINE OF ORCHARD GROVE ALLOTMENT & CL OF ADELBERT ST.

16-03622

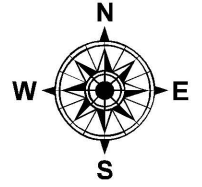

**SPLITS/DEEDS PROCESSED**  
LORAIN COUNTY TAX MAP DEPARTMENT  
226 MIDDLE AVE. ELYRIA, OH

SURVEYED BY: THOMAS SIMON  
CLOSURE: 1: 33,000  
MAP PAGE(S): 06-24-040  
APPROVED BY: TJS DATE: 12/22/16  
SCALE: 1" = 150' PRIOR INSTRUMENT: 2015-0532751