
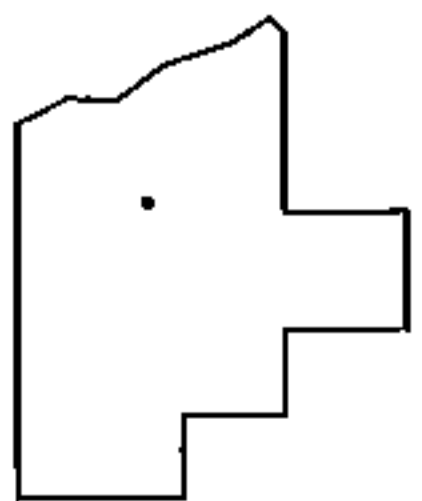
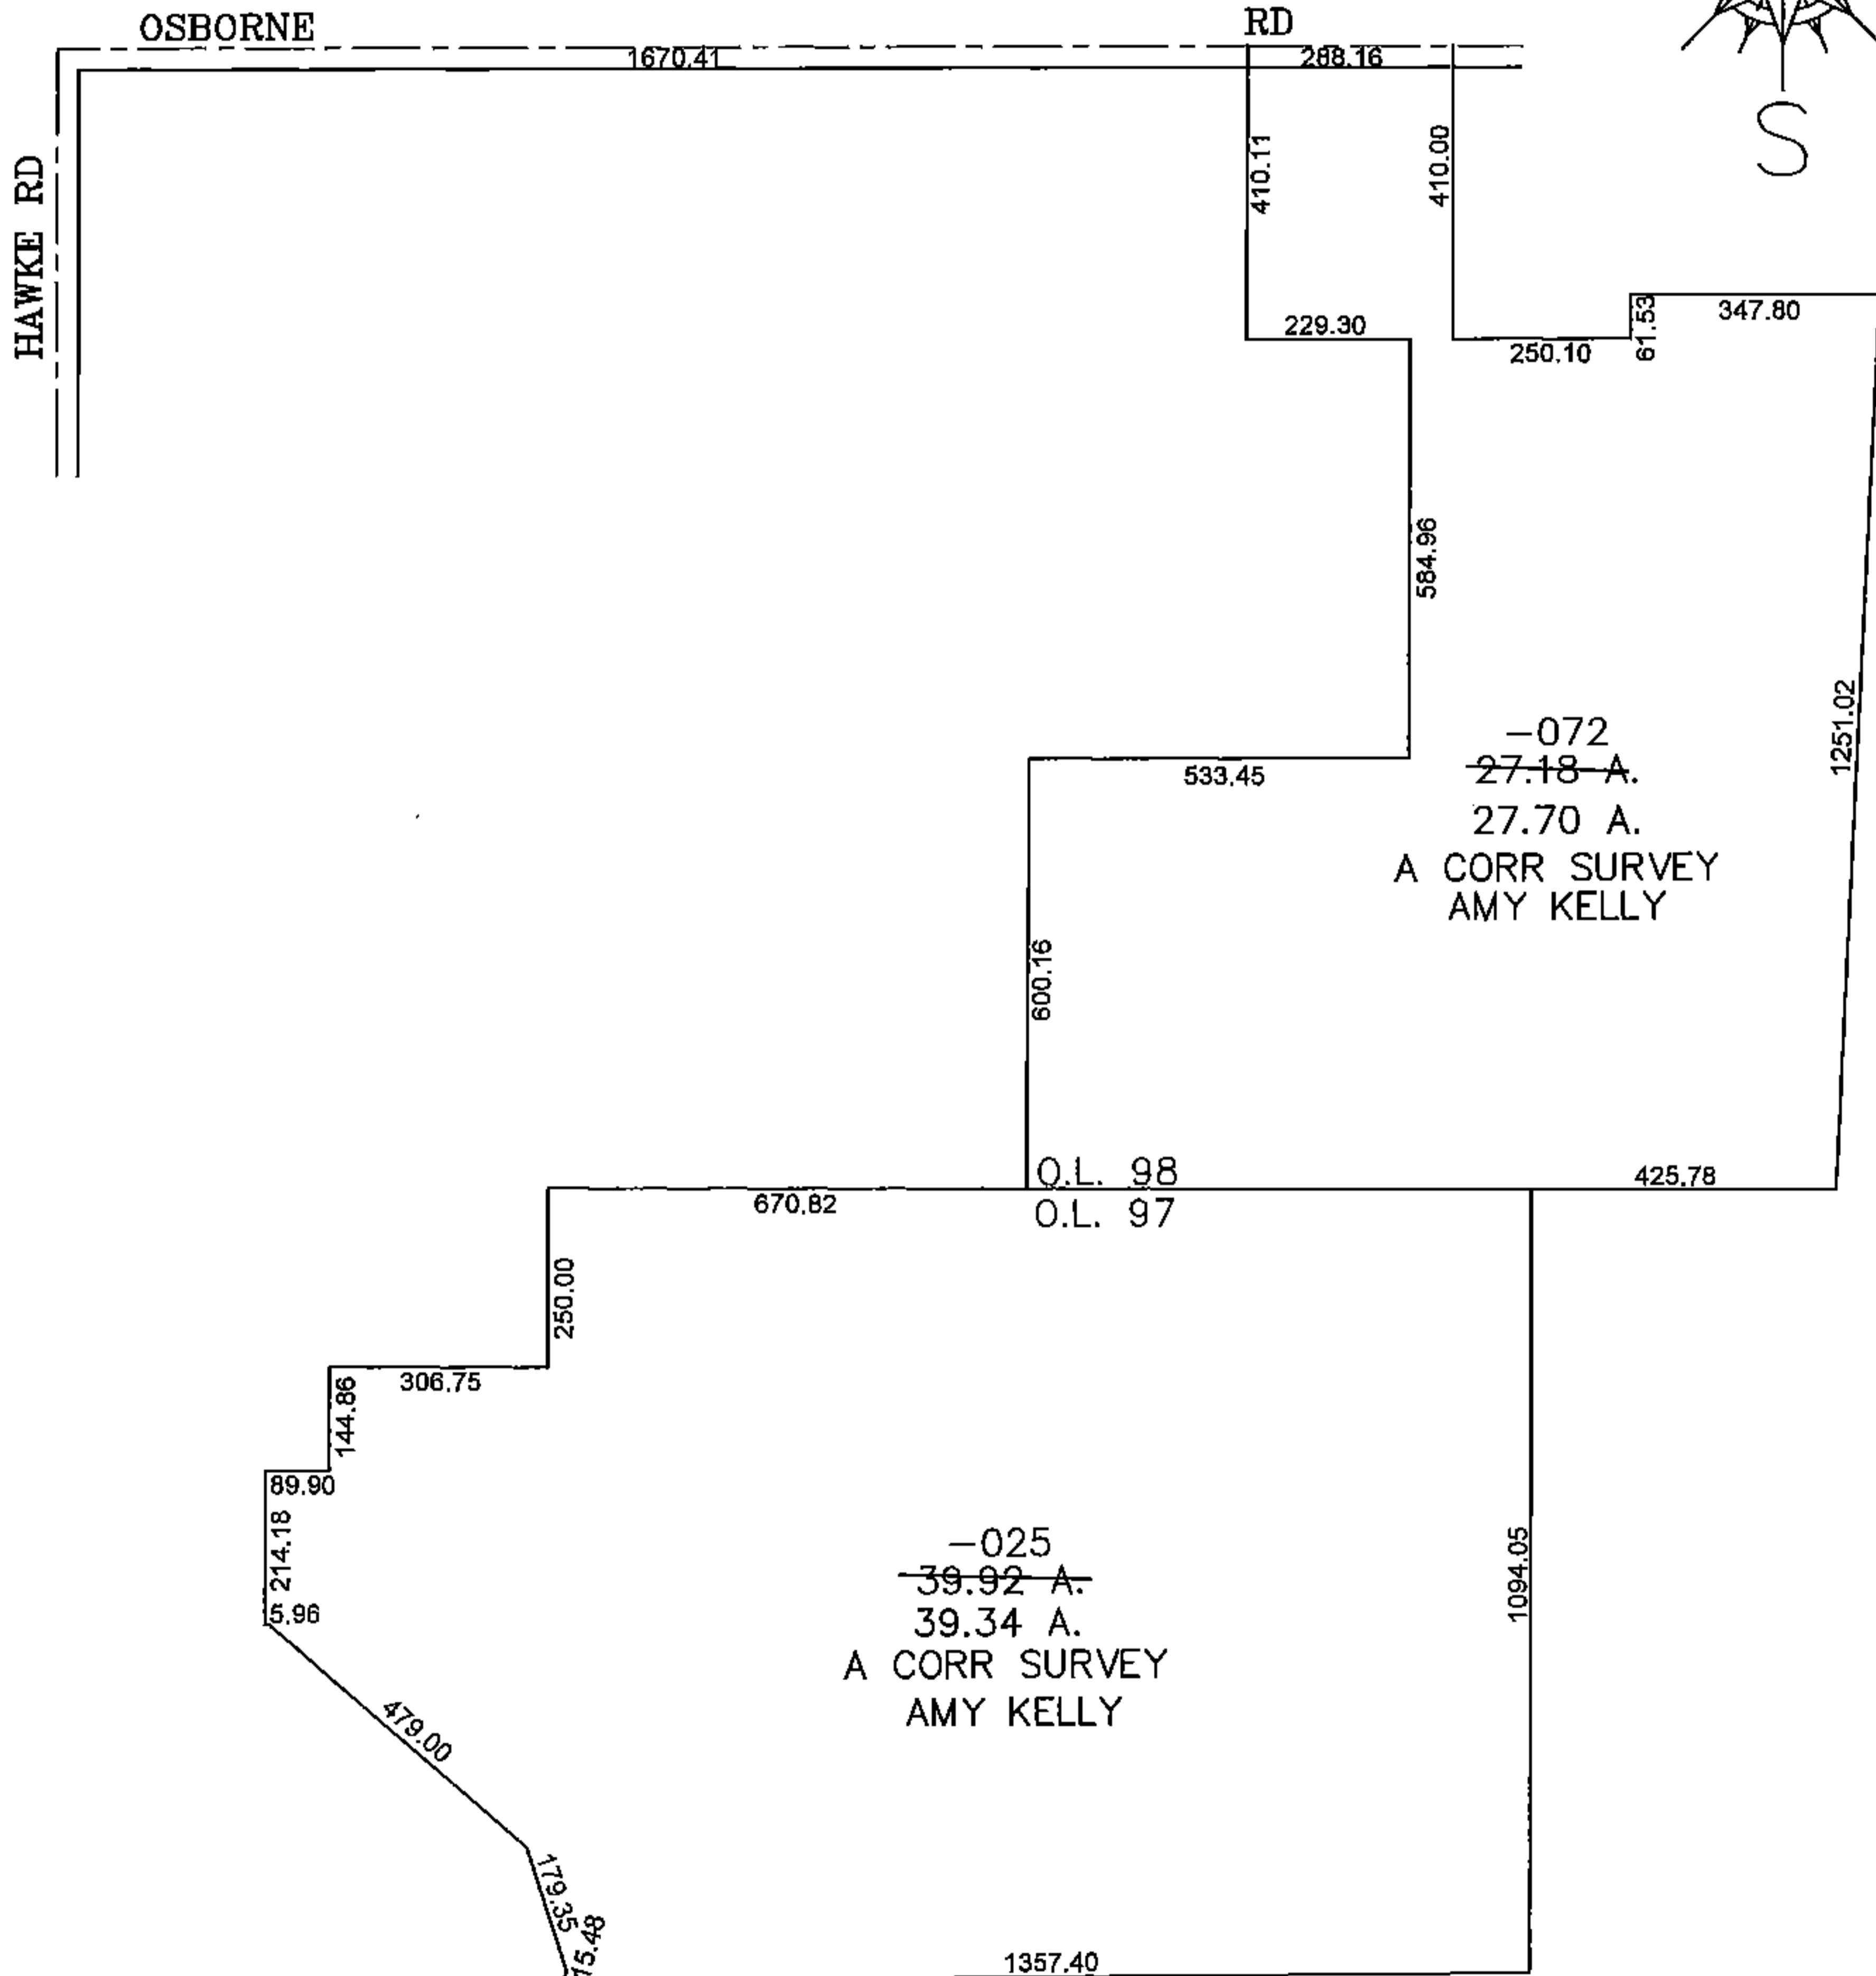


PARENT PARCEL: 12-00-097-000-025, 12-00-098-000-072

CHILD PARCEL: SAME

STARTING POINT: CENTERLINE OF HAWKE RD & OSBORNE RD

16-03623

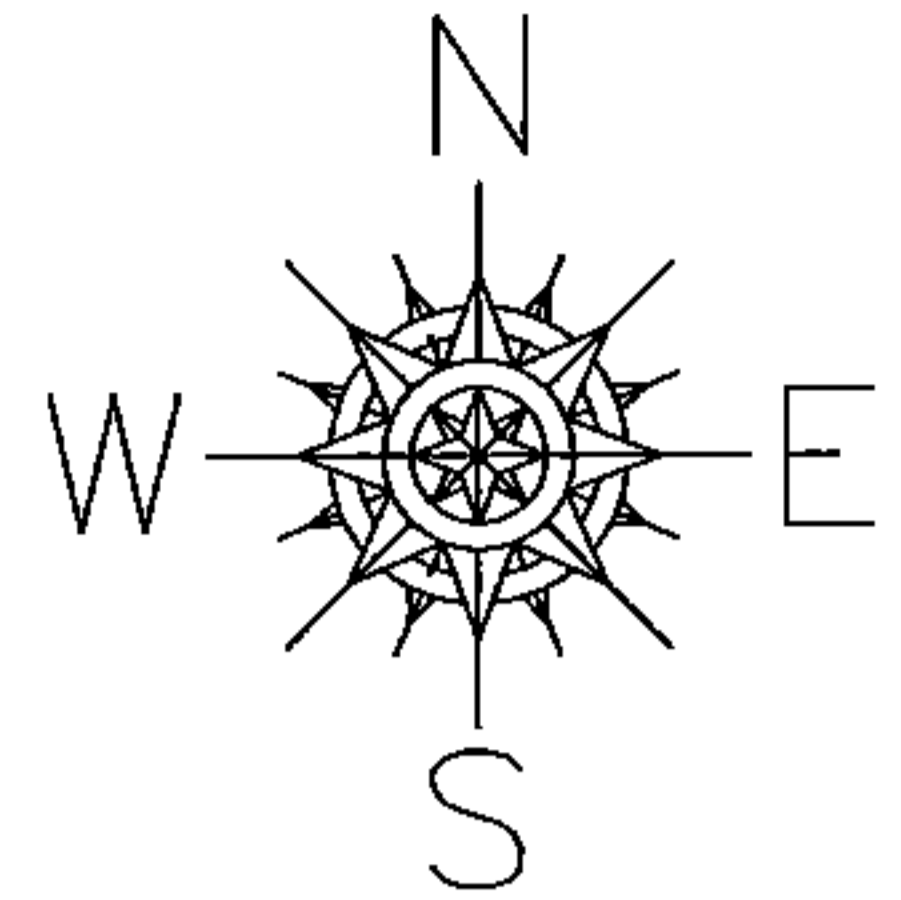

**SPLITS/DEEDS PROCESSED**

LORAIN COUNTY TAX MAP DEPARTMENT  
226 MIDDLE AVE. ELYRIA, OHIO

SURVEYED BY: AMY KELLY

CLOSURE: 0.00 : 10,000

MAP PAGE(S): 12-00-097

APPROVED BY: JAH DATE: 1/4/2017

SCALE: 1" = 400 PRIOR INST.: 20050083019