
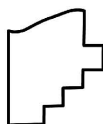


PARENT PARCEL: ADD TO DUPLICATE PER PLAT VOL. 101 PG. 40

CHILD PARCEL: 11-00-090-900-002

STARTING POINT: PLAT VOL. 101 PG. 40 FIELDSTONE LAKES SUB. NO. 2

17-03624-A

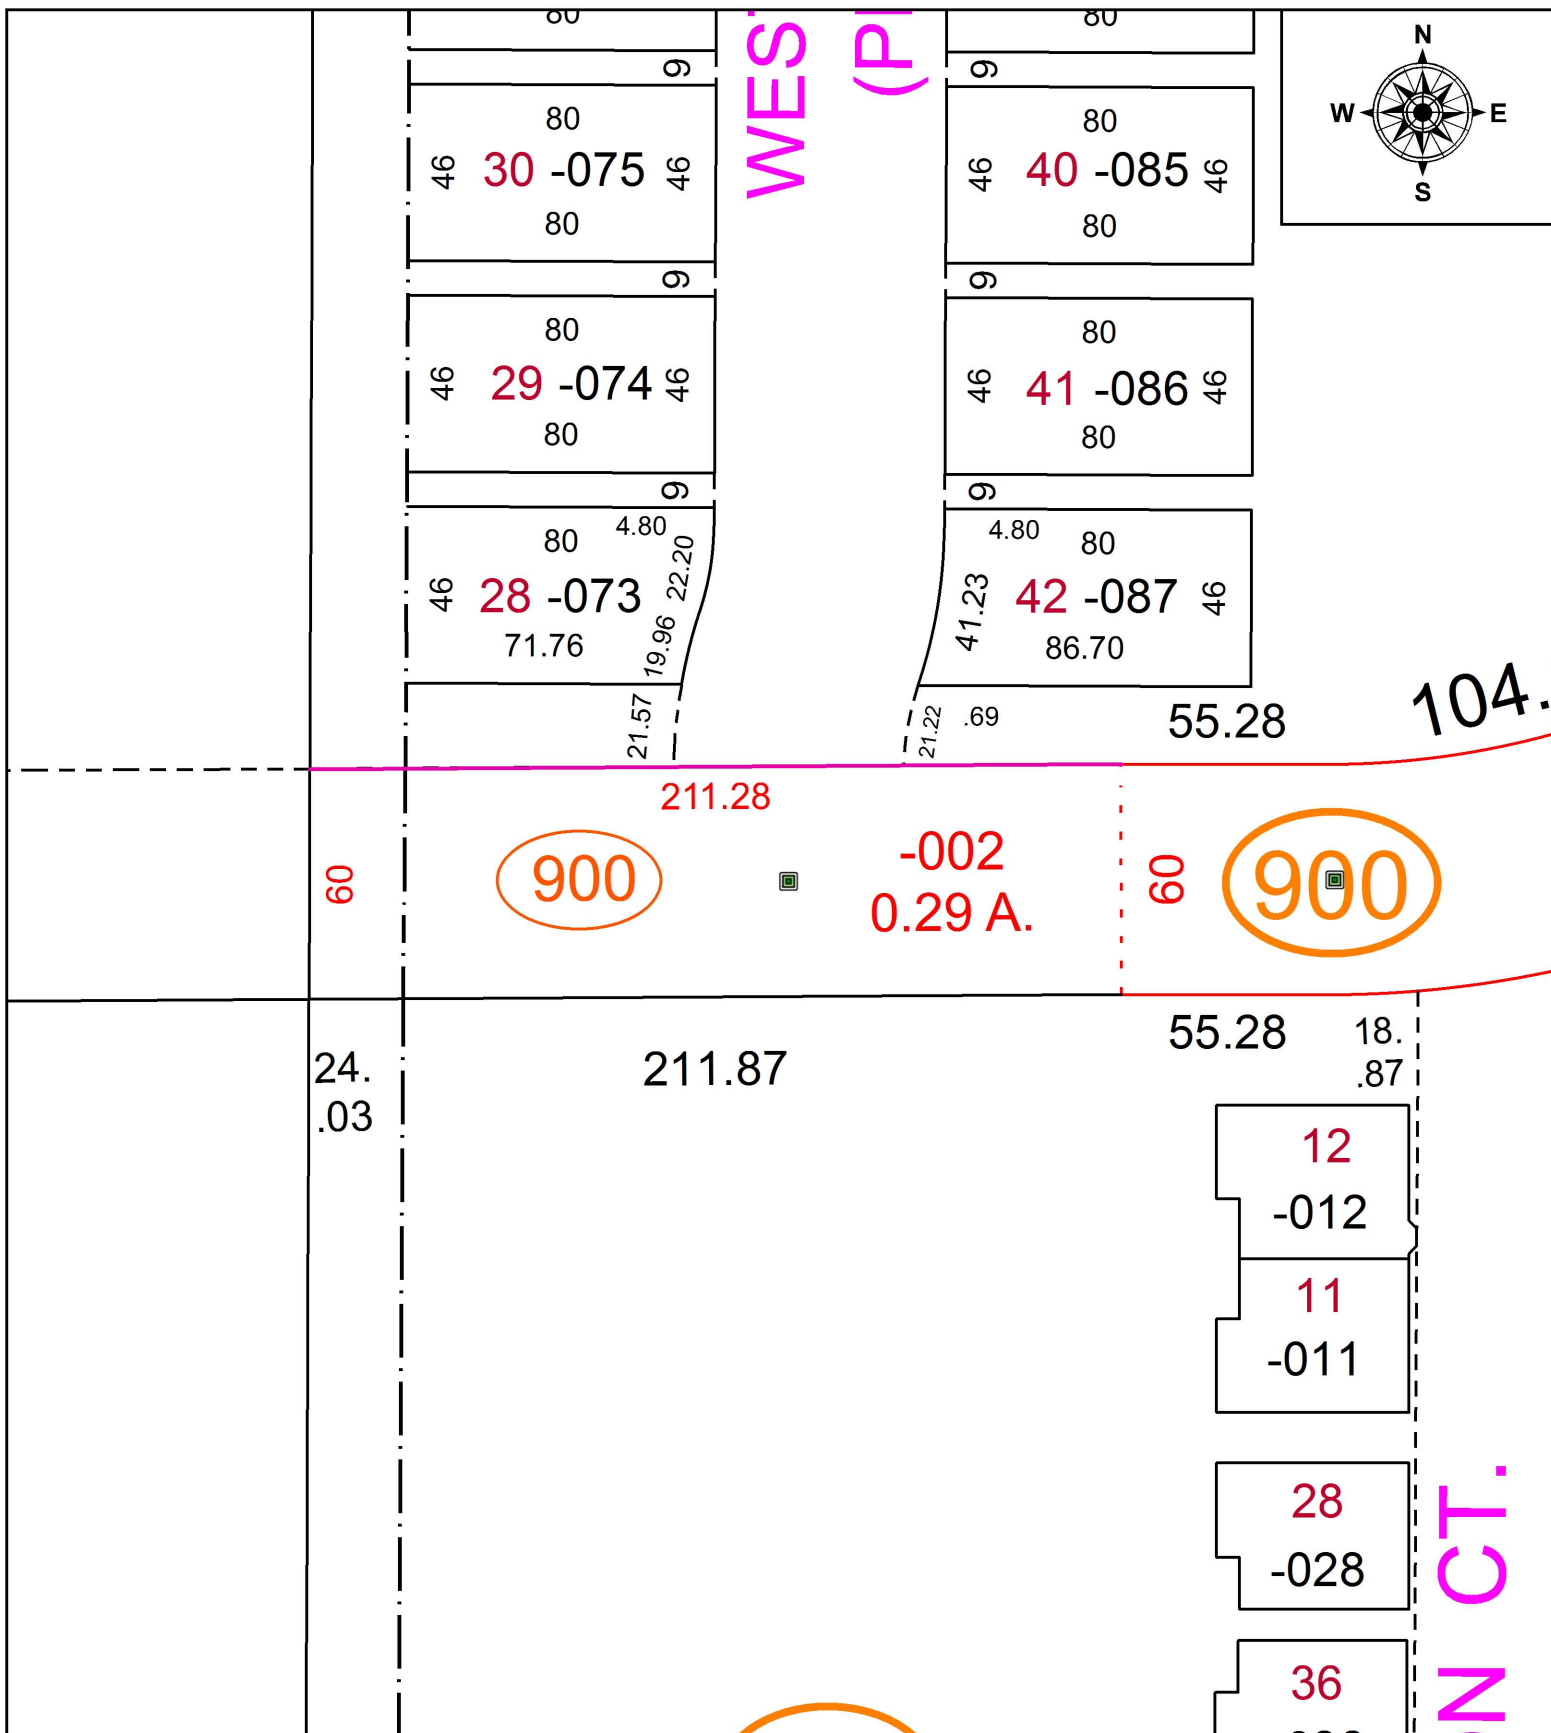

SPLITS/DEEDS PROCESSED
LORAIN COUNTY TAX MAP DEPARTMENT
226 MIDDLE AVE. ELYRIA, OH

SURVEYED BY: S. SAYLER
 CLOSURE: 1: 33,000
 MAP PAGE(S): 11-00-090
 APPROVED BY: TJS DATE: 3/6/17
 SCALE: 1" = 50' PRIOR INSTRUMENT: PV 101 PG. 40