
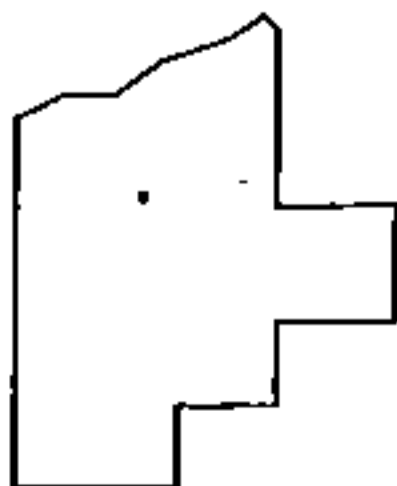
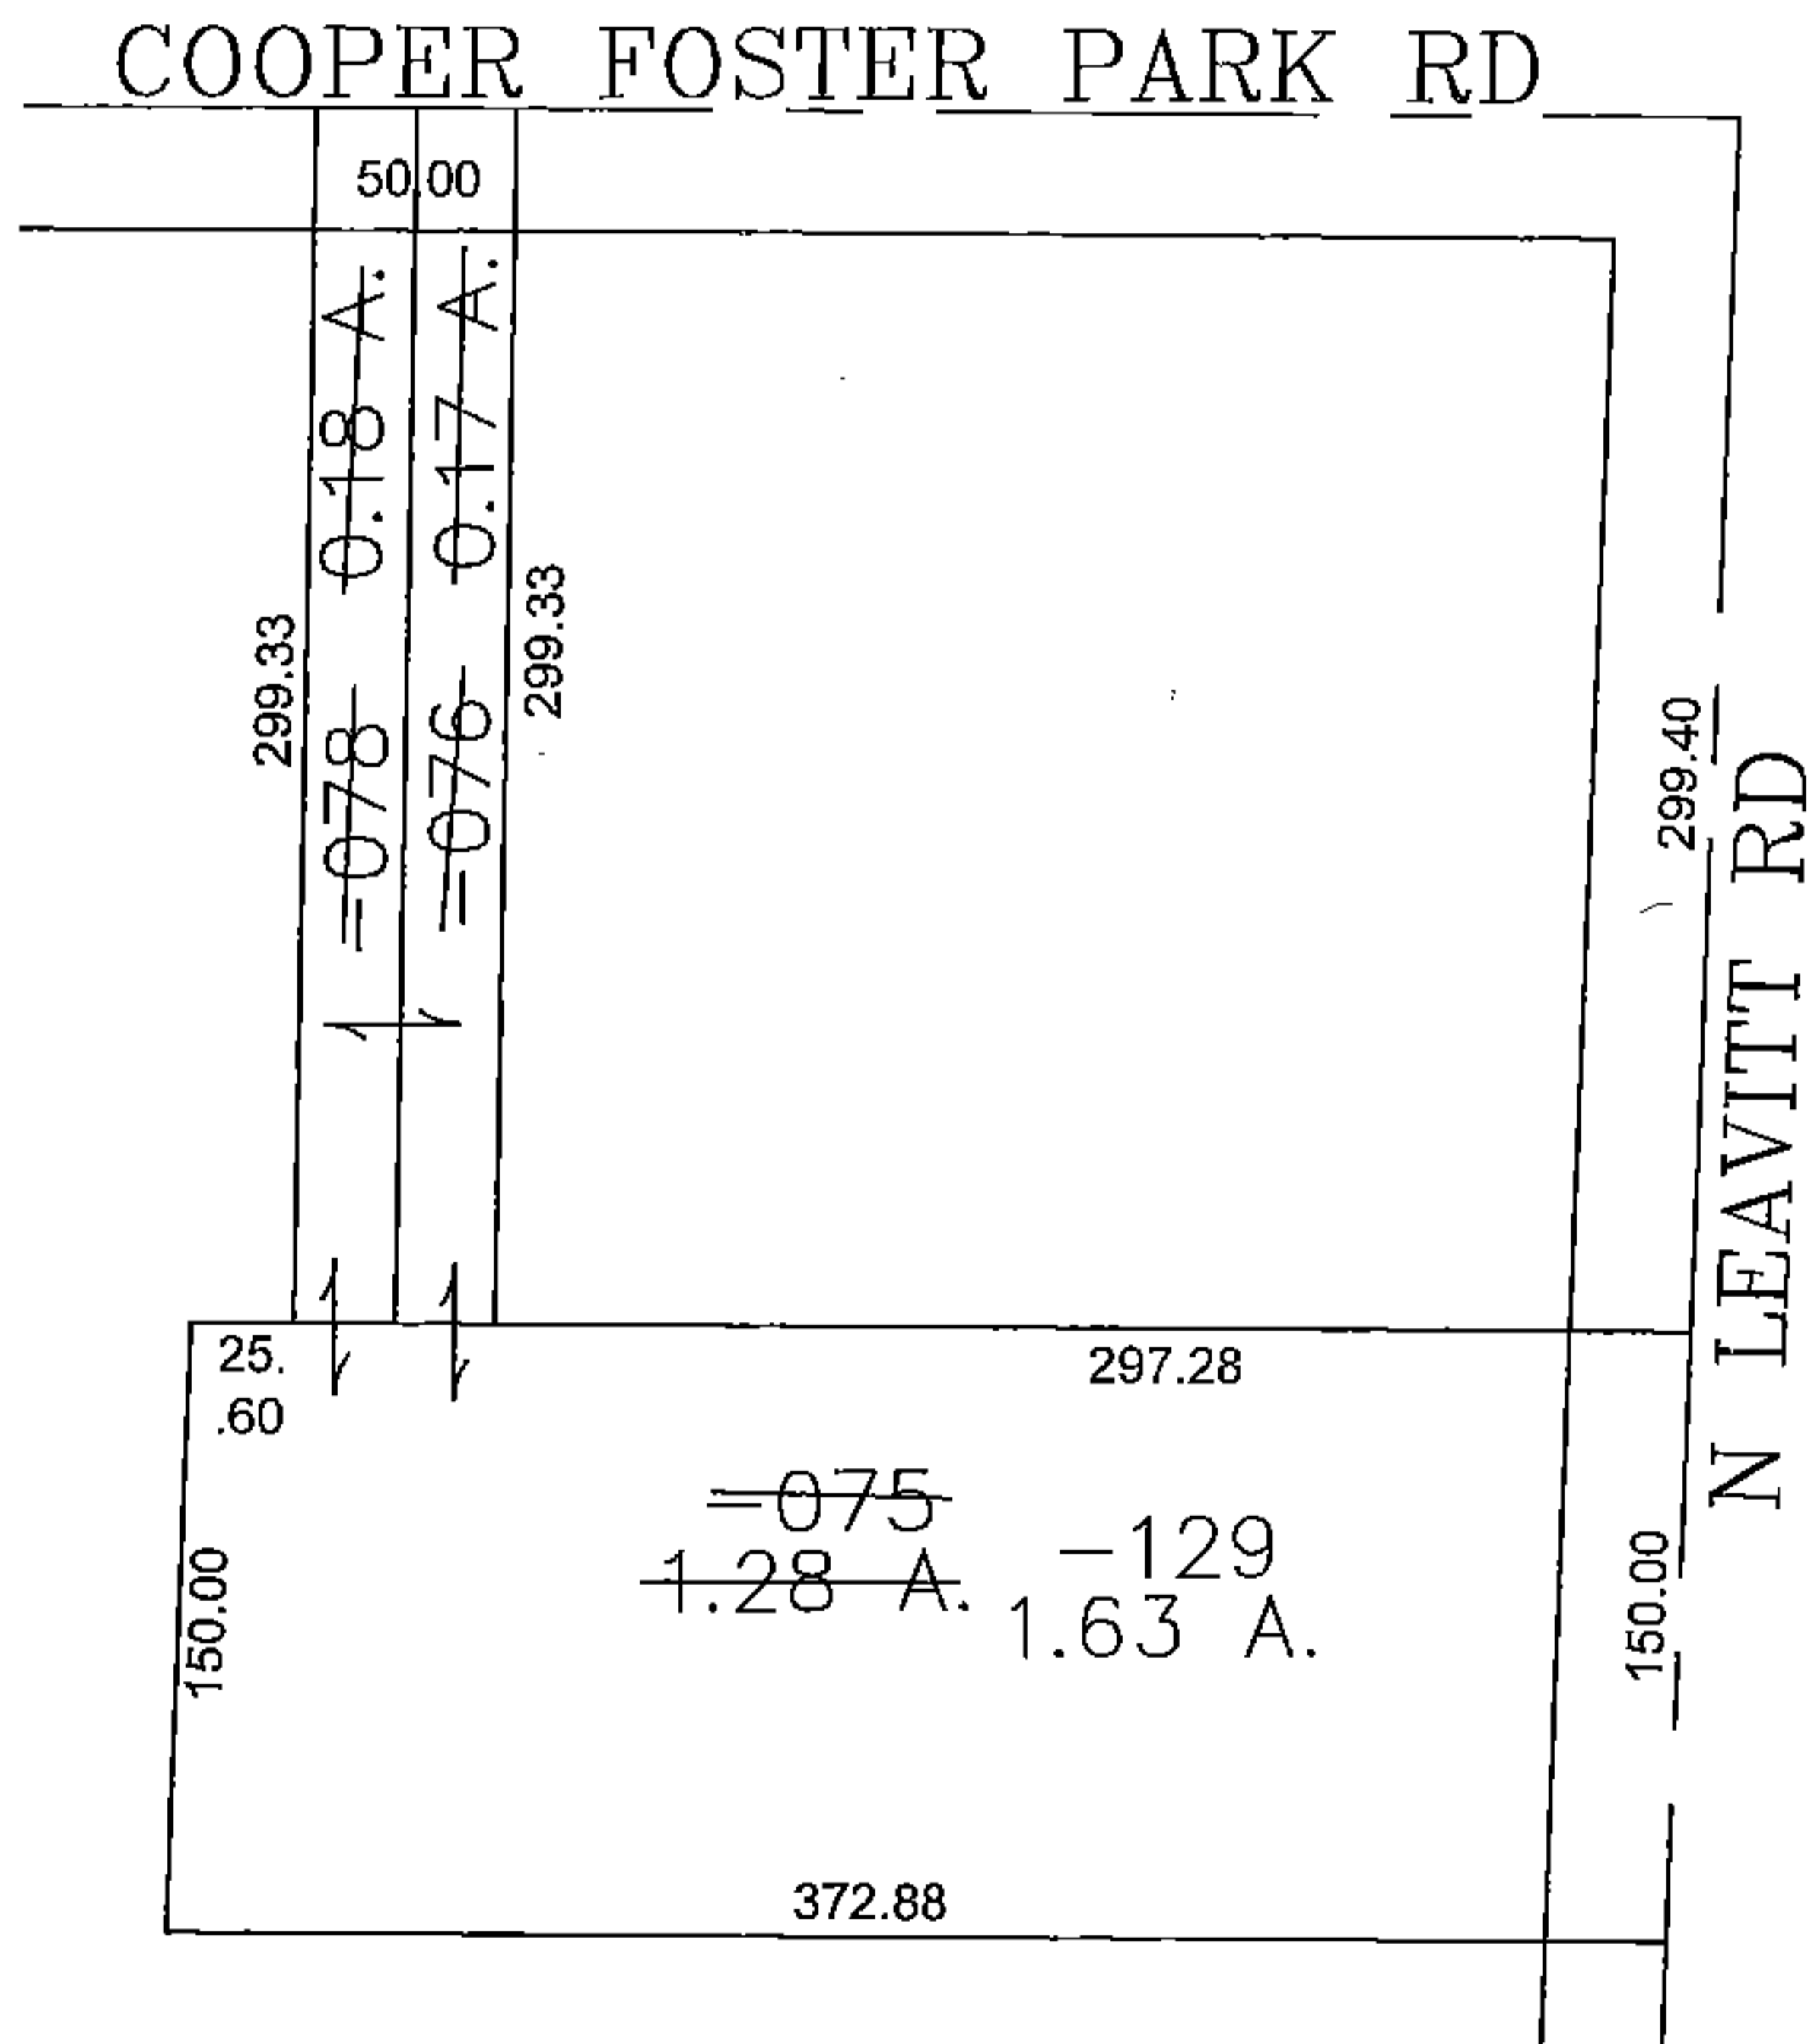


PARENT PARCEL: 05-00-040-106-075, -076, -078

CHILD PARCEL: 05-00-040-106-129

STARTING POINT: CENTERLINE OF COOPER FOSTER PARK RD & N LEAVITT RD

16-03624

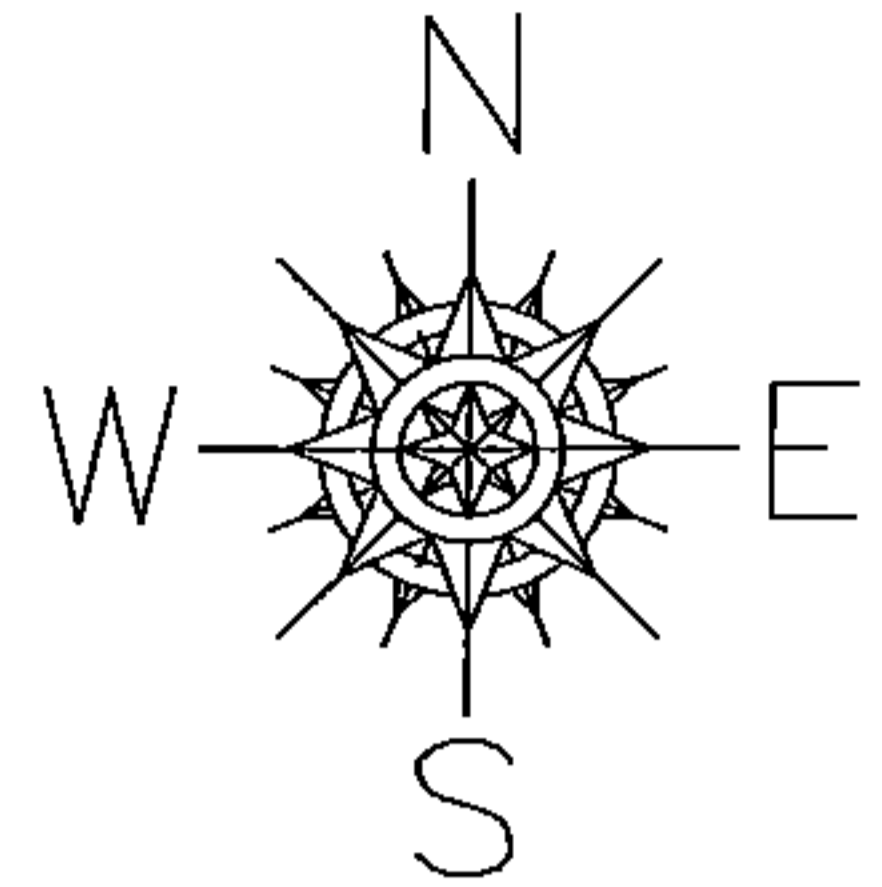

SPLITS/DEEDS PROCESSED

LORAIN COUNTY TAX MAP DEPARTMENT
226 MIDDLE AVE. ELYRIA, OHIO

SURVEYED BY: JAMES RESAR

CLOSURE: 0.00 : 10.000

MAP PAGE(S): 05-00-040

APPROVED BY: JAH DATE: 1/5/2017

SCALE: 1" = 100 PRIOR INSTRUMENT: 20160584928