


PARENT PARCEL: 01-00-022-102-008

CHILD PARCEL: XX-XX-XXX-XXX-XXX


STARTING POINT: INTERSECTION OF C/L OF CLAUD RD. AND C/L OF BROWNHelm STATION RD. E.

17-03626-D

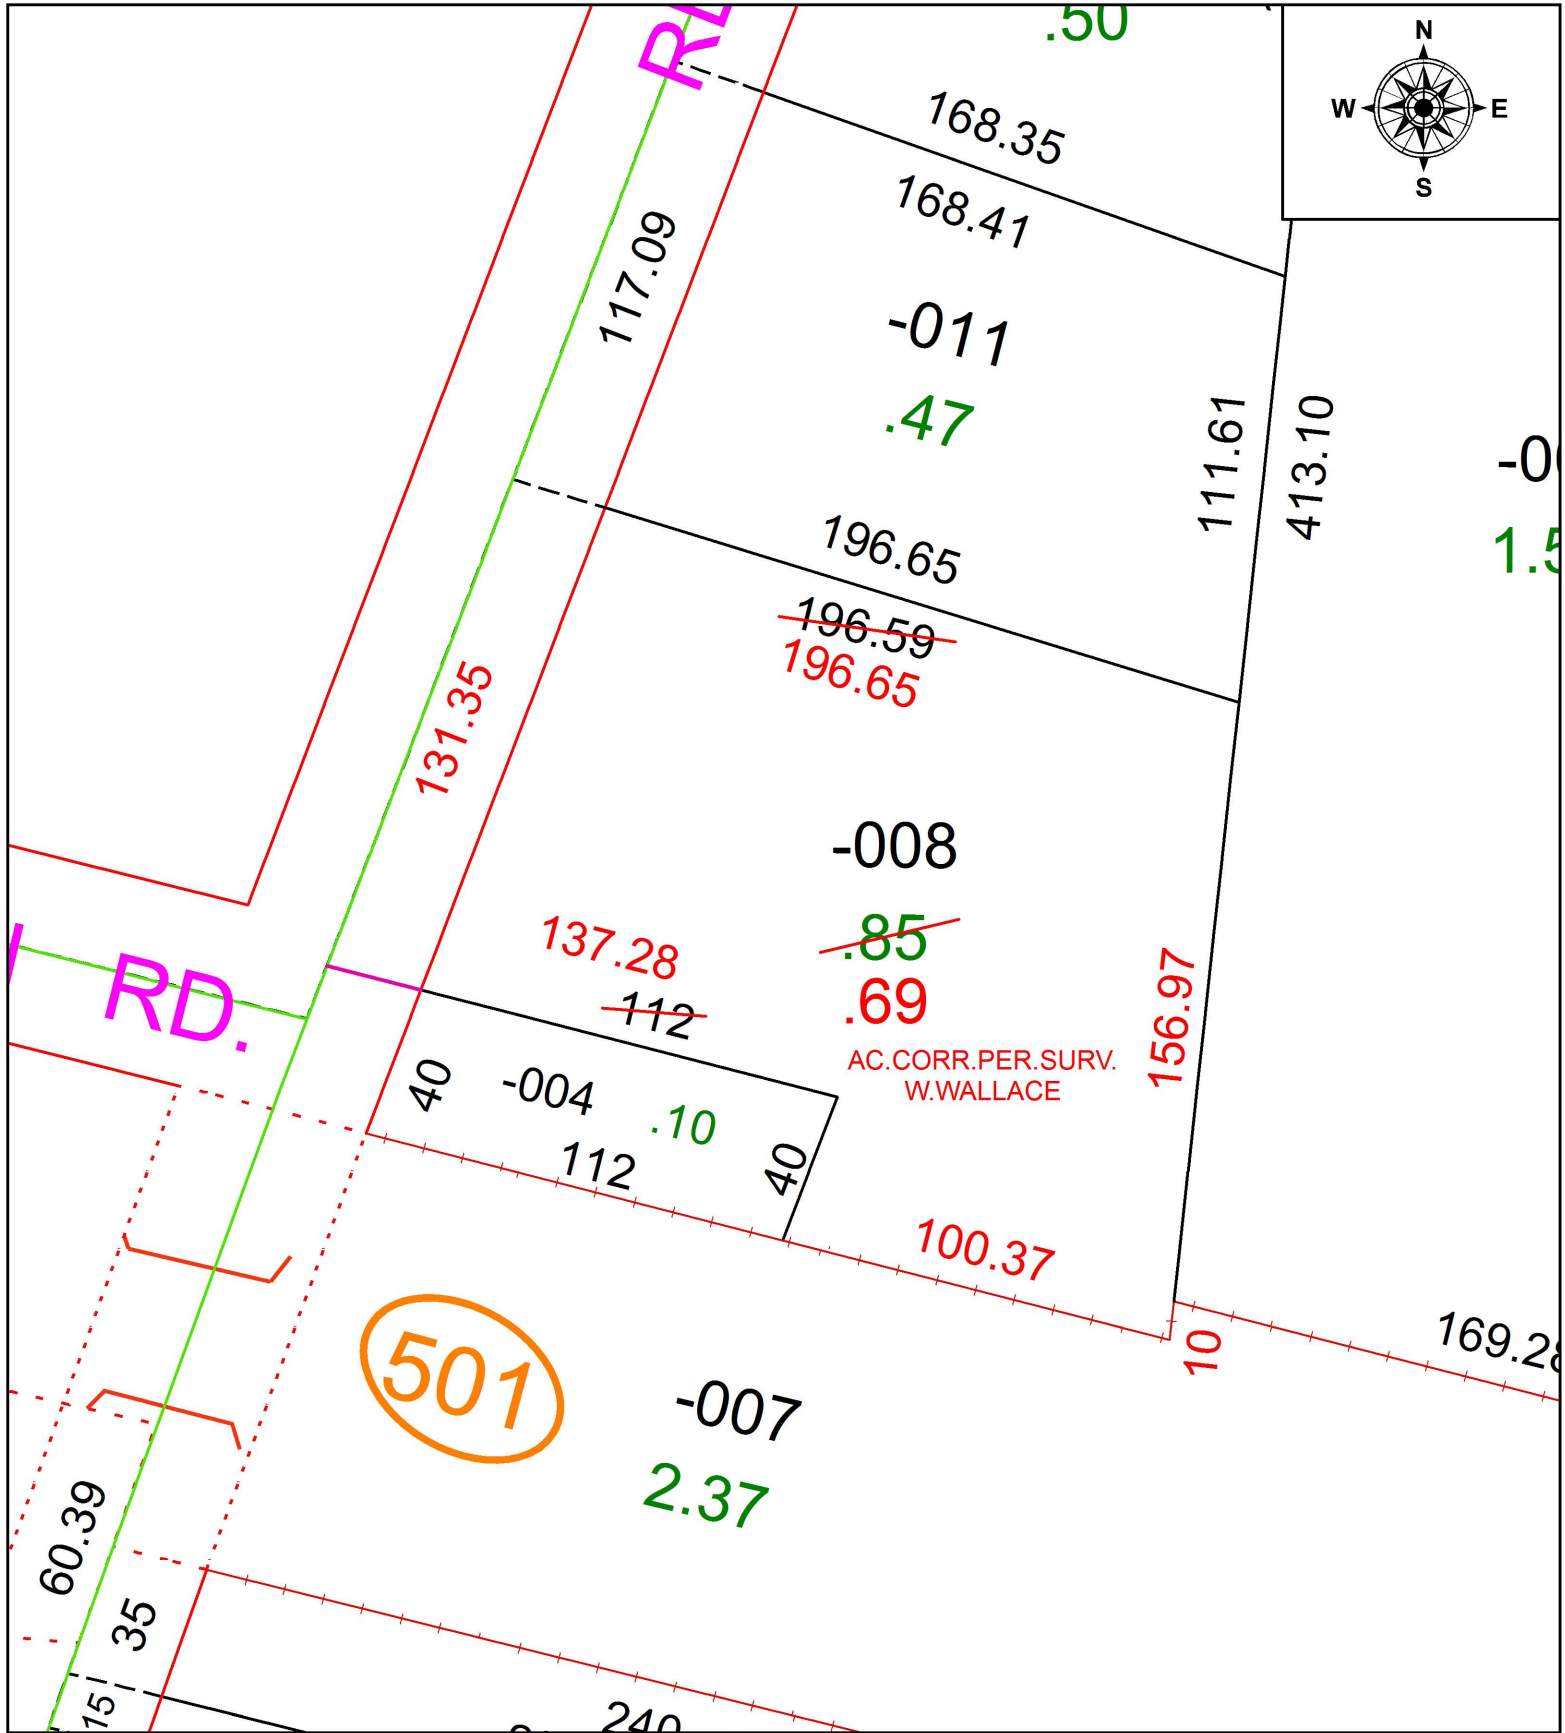

501

AC. CORR. PER. SURV.
W. WALLACE

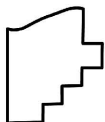

SPLITS/DEEDS PROCESSED
LORAIN COUNTY TAX MAP DEPARTMENT
226 MIDDLE AVE. ELYRIA, OH

SURVEYED BY: WILLIAM R. WALLACE
CLOSURE: 1: 99,356
MAP PAGE(S): 1-00-022
APPROVED BY: RRM DATE: 3-8-17
SCALE: 1" = 50 PRIOR INSTRUMENT: 20160595746