
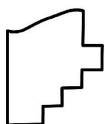


PARENT PARCEL: 12-00-029-000-016

CHILD PARCEL: 12-00-029-000-047 & -048

STARTING POINT: DRILL HOLE IN STONE MONUMENT, CL OF EMMONS RD. & CL OF BOONE RD.

17-03627

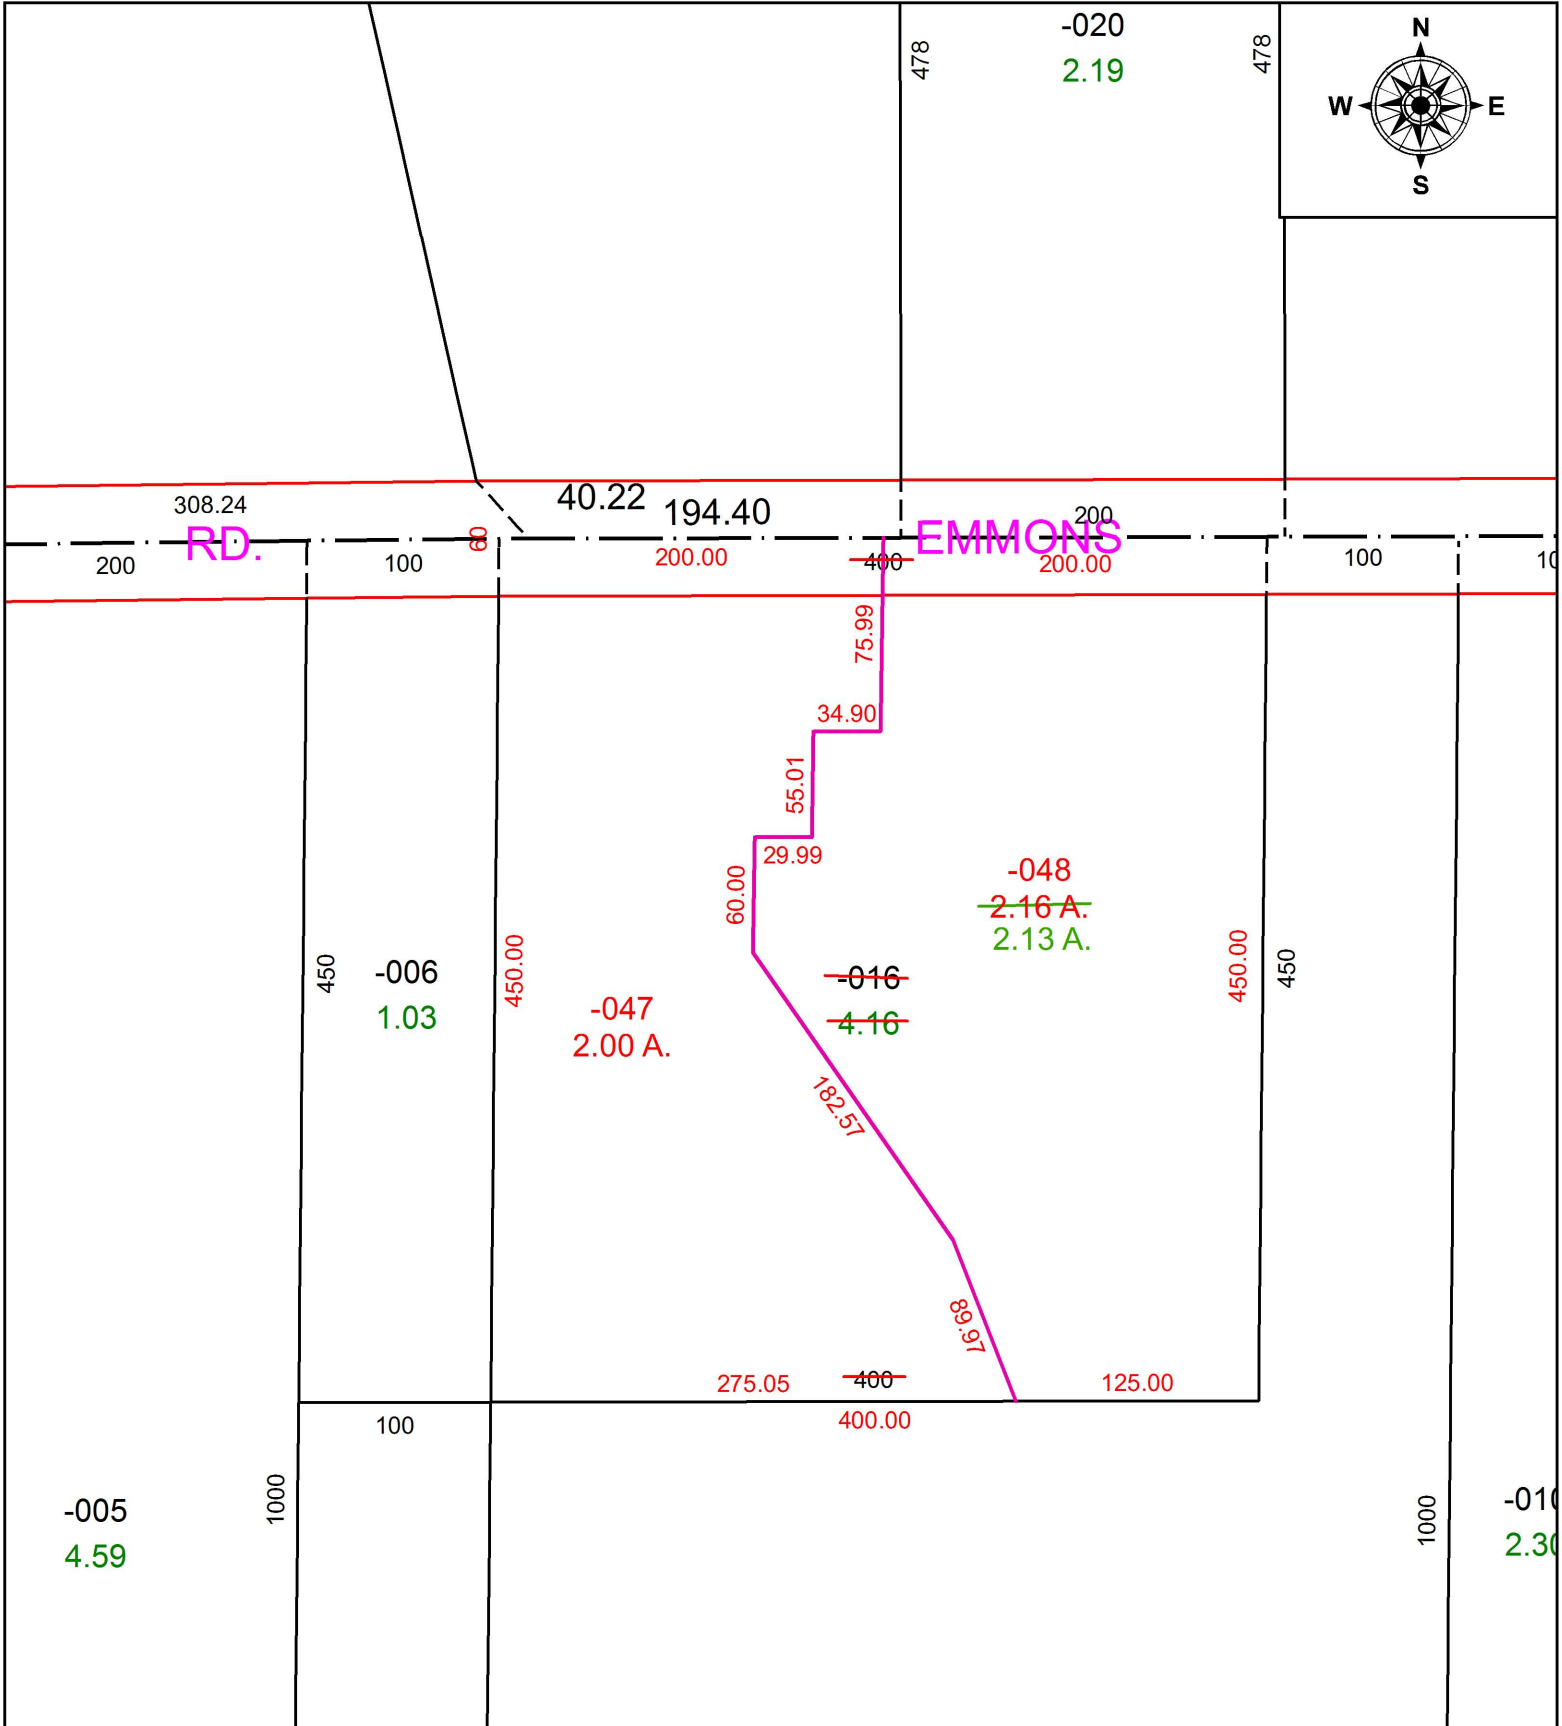

SPLITS/DEEDS PROCESSED
 LORAIN COUNTY TAX MAP DEPARTMENT
 226 MIDDLE AVE. ELYRIA, OH

SURVEYED BY: PATRICK A. McGANNON

CLOSURE: 1: 89,000

MAP PAGE(S): 12-00-029

APPROVED BY: TJS DATE: 1/18/17

SCALE: 1" = 200 PRIOR INSTRUMENT: DV 1101/858