


PARENT PARCEL: 06-21-002-000-030

CHILD PARCEL: XX-XX-XXX-XXX-XXX

STARTING POINT: NORTHEAST CORNER OF O.L.2

17-03630-A

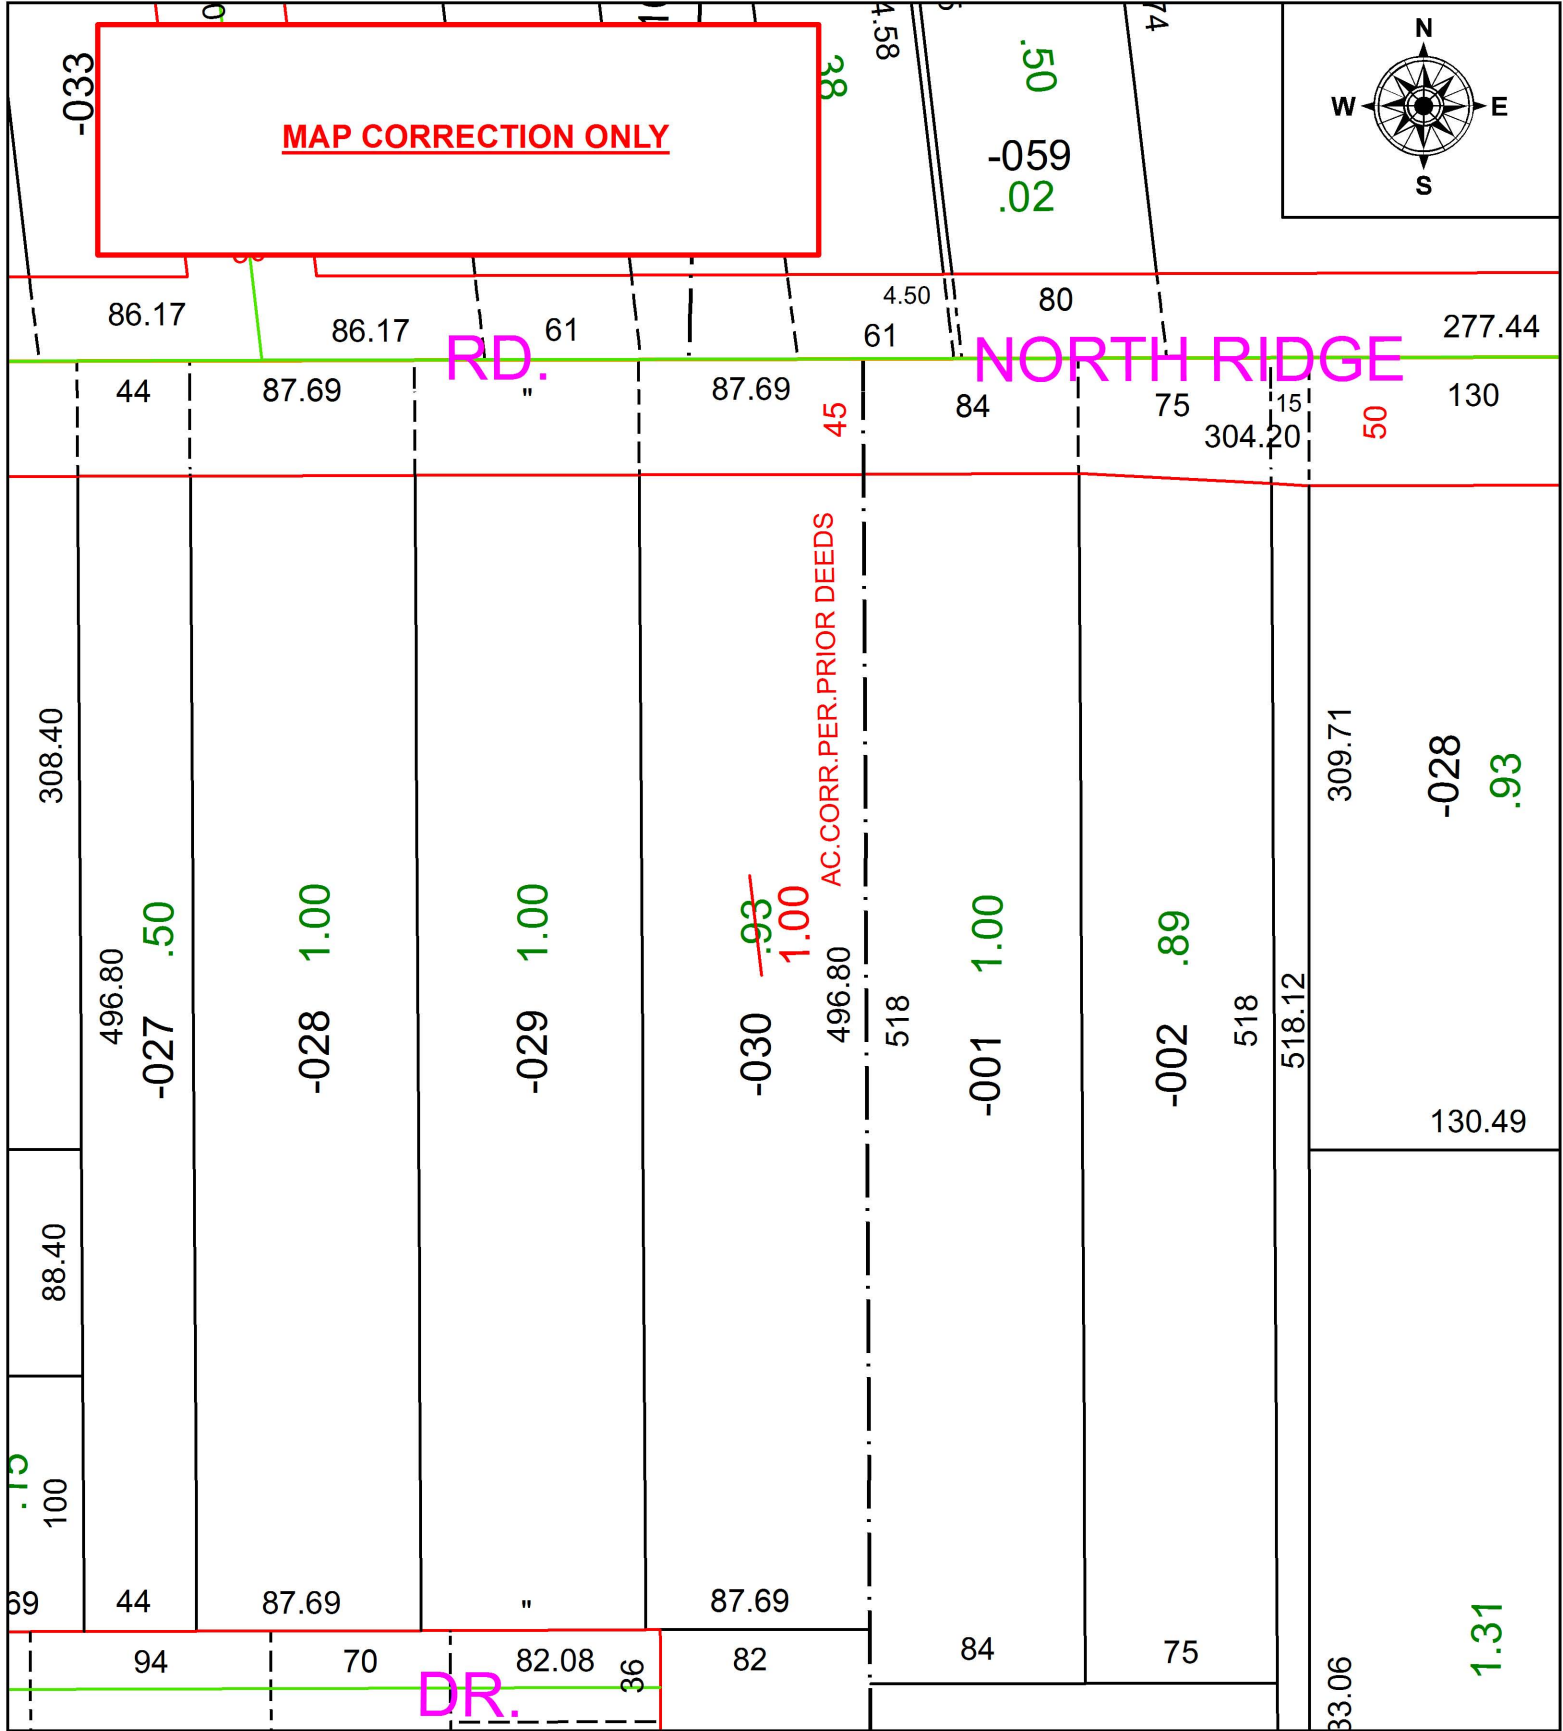

**SPLITS/DEEDS PROCESSED**  
 LORAIN COUNTY TAX MAP DEPARTMENT  
 226 MIDDLE AVE. ELYRIA, OH

SURVEYED BY: \_\_\_\_\_ N/A  
 CLOSURE: \_\_\_\_\_ N/A  
 MAP PAGE(S): \_\_\_\_\_ 6-2  
 APPROVED BY: \_\_\_\_\_ RRM DATE: \_\_\_\_\_ 3-15-17  
 SCALE: \_\_\_\_\_ 1" = 75' PRIOR INSTRUMENT: \_\_\_\_\_ OR 205/359