


PARENT PARCEL: 04-00-006-111-012

CHILD PARCEL: 04-00-006-111-013, -014

STARTING POINT: INTERSECTION OF C/L OF LAKE RD. AND C/L OF SHIELDS RD.

17-03632

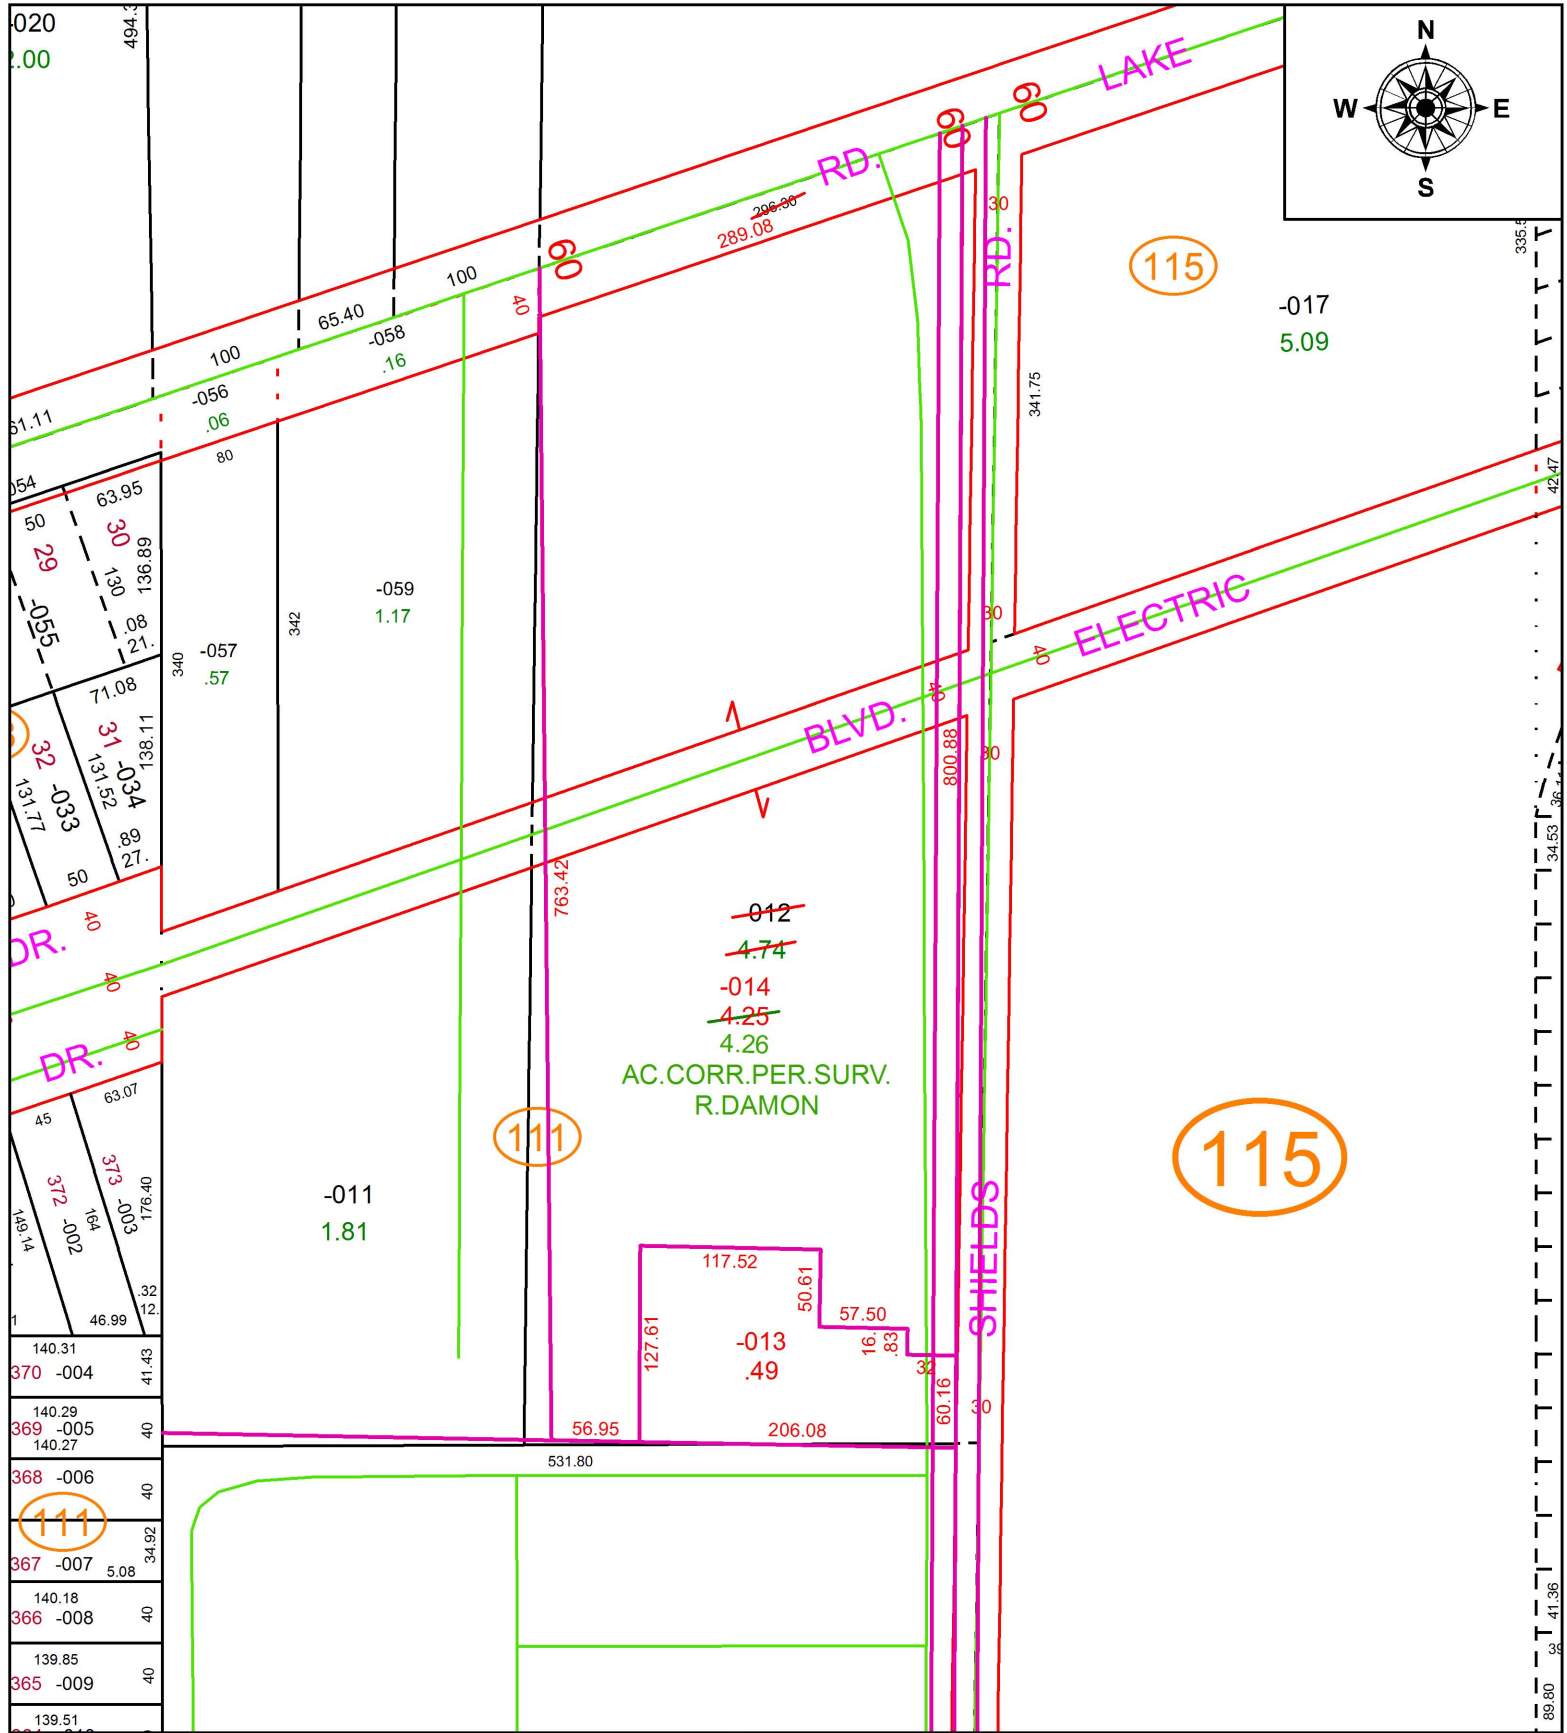

**SPLITS/DEEDS PROCESSED**  
 LORAIN COUNTY TAX MAP DEPARTMENT  
 226 MIDDLE AVE. ELYRIA, OH

**SURVEYED BY:** ROBERT A. DAMON  
**CLOSURE:** 1: 108,000  
**MAP PAGE(S):** 4-00-006  
**APPROVED BY:** RRM **DATE:** 2-8-17  
**SCALE:** 1" = 125 **PRIOR INSTRUMENT:** 20110372930