
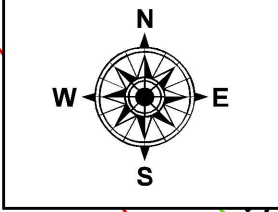


PARENT PARCEL: 12-00-099-000-005, -034

CHILD PARCEL: 12-00-099-000-075

STARTING POINT: INTERSECTION OF C/L OF ROOT RD. AND C/L OF HAWKE RD.

17-03633

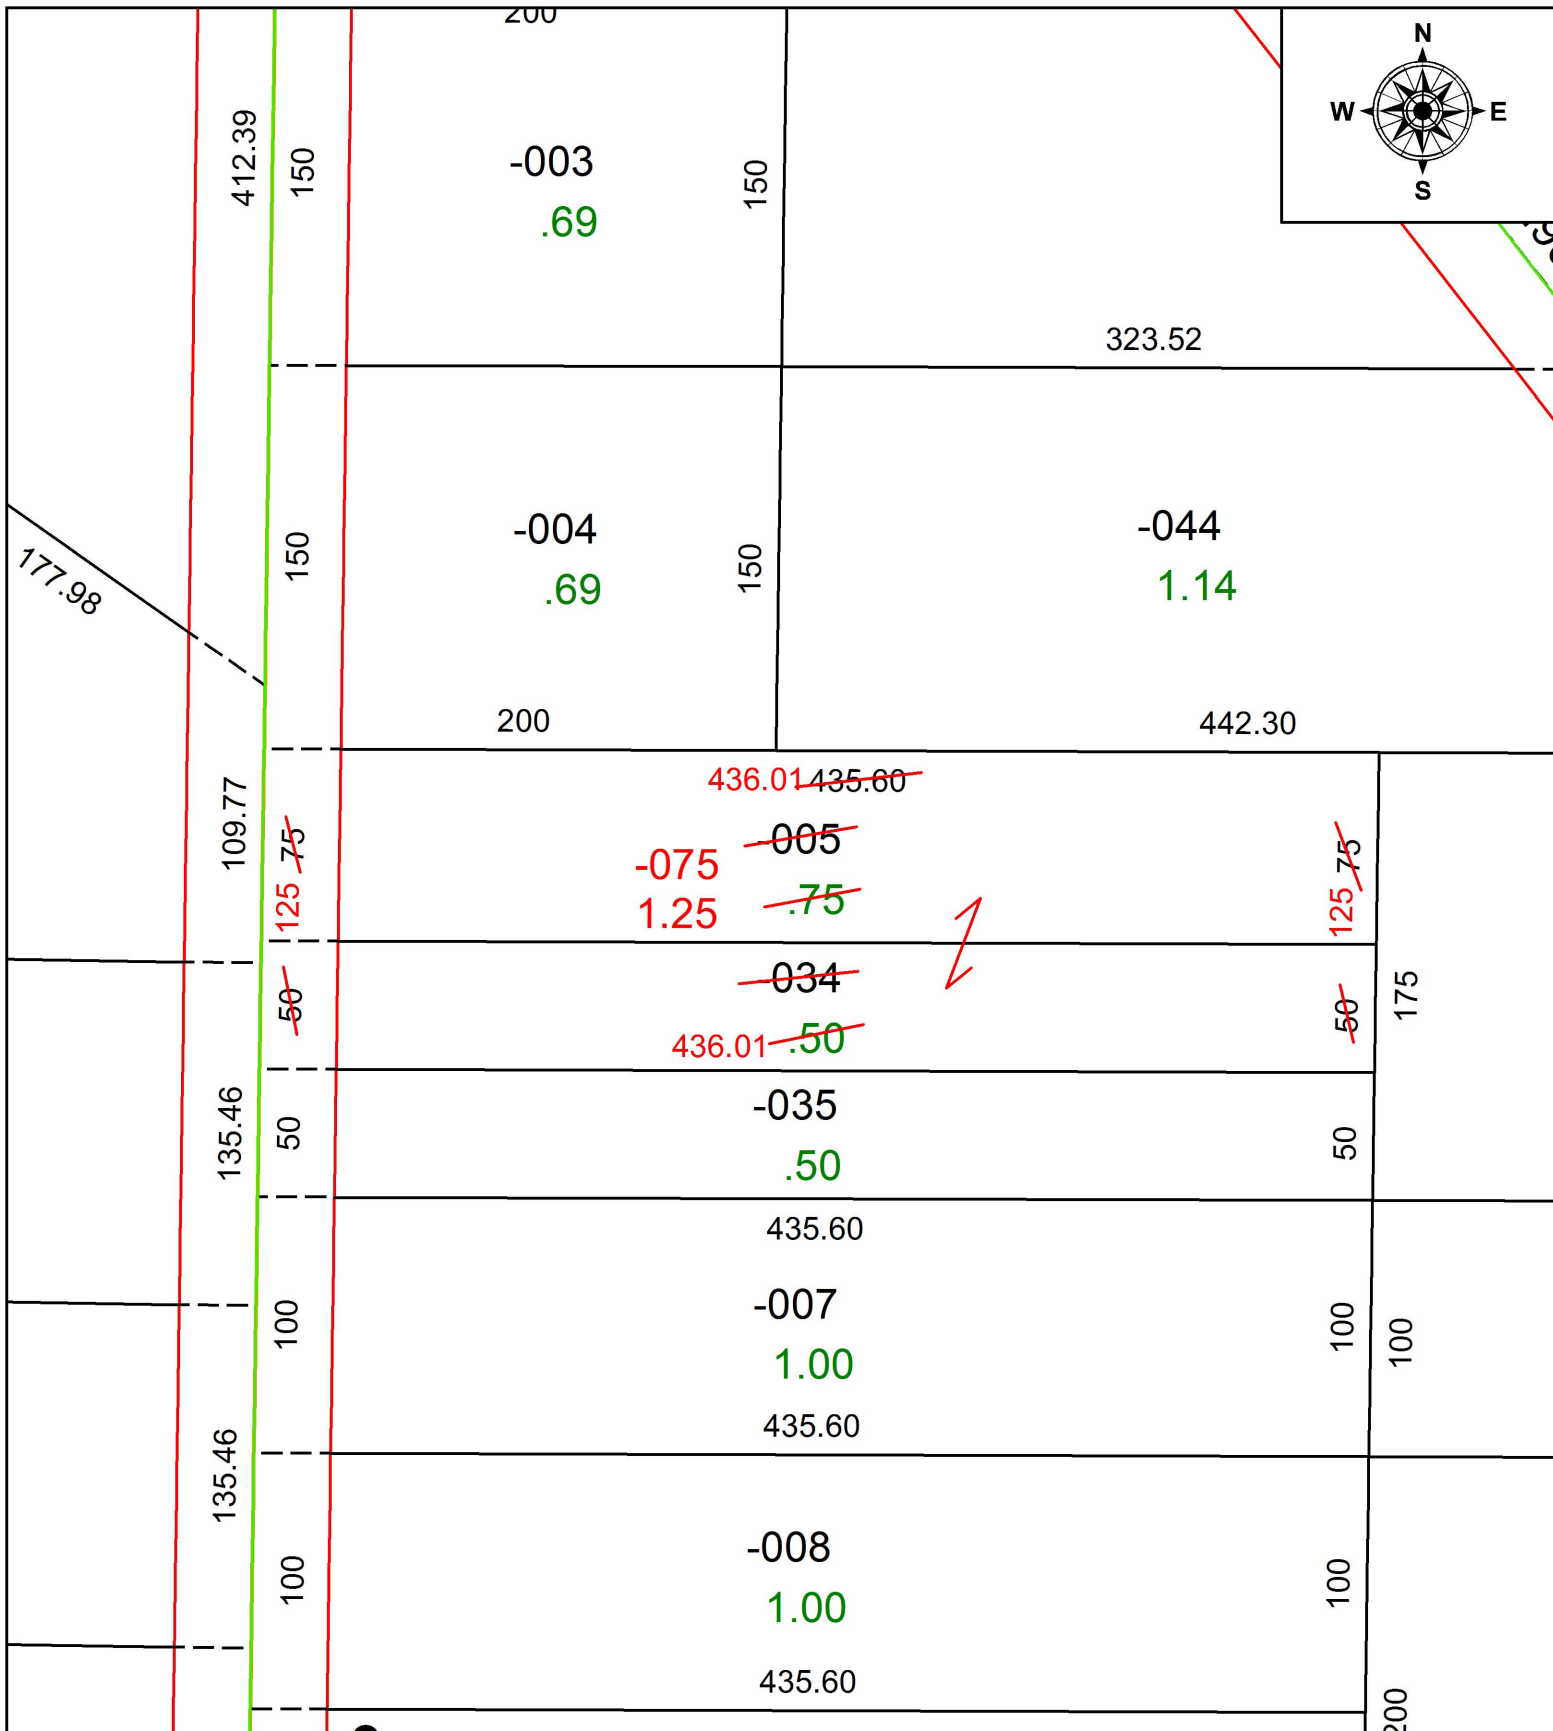

**SPLITS/DEEDS PROCESSED**  
 LORAIN COUNTY TAX MAP DEPARTMENT  
 226 MIDDLE AVE. ELYRIA, OH

SURVEYED BY: WILFREDO BARBOSA  
 CLOSURE: 1: 2147483648  
 MAP PAGE(S): 12-00-099  
 APPROVED BY: RRM DATE: 2/8/17  
 SCALE: 1" = 75 PRIOR INSTRUMENT: 19980559361