


PARENT PARCEL: 16-00-001-104-011, -016, 16-00-001-501-004

CHILD PARCEL: XX-XX-XXX-XXX-XXX


STARTING POINT: NORTH LINE OF VILLAGE LOT 1 AND C/L OF BECKER CT.

17-03638-D

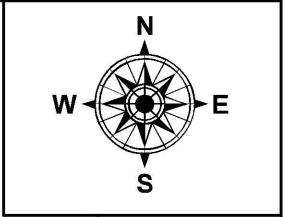


**FRONTAGE AND DEPTH
TO ACREAGE CORRECTION**
 0.58 A.
~~88.47 X 150~~
 16-00-001-104-011
 CORR. PER SURVEY P.FREDRICKSON

GRAFTON TWP

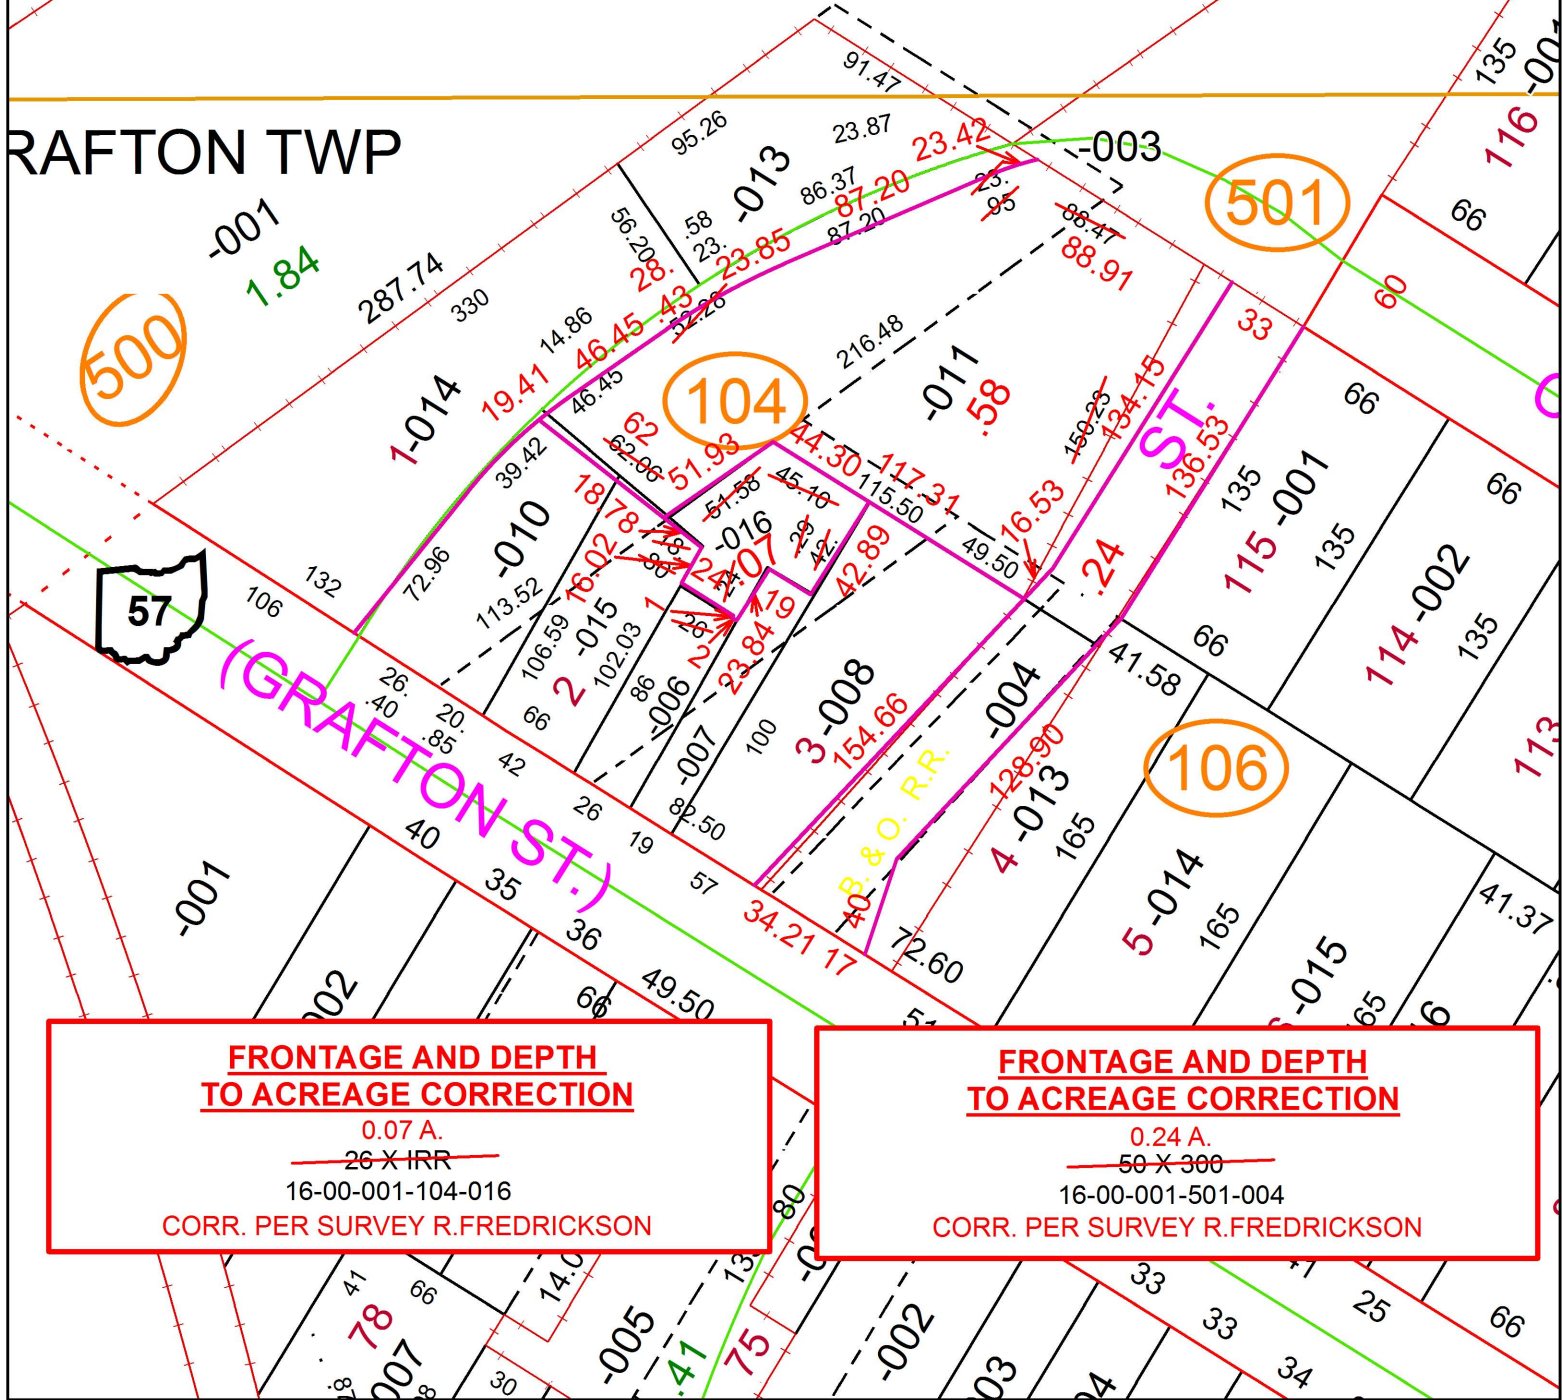

**FRONTAGE AND DEPTH
TO ACREAGE CORRECTION**
 0.07 A.
~~26 X IRR~~
 16-00-001-104-016
 CORR. PER SURVEY R.FREDRICKSON

**FRONTAGE AND DEPTH
TO ACREAGE CORRECTION**
 0.24 A.
~~50 X 300~~
 16-00-001-501-004
 CORR. PER SURVEY R.FREDRICKSON

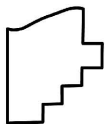

SPLITS/DEEDS PROCESSED
 LORAIN COUNTY TAX MAP DEPARTMENT
 226 MIDDLE AVE. ELYRIA, OH

SURVEYED BY: RICHARD A. FREDRICKSON
 CLOSURE: 1: 174,175
 MAP PAGE(S): 16-00-001
 APPROVED BY: RRM DATE: 3-27-17
 SCALE: 1" = 75 PRIOR INSTRUMENT: 20150563095