


PARENT PARCEL: 20-03-009-000-011


CHILD PARCEL: 20-03-008-000-007 & 20-03-009-000-012

STARTING POINT: N.E. CORNER OF O.L. 9, TRACT 3

17-03640-D

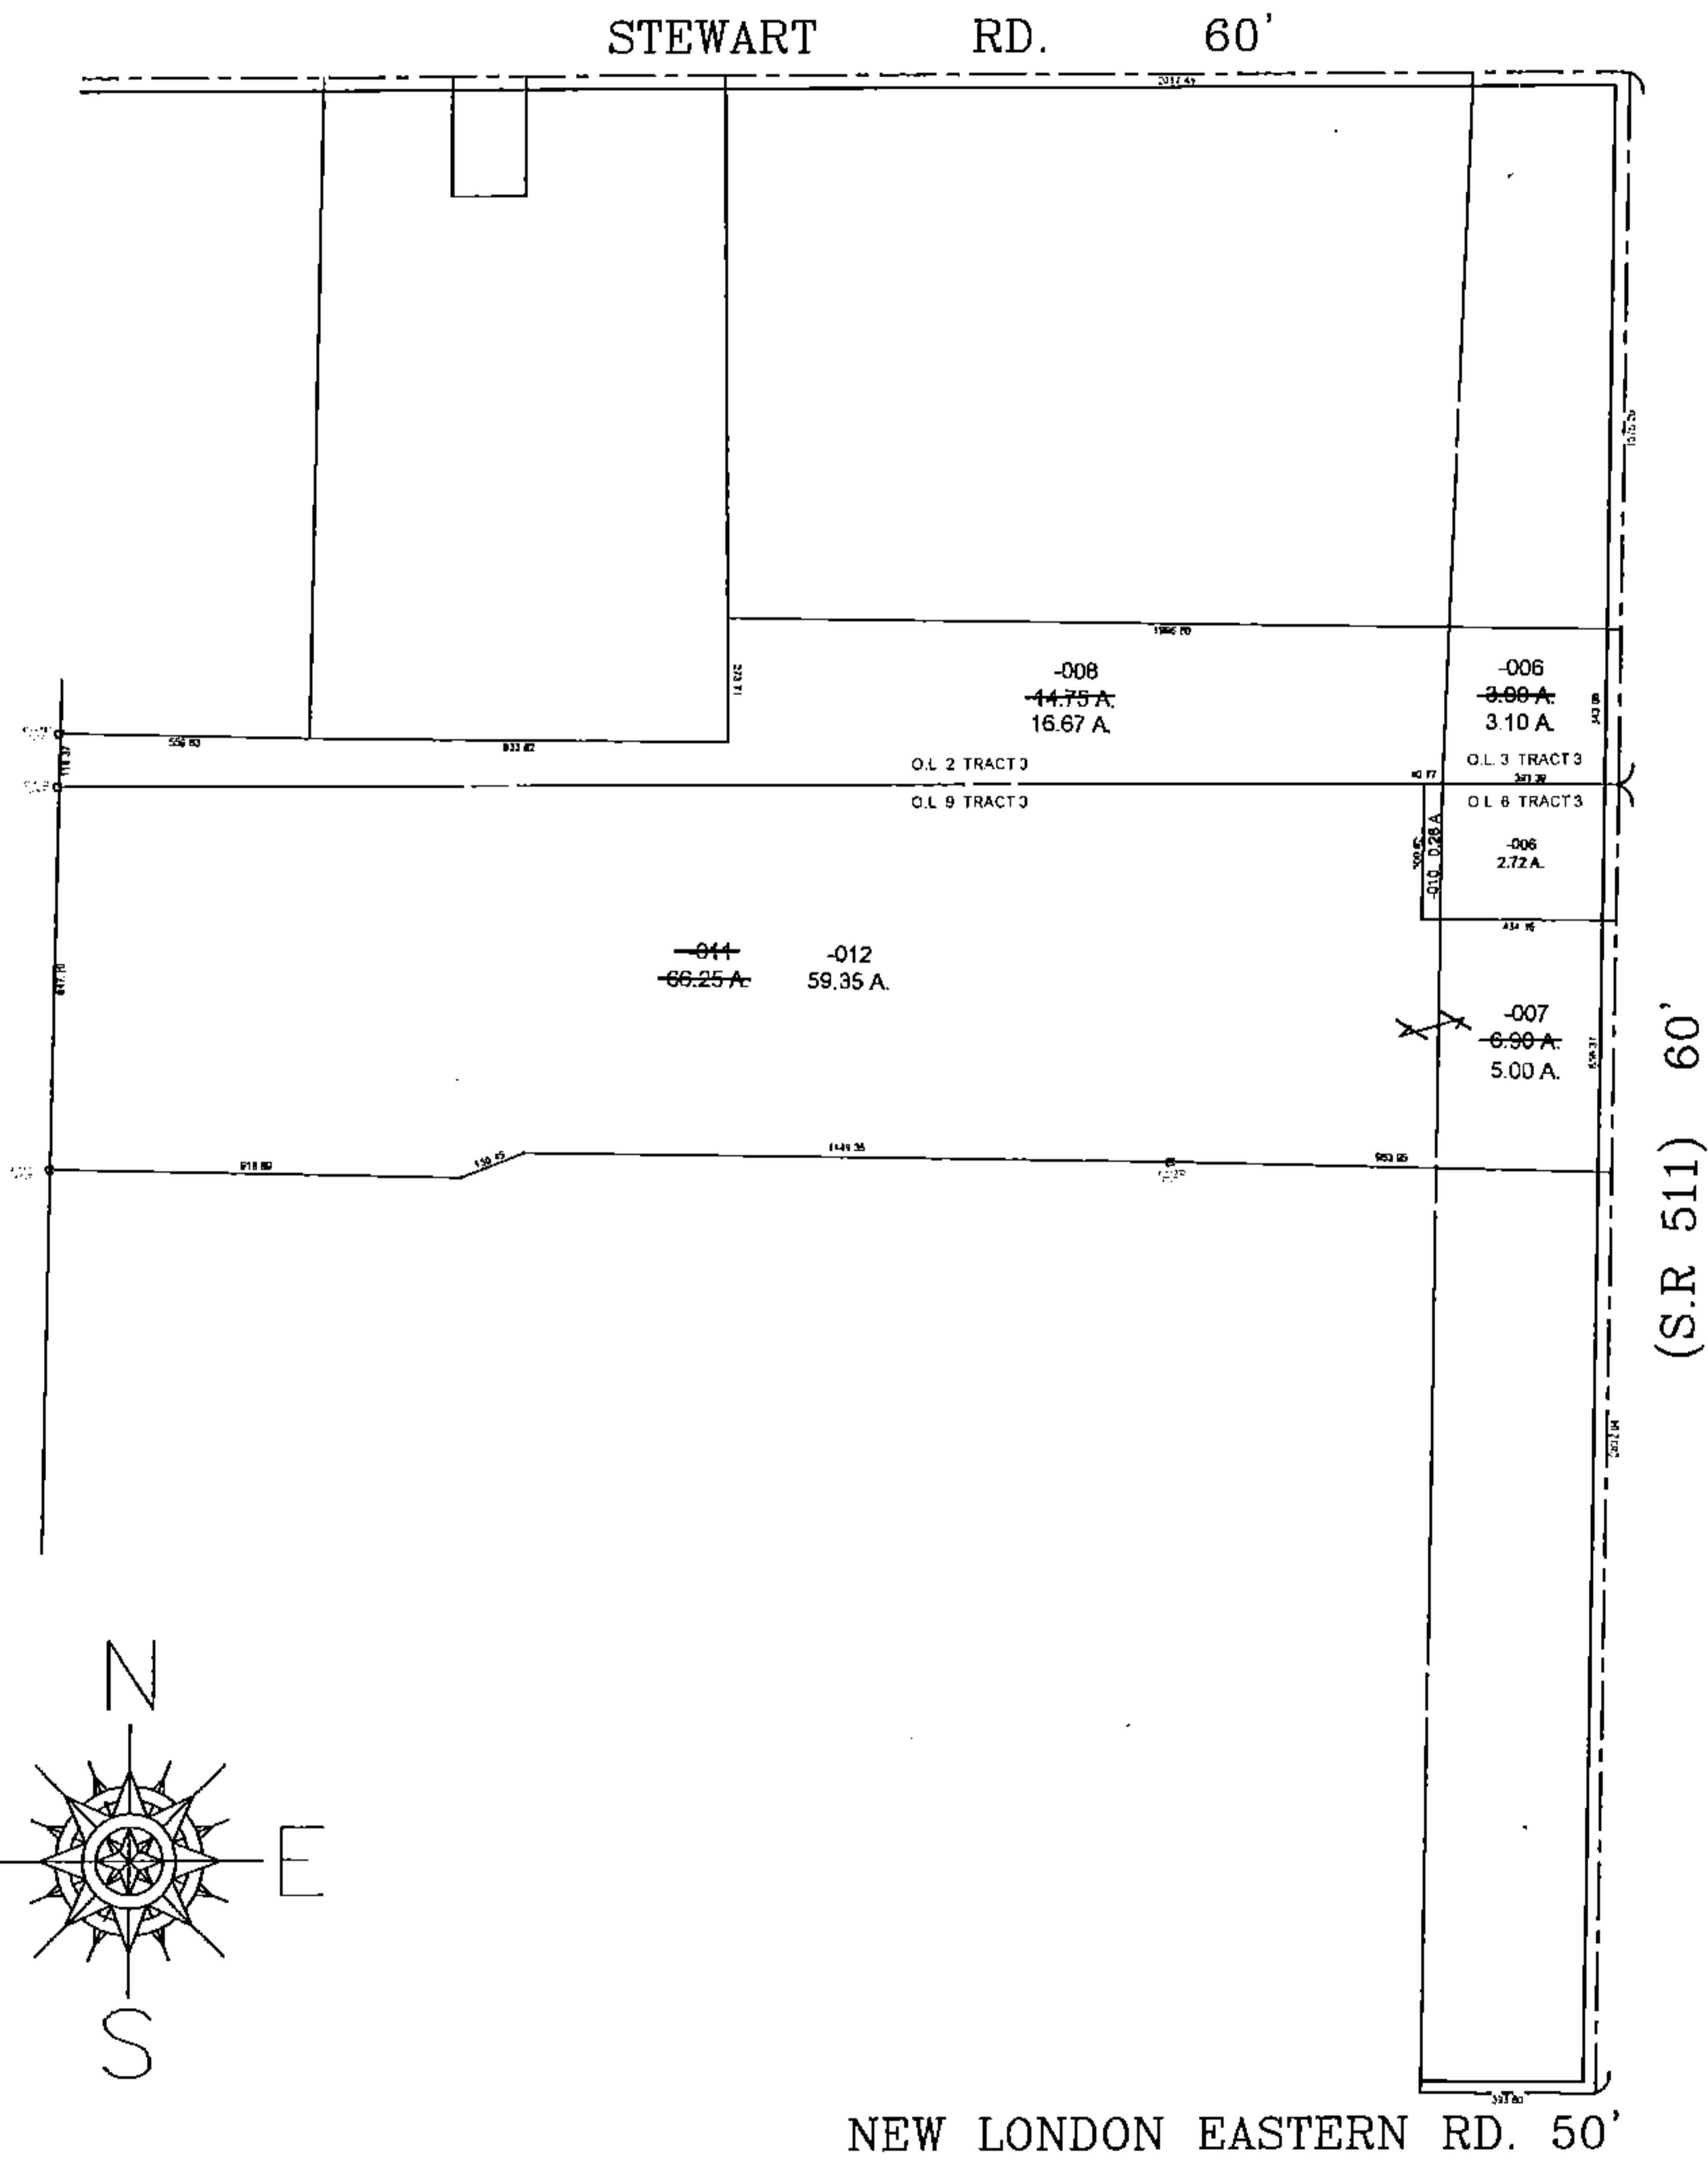

NEW LONDON EASTERN RD. 50'

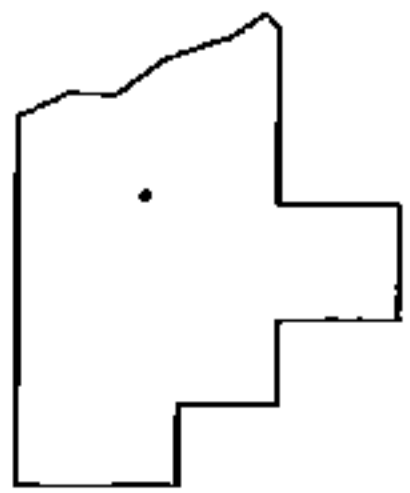

SPLITS/DEEDS PROCESSED

LORAIN COUNTY TAX MAP DEPARTMENT
226 MIDDLE AVE. ELYRIA, OHIO

SURVEYED BY: RONALD L. LAUGHERY
 CLOSURE: 0.01 : 10.000
 MAP PAGE(S): 20-03-009
 APPROVED BY: TJS DATE: 4/5/17
 SCALE: 1" = 600 PRIOR INSTRUMENT: 2016-093871