
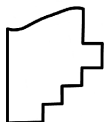
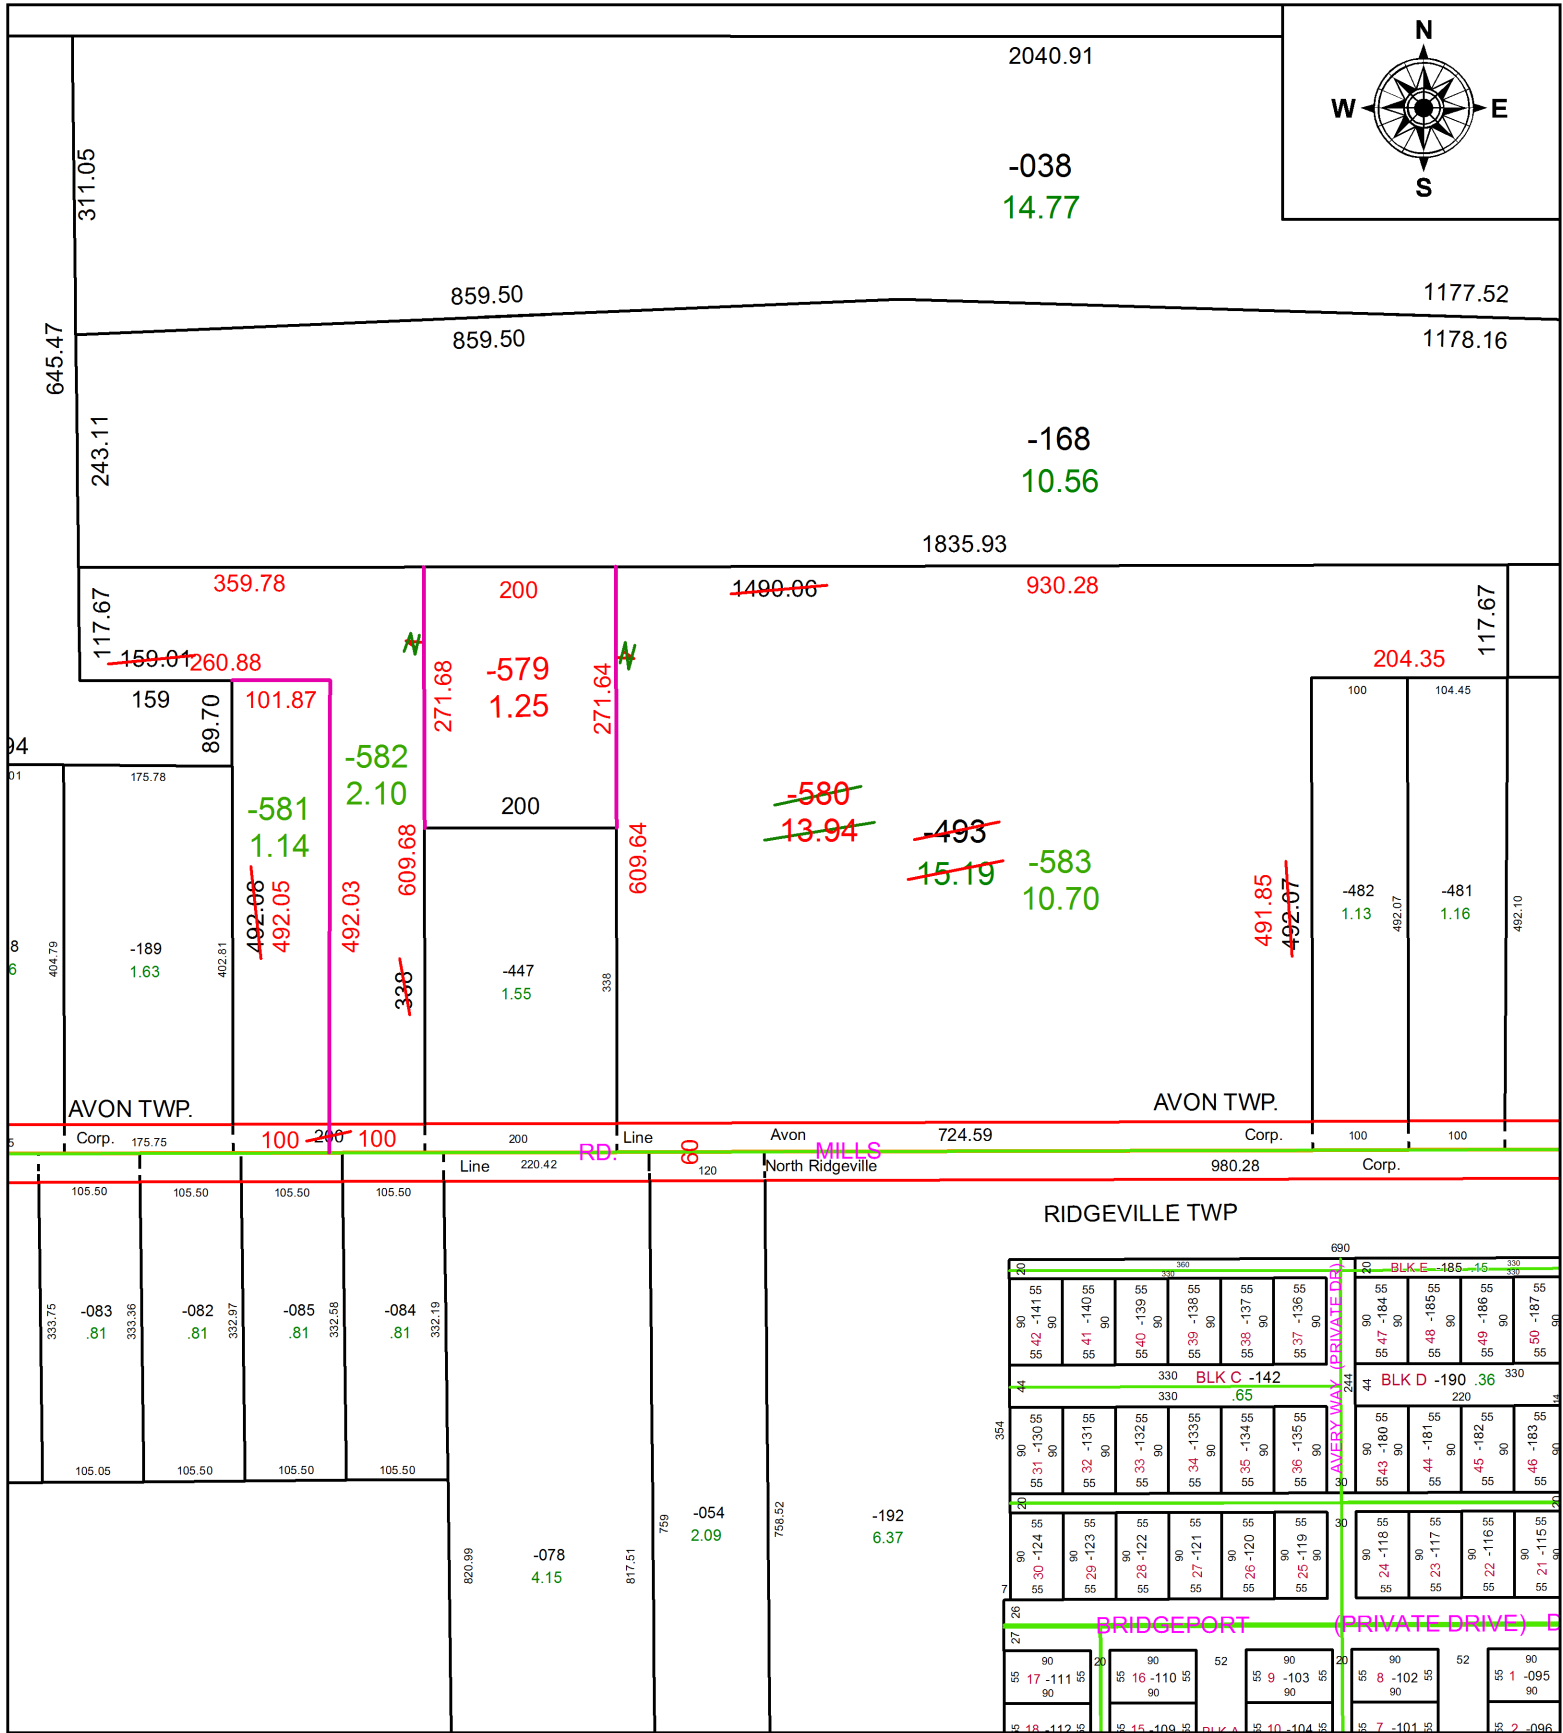


PARENT PARCEL: 04-00-013-000-493

CHILD PARCEL: 04-00-013-000-579 THRU -583

STARTING POINT: INTERSECTION OF C/L OF CENTER RD. AND C/L OF MILLS RD.

17-03644

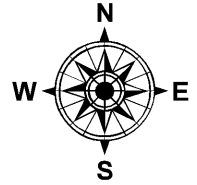

**SPLITS/DEEDS PROCESSED**  
LORAIN COUNTY TAX MAP DEPARTMENT  
226 MIDDLE AVE. ELYRIA, OH

SURVEYED BY: THOMAS A. SIMON  
CLOSURE: 1: 224,482  
MAP PAGE(S): 4-00-013  
APPROVED BY: RRM DATE: 2-27-17  
SCALE: 1" = 200 PRIOR INSTRUMENT: 20060174195