
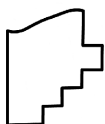


PARENT PARCEL: 05-00-072-000-066, -067

CHILD PARCEL: 05-00-072-000-068 THRU -070

STARTING POINT: SOUTHWEST CORNER OF O.L.72

17-03645

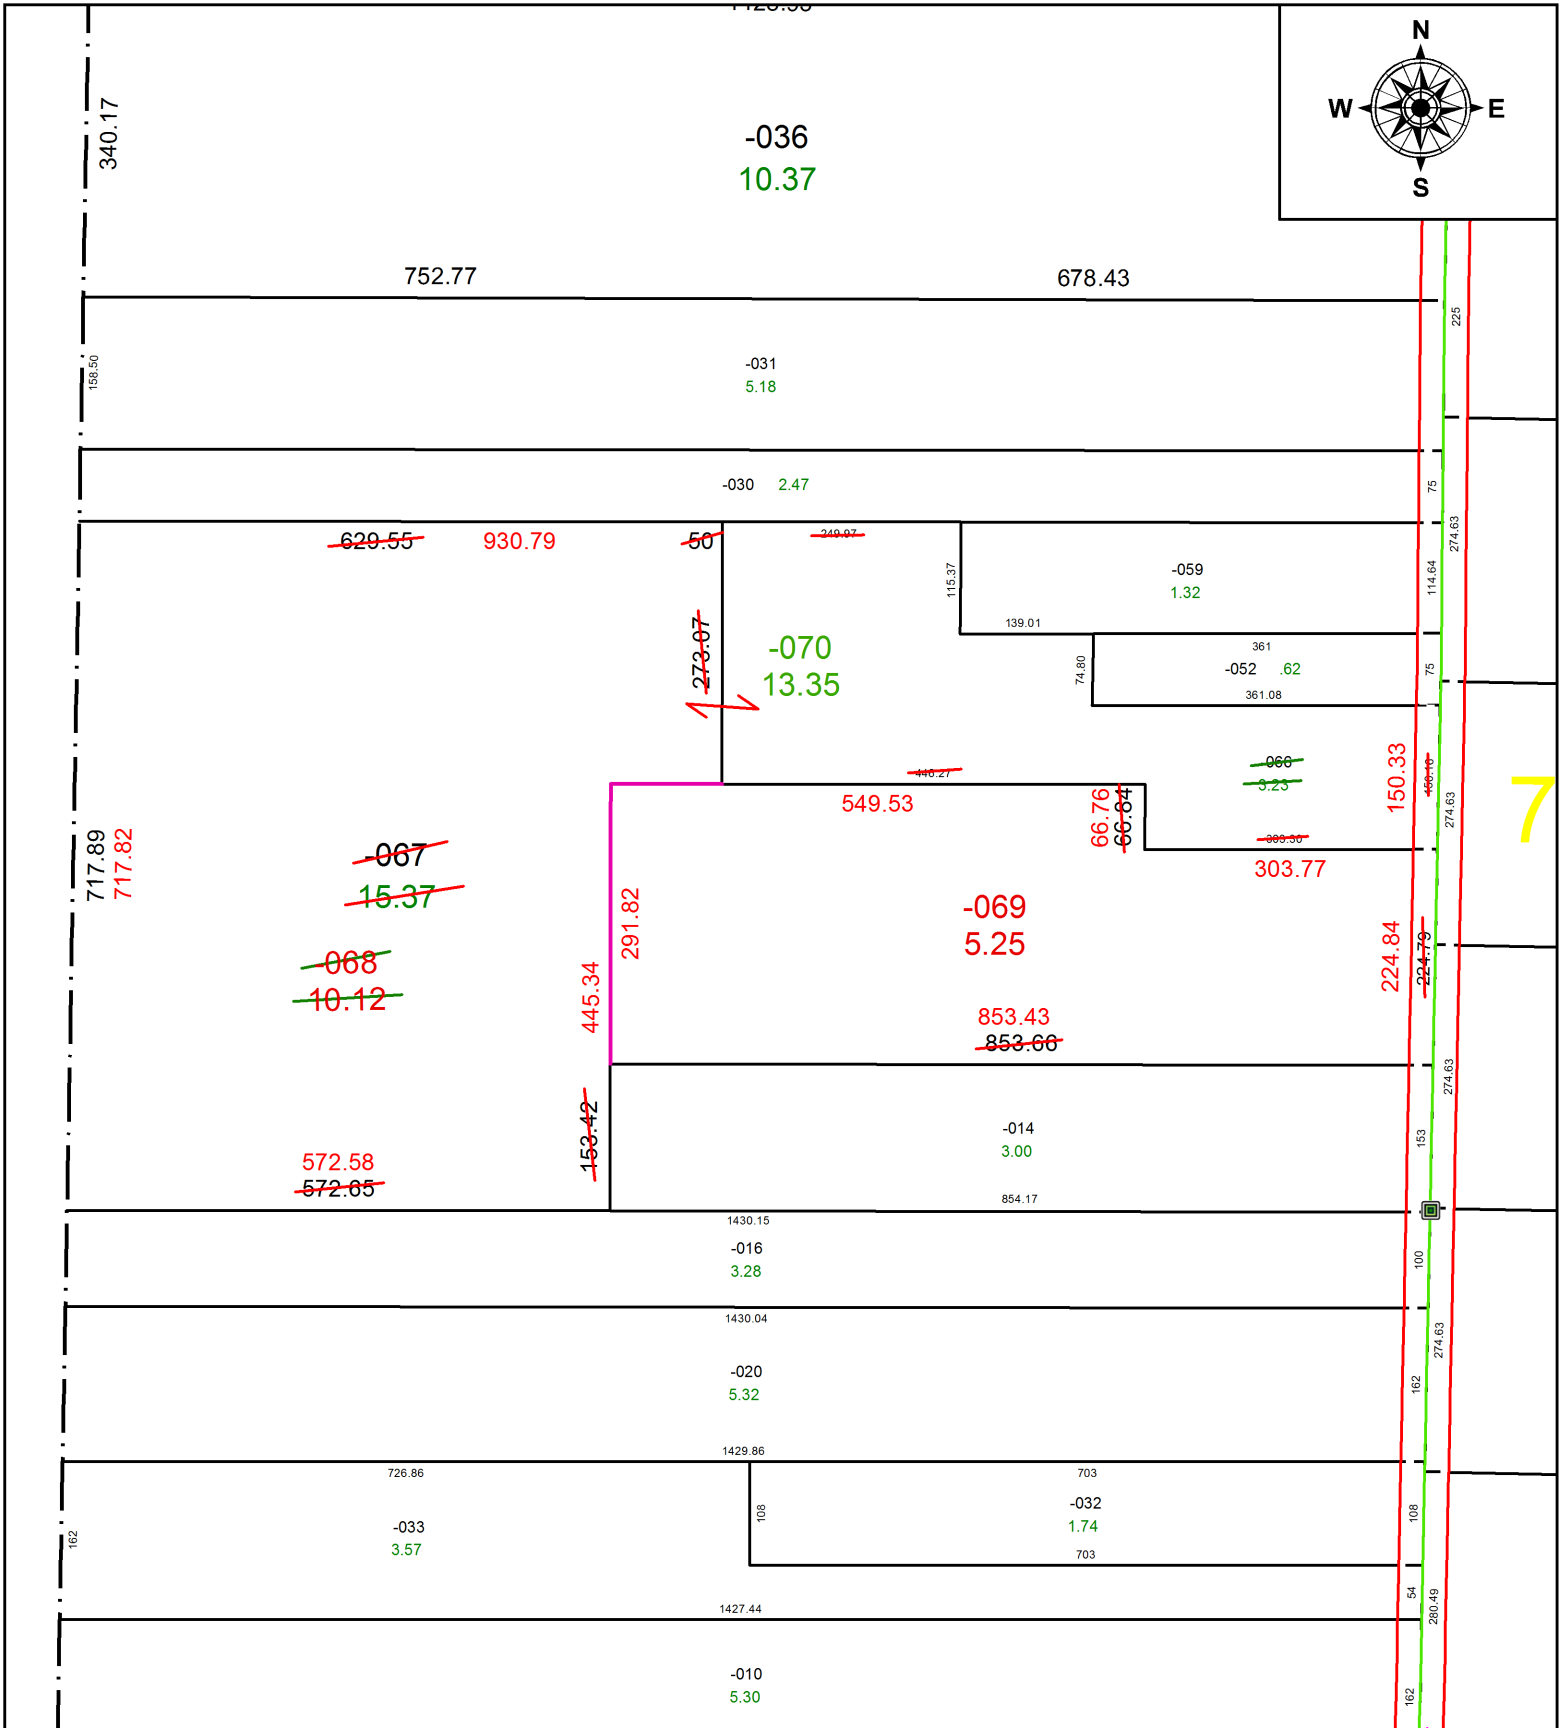

**SPLITS/DEEDS PROCESSED**  
 LORAIN COUNTY TAX MAP DEPARTMENT  
 226 MIDDLE AVE. ELYRIA, OH

SURVEYED BY: THOMAS A. SIMON

CLOSURE: 1: 65,383

MAP PAGE(S): 5-00-072

APPROVED BY: RRM DATE: 2-28-17

SCALE: 1" = 200 PRIOR INSTRUMENT: 20140524028