


PARENT PARCEL: 06-24-025-102-032

CHILD PARCEL: 06-24-025-102-036, -037

STARTING POINT: NORTH LINE OF COURTLAND ST. AND WEST LINE OF PENFIELD AVE.

17-03647-U

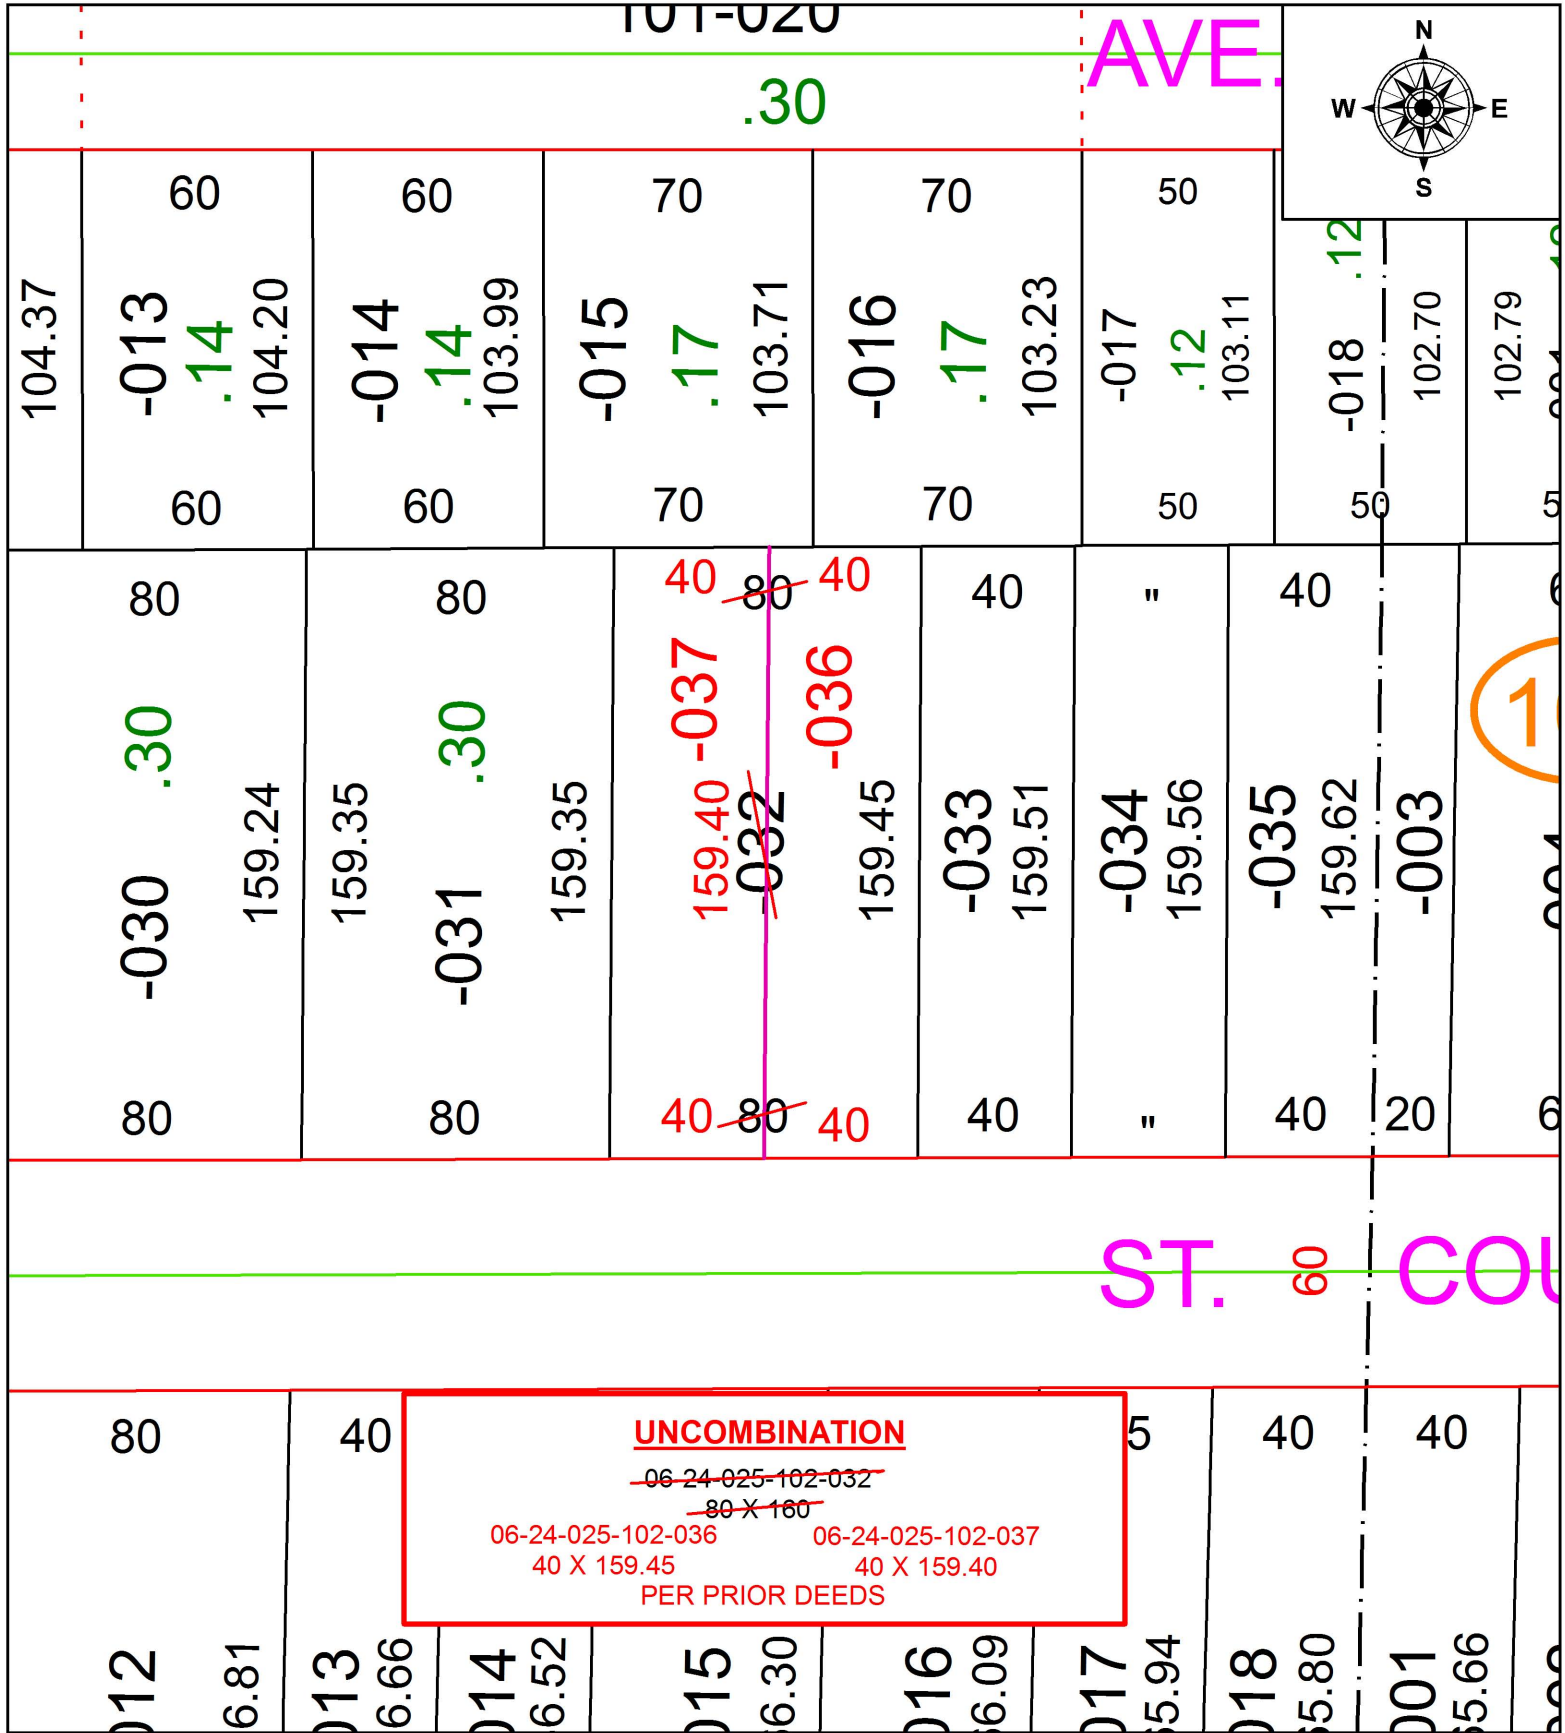

SPLITS/DEEDS PROCESSED
 LORAIN COUNTY TAX MAP DEPARTMENT
 226 MIDDLE AVE. ELYRIA, OH

SURVEYED BY: _____ N/A
 CLOSURE: _____ N/A
 MAP PAGE(S): _____ 6-78
 APPROVED BY: _____ RRM DATE: _____ 4-7-17
 SCALE: _____ 1" = 50 _____ PRIOR INSTRUMENT: _____ 20110390419