


PARENT PARCEL: 18-00-025-000-006, -007, 002, 005, 004

CHILD PARCEL: 18-00-025-000-008, -009

STARTING POINT: CENTERLINE OF JONES RD & ST RT 58


17-03647

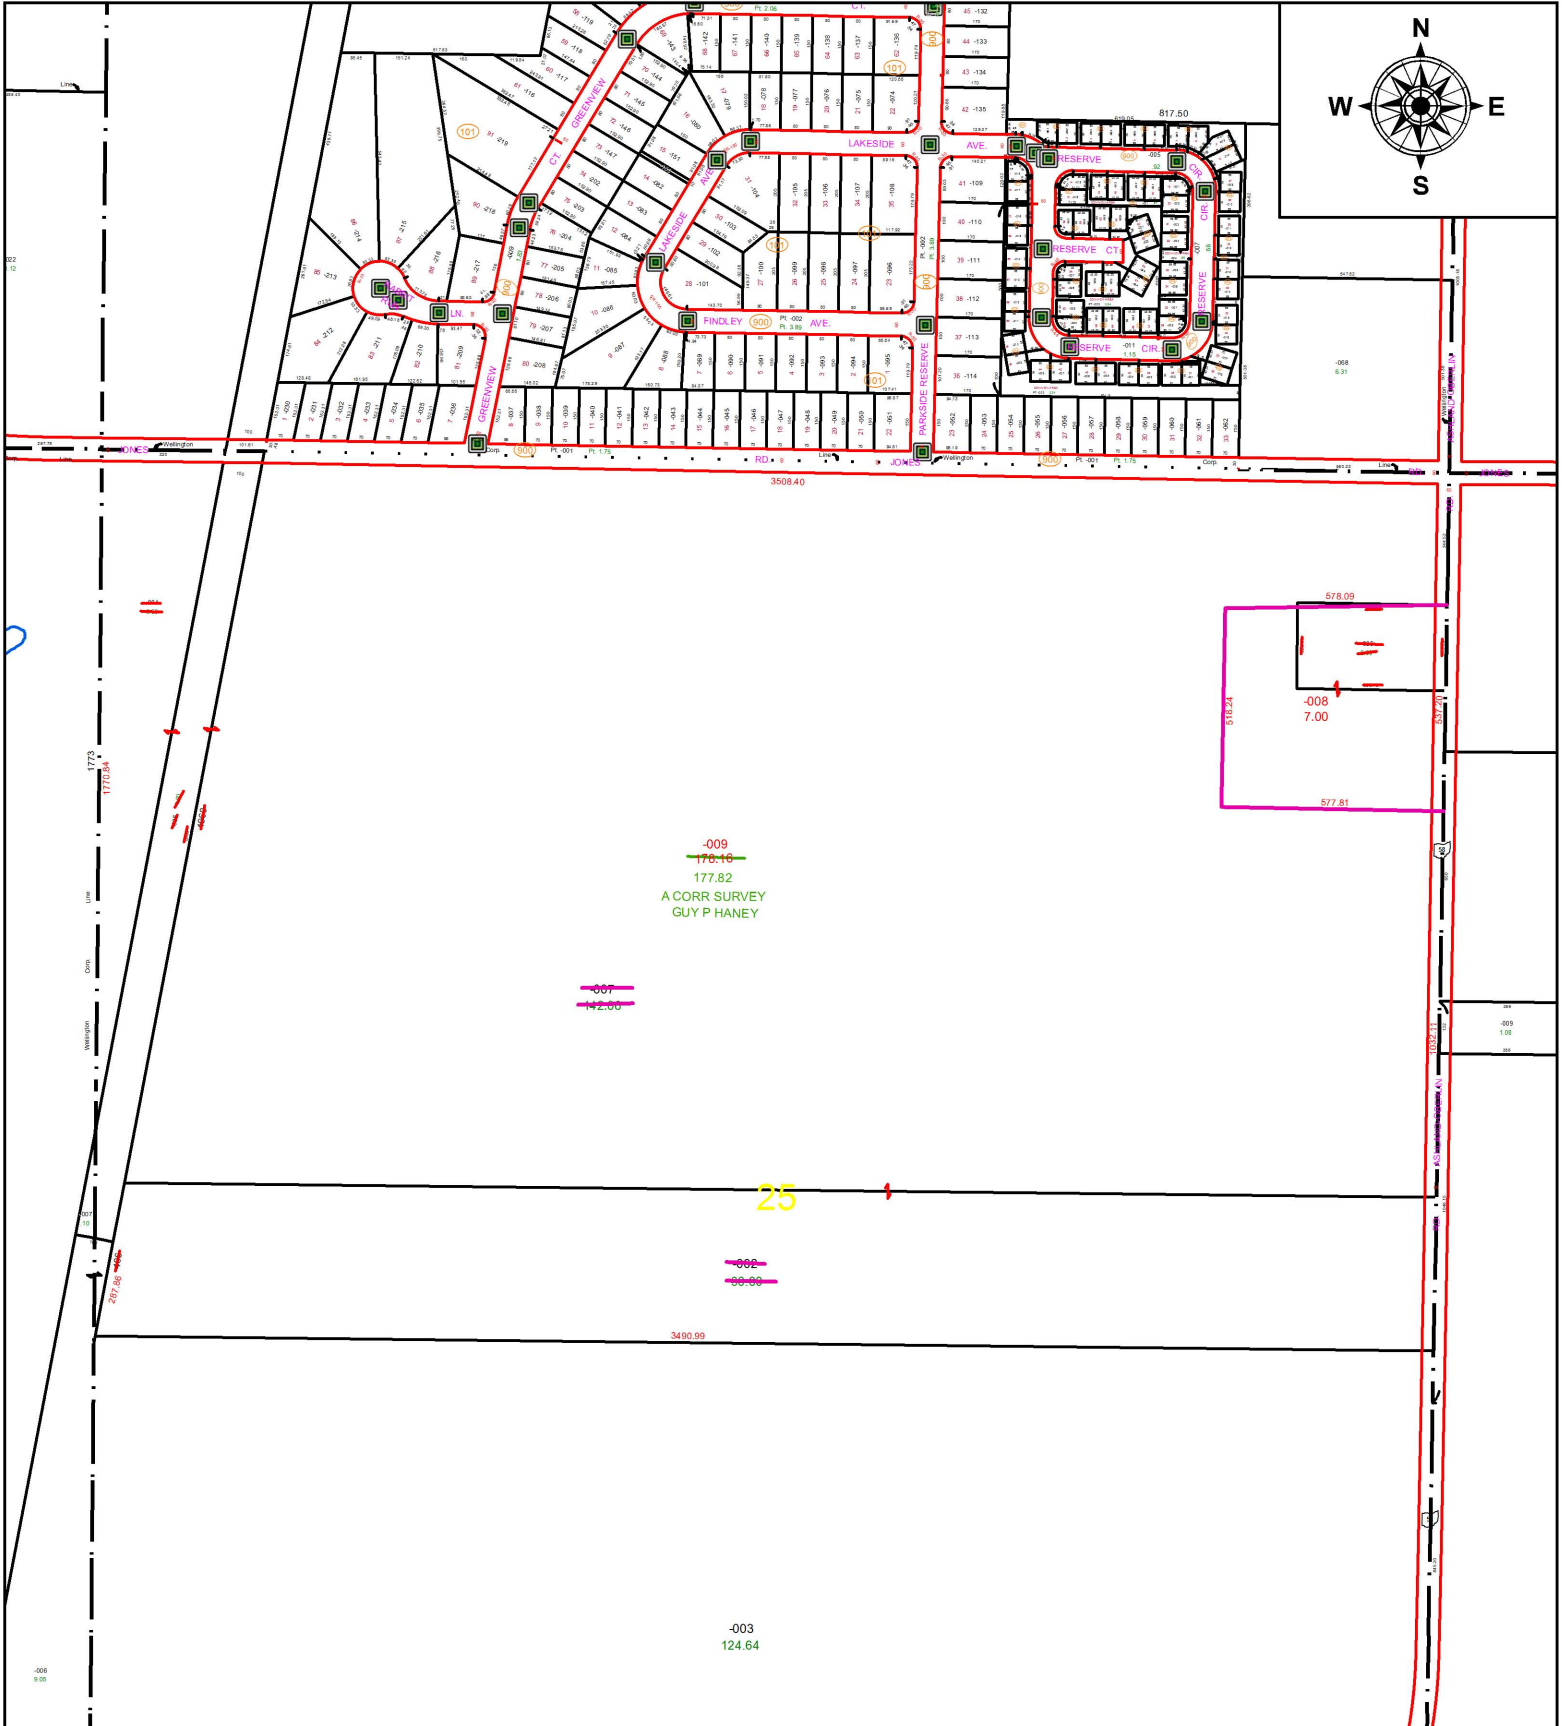

-009
176.16
177.82
A CORR SURVEY
GUY P HANEY

-007
142.00

-003
124.64

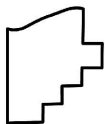

SPLITS/DEEDS PROCESSED
LORAIN COUNTY TAX MAP DEPARTMENT
226 MIDDLE AVE. ELYRIA, OH

SURVEYED BY: GUY P HANEY

CLOSURE: 1: 33,000

MAP PAGE(S): 18-00-025

APPROVED BY: JAH DATE: 7/8/2017

SCALE: 1 in = 500 ft PRIOR INSTRUMENT: 20020827175