
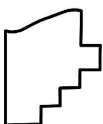


PARENT PARCEL: 09-00-048-000-008

CHILD PARCEL: 09-00-048-000-009, -010, -011

STARTING POINT: NORTHWESTERLY CORNER OF O.L. 48 & CENTERLINE OF OBERLIN RD

17-03648

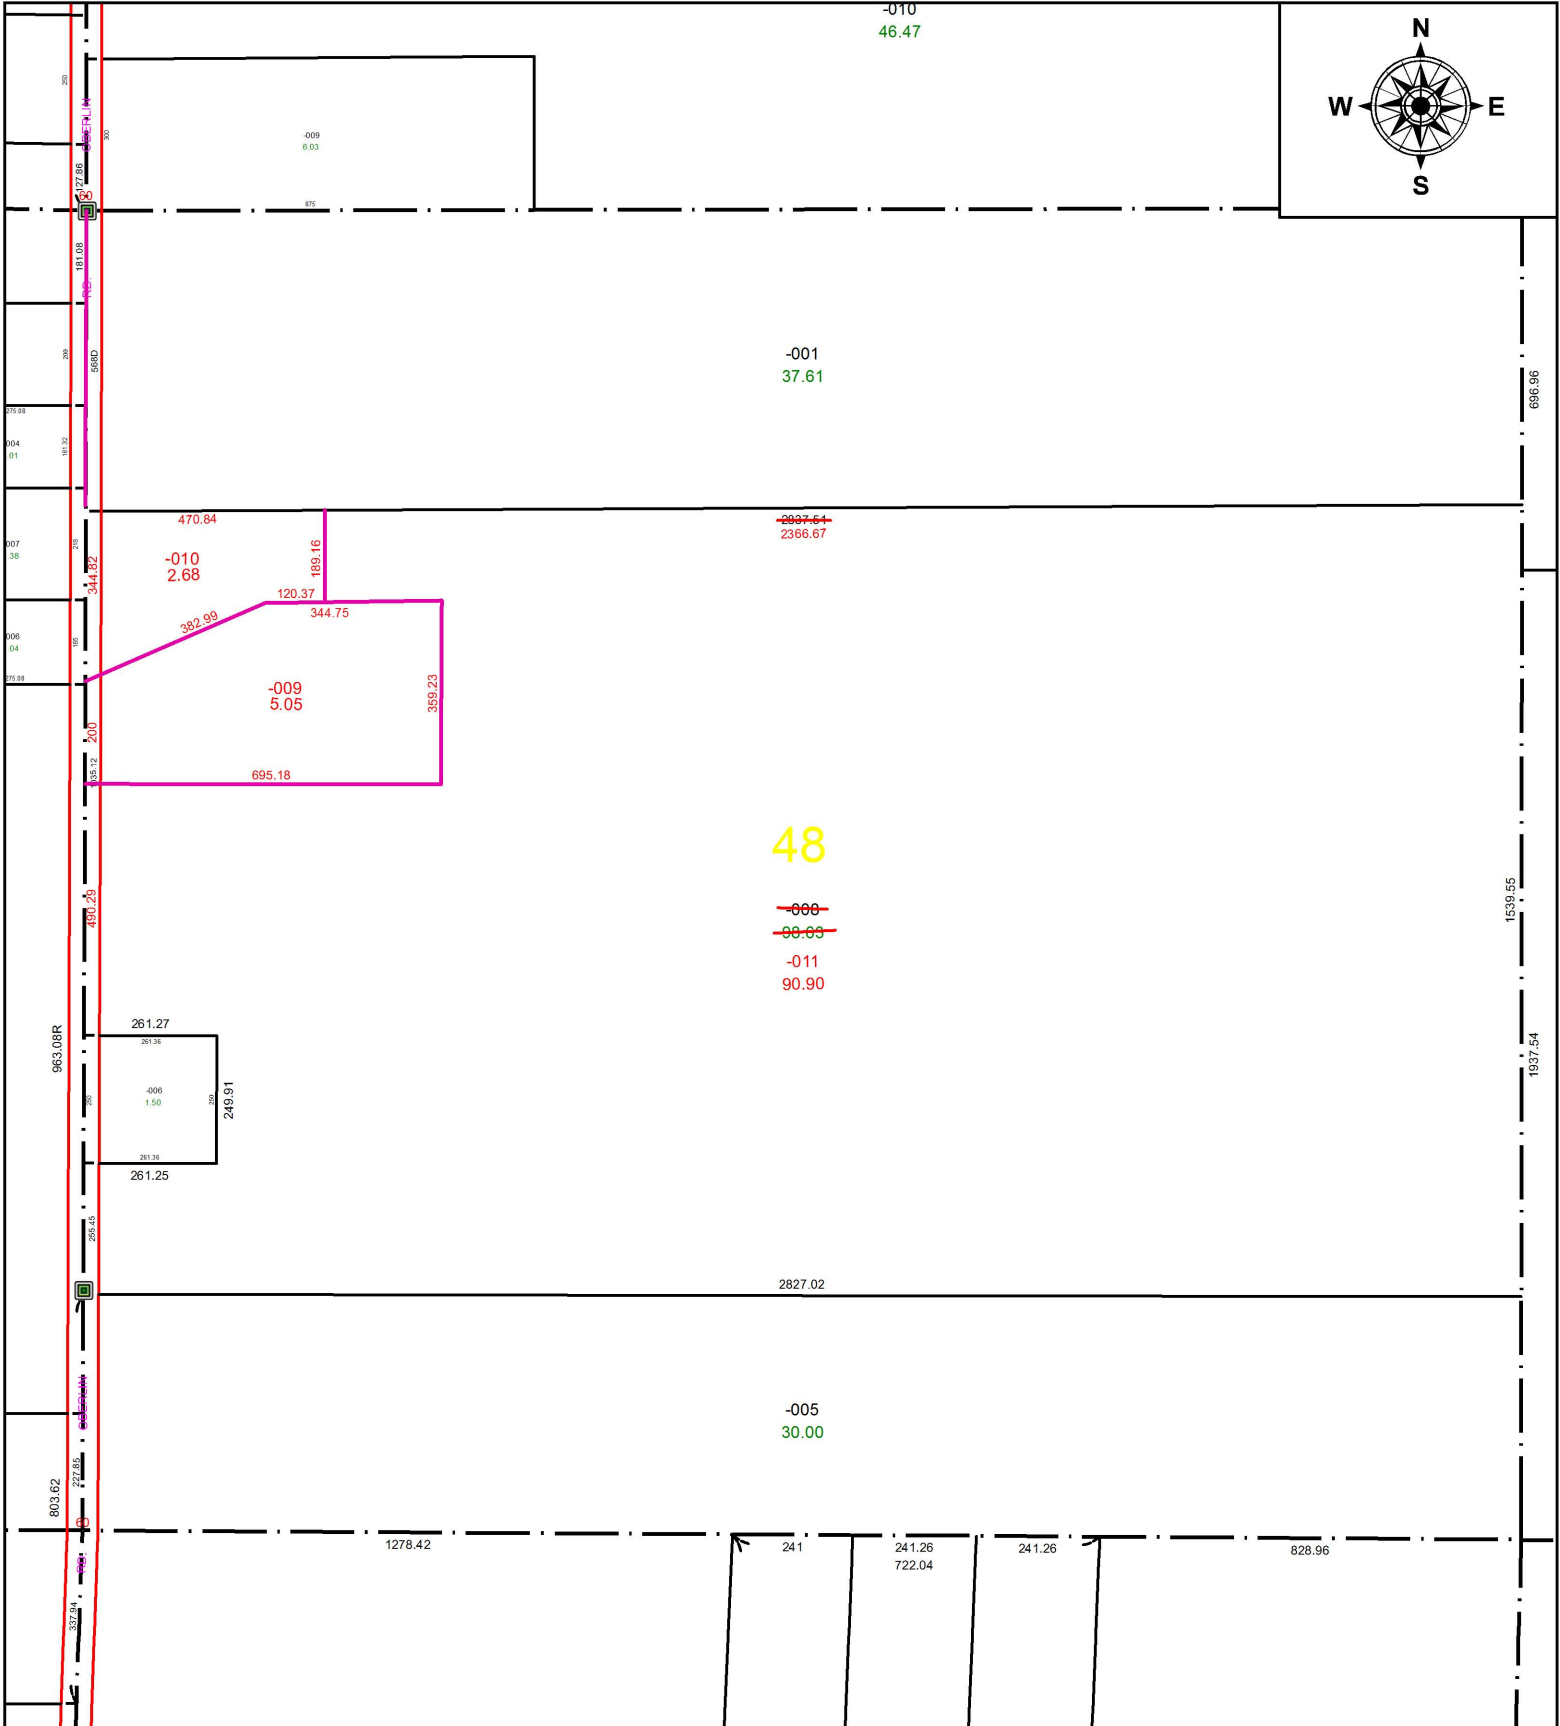

**SPLITS/DEEDS PROCESSED**  
 LORAIN COUNTY TAX MAP DEPARTMENT  
 226 MIDDLE AVE. ELYRIA, OH

SURVEYED BY: RICHARD CARLSON  
 CLOSURE: 1:303879  
 MAP PAGE(S): 09-00-048  
 APPROVED BY: JAH DATE: 3/9/2017  
 SCALE: 1 in = 375 ft PRIOR INSTRUMENT: 20070234834