


PARENT PARCEL: 03-00-043-109-002


CHILD PARCEL: 03-00-043-109-043, -044

STARTING POINT: S/L 235 AND NORTHERLY 20 FT OF S/L 234 IN LAKEWOOD BEACH SUB.

17-03649-U

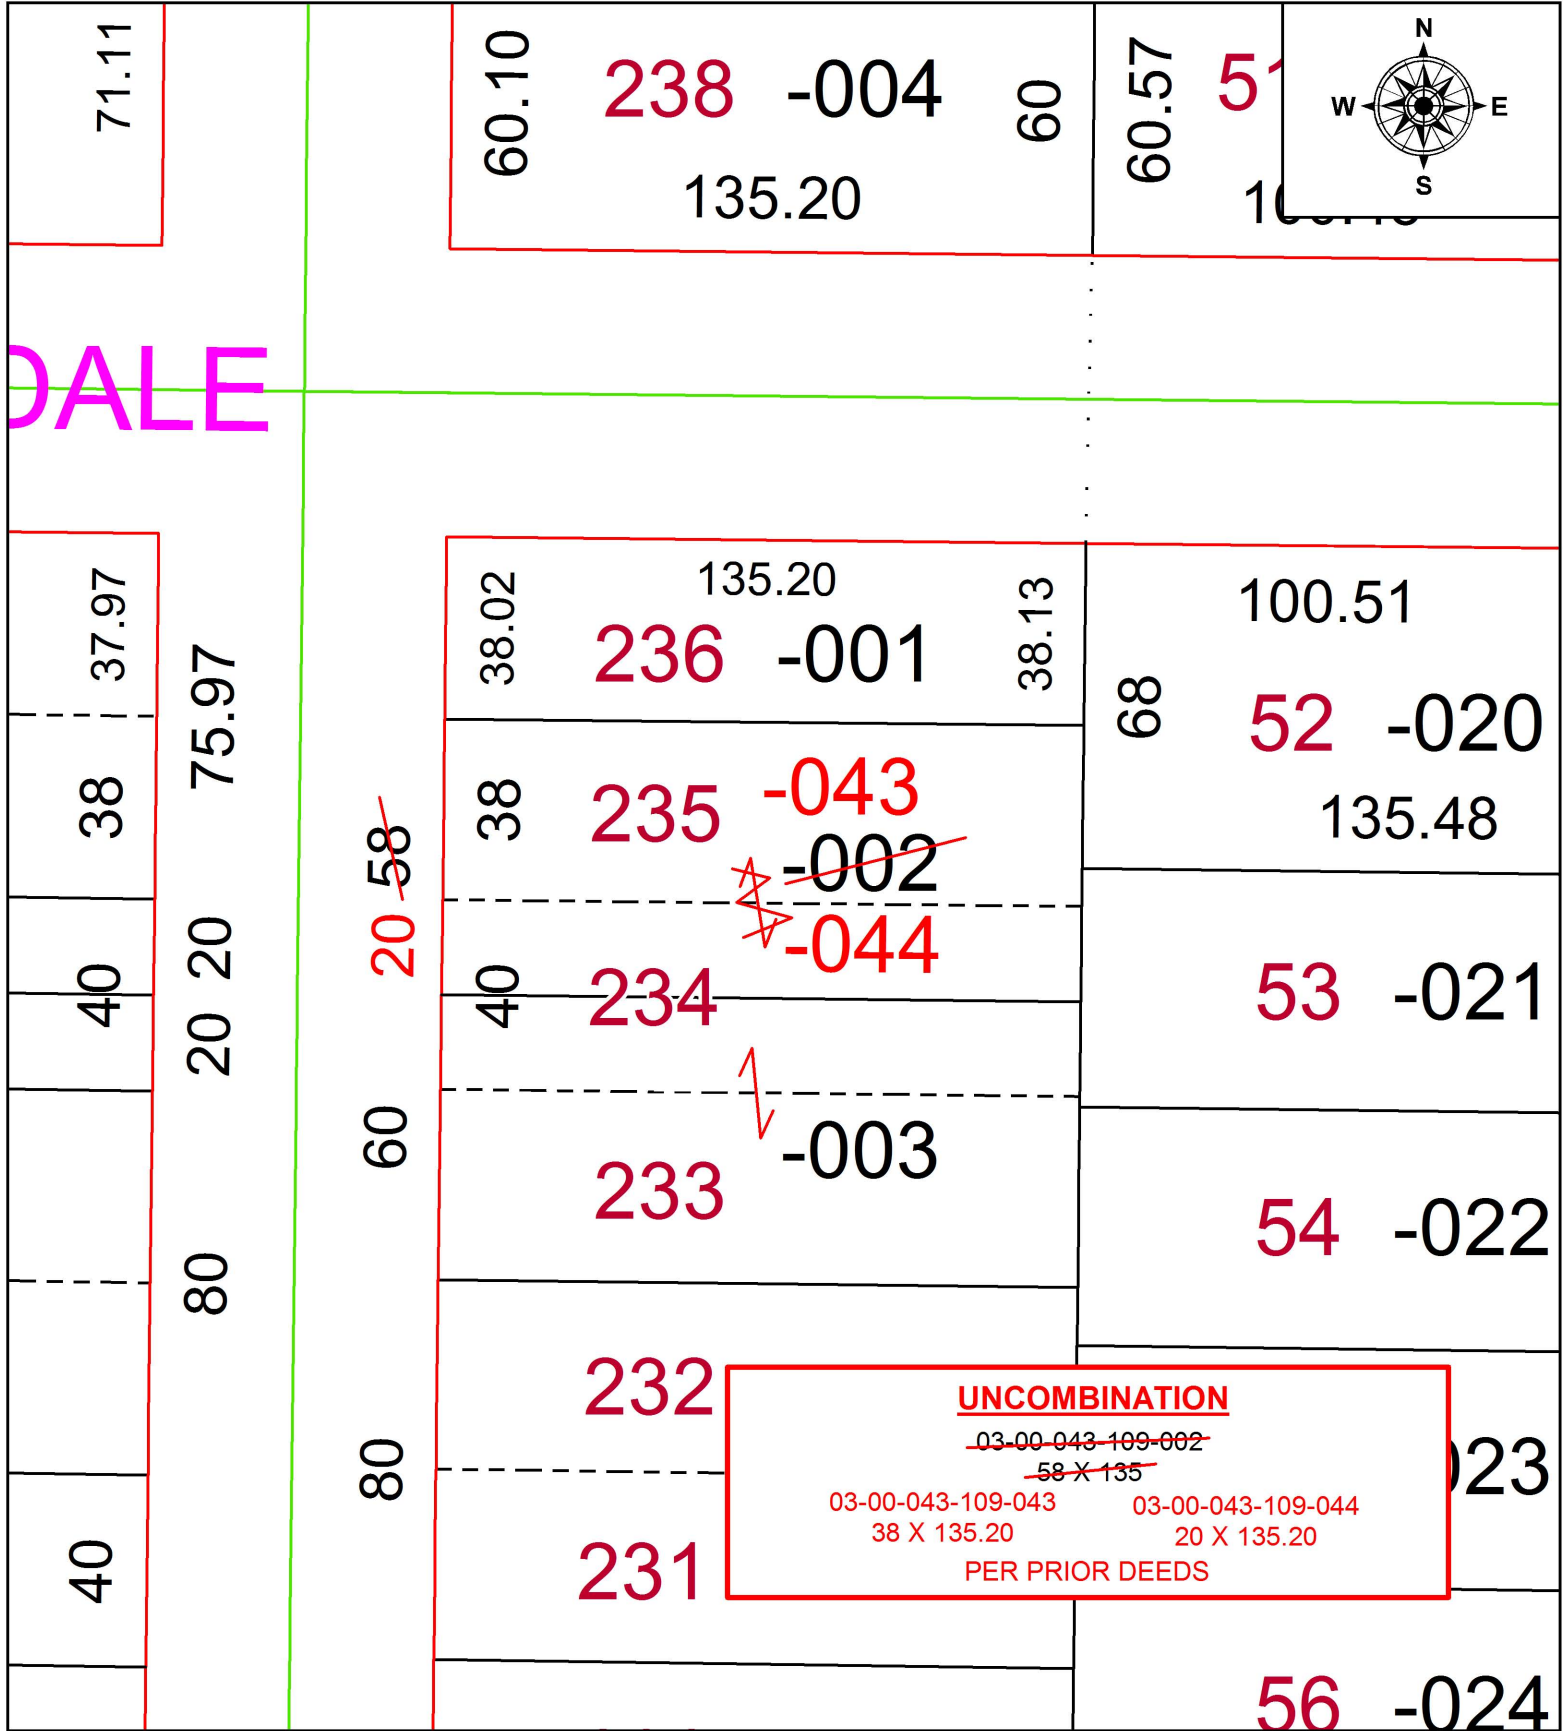

DALE

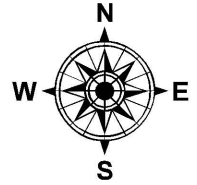

SPLITS/DEEDS PROCESSED
LORAIN COUNTY TAX MAP DEPARTMENT
226 MIDDLE AVE. ELYRIA, OH

SURVEYED BY: _____ N/A

CLOSURE: _____ N/A

MAP PAGE(S): _____ 3-00-043

APPROVED BY: _____ RRM DATE: _____ 4-11-17

SCALE: _____ 1" = 40 PRIORITY INSTRUMENT: _____ 20130472349