


PARENT PARCEL: 06-24-005-000-008, -029

CHILD PARCEL: 06-24-005-000-056

STARTING POINT: CENTERLINE OF MURRAY RIDGE RD & OL 5

17-03654

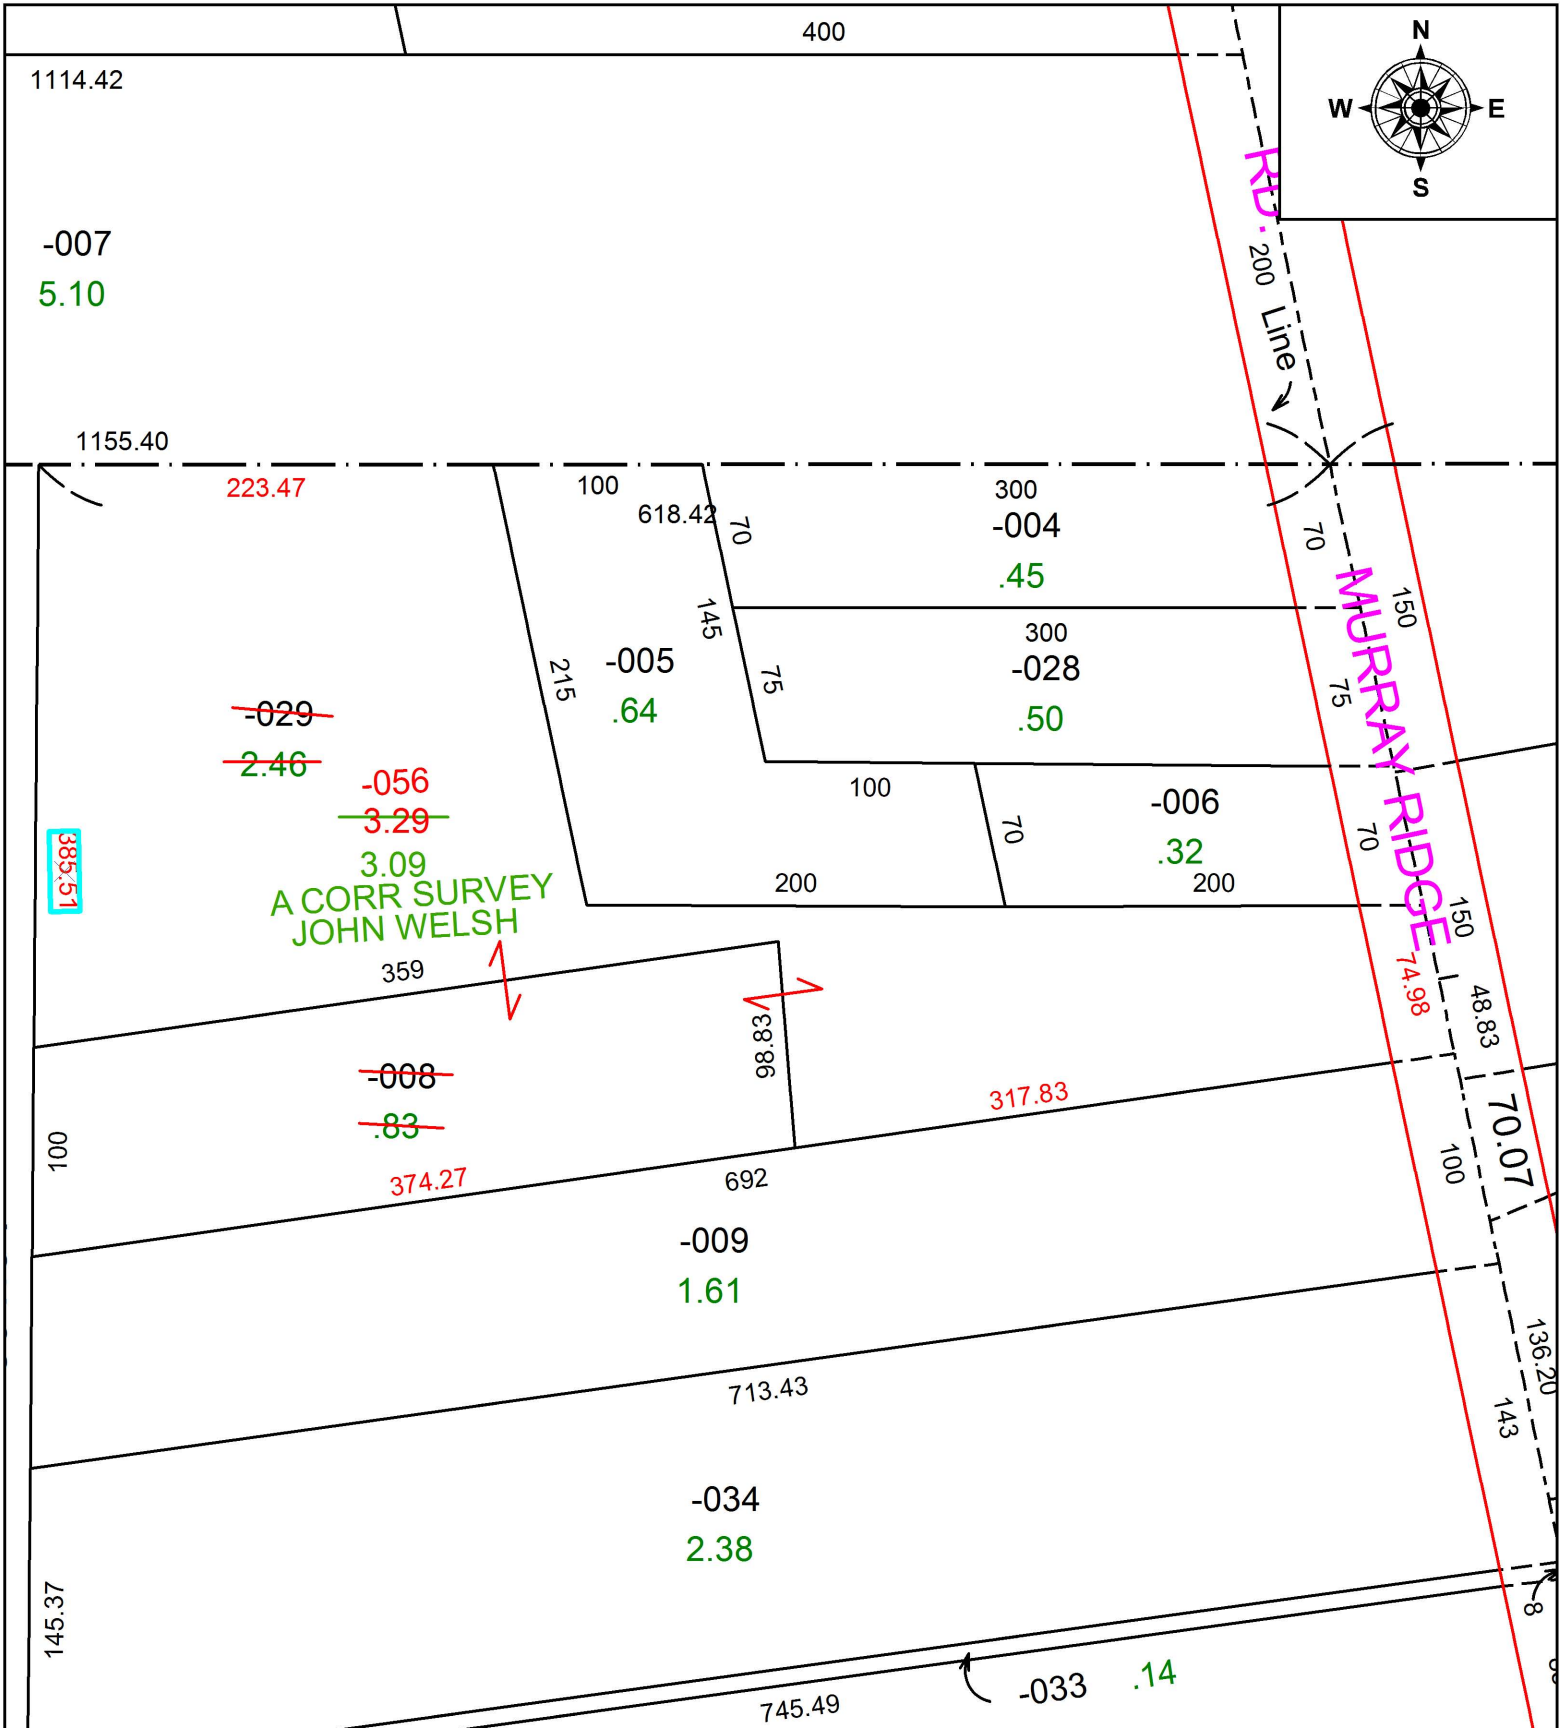

**SPLITS/DEEDS PROCESSED**  
 LORAIN COUNTY TAX MAP DEPARTMENT  
 226 MIDDLE AVE. ELYRIA, OH

SURVEYED BY: JOHN WELSH  
 CLOSURE: 1: 33,000  
 MAP PAGE(S): 06-24-005  
 APPROVED BY: JAH DATE: 4/4/2017  
 SCALE: 1 in = 92 ft PRIOR INSTRUMENT: 20000688162