


PARENT PARCEL: 02-02-020-102-006

CHILD PARCEL: XX-XX-XXX-XXX-XXX

STARTING POINT: INTERSECTION OF C/L OF LAKE SHORE RD. AND WEST LINE OF O.L. 20


17-03655-C

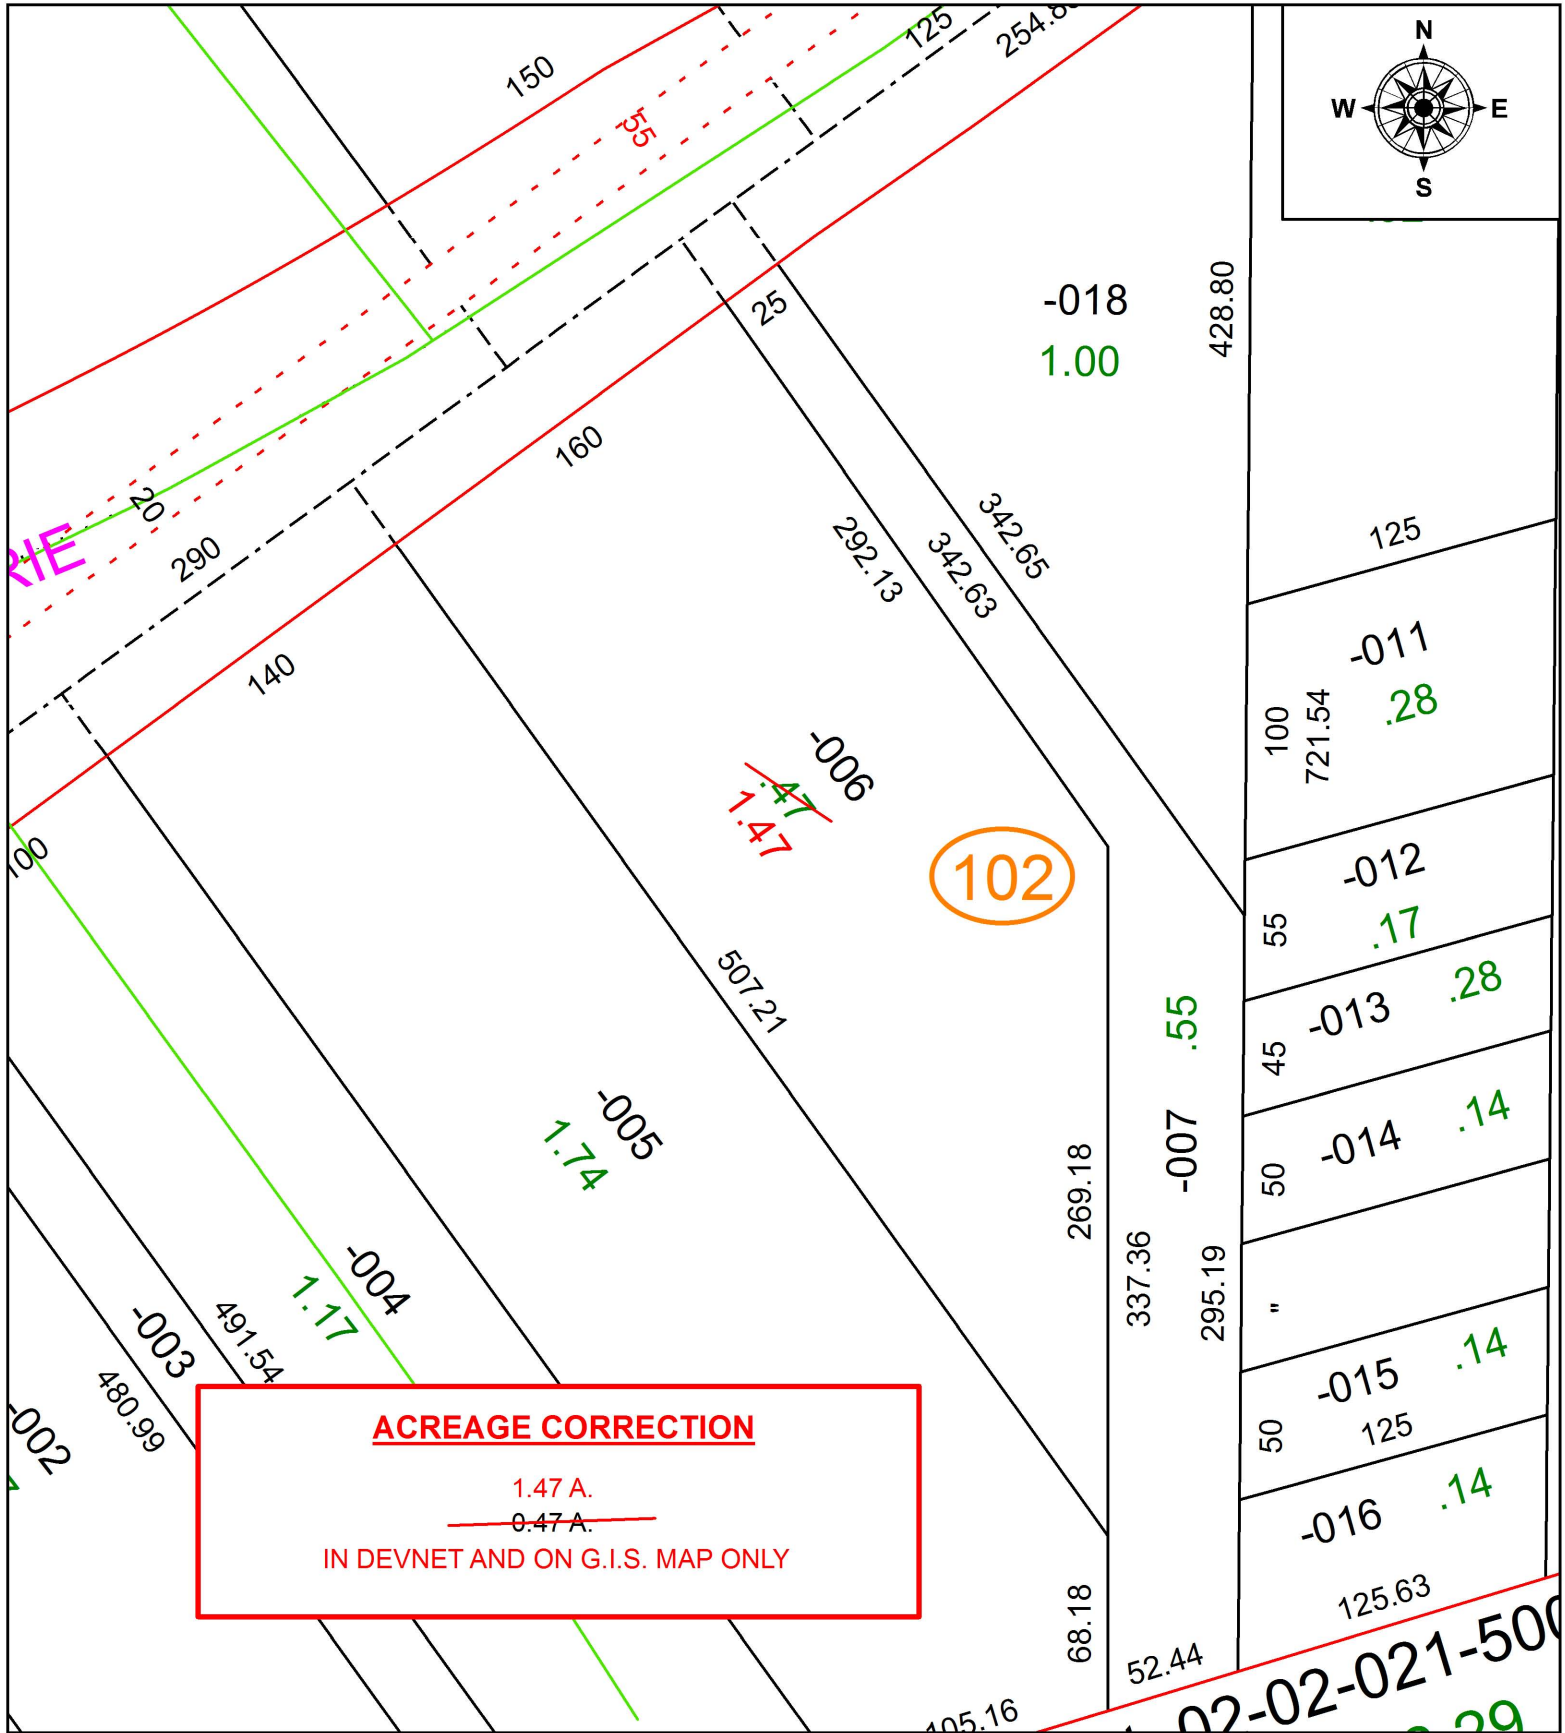

ACREAGE CORRECTION

1.47 A.
~~0.47 A.~~

IN DEVNET AND ON G.I.S. MAP ONLY

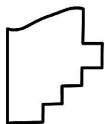

SPLITS/DEEDS PROCESSED
 LORAIN COUNTY TAX MAP DEPARTMENT
 226 MIDDLE AVE. ELYRIA, OH

SURVEYED BY: _____ N/A
 CLOSURE: _____ N/A
 MAP PAGE(S): _____ 2-02-020
 APPROVED BY: _____ RRM DATE: _____ 4-18-17
 SCALE: _____ 1" = 75 PRIOR INSTRUMENT: _____ 20070221517

02-02-021-500