


PARENT PARCEL: 12-00-056-000-020, -033 12-00-065-000-028, -027

CHILD PARCEL: 12-00-056-000-050 THRU -052 12-00-065-000-053

STARTING POINT: CENTERLINE OF COLUMBIA-WEST RIVER RD & FOLLEY RD

17-03655

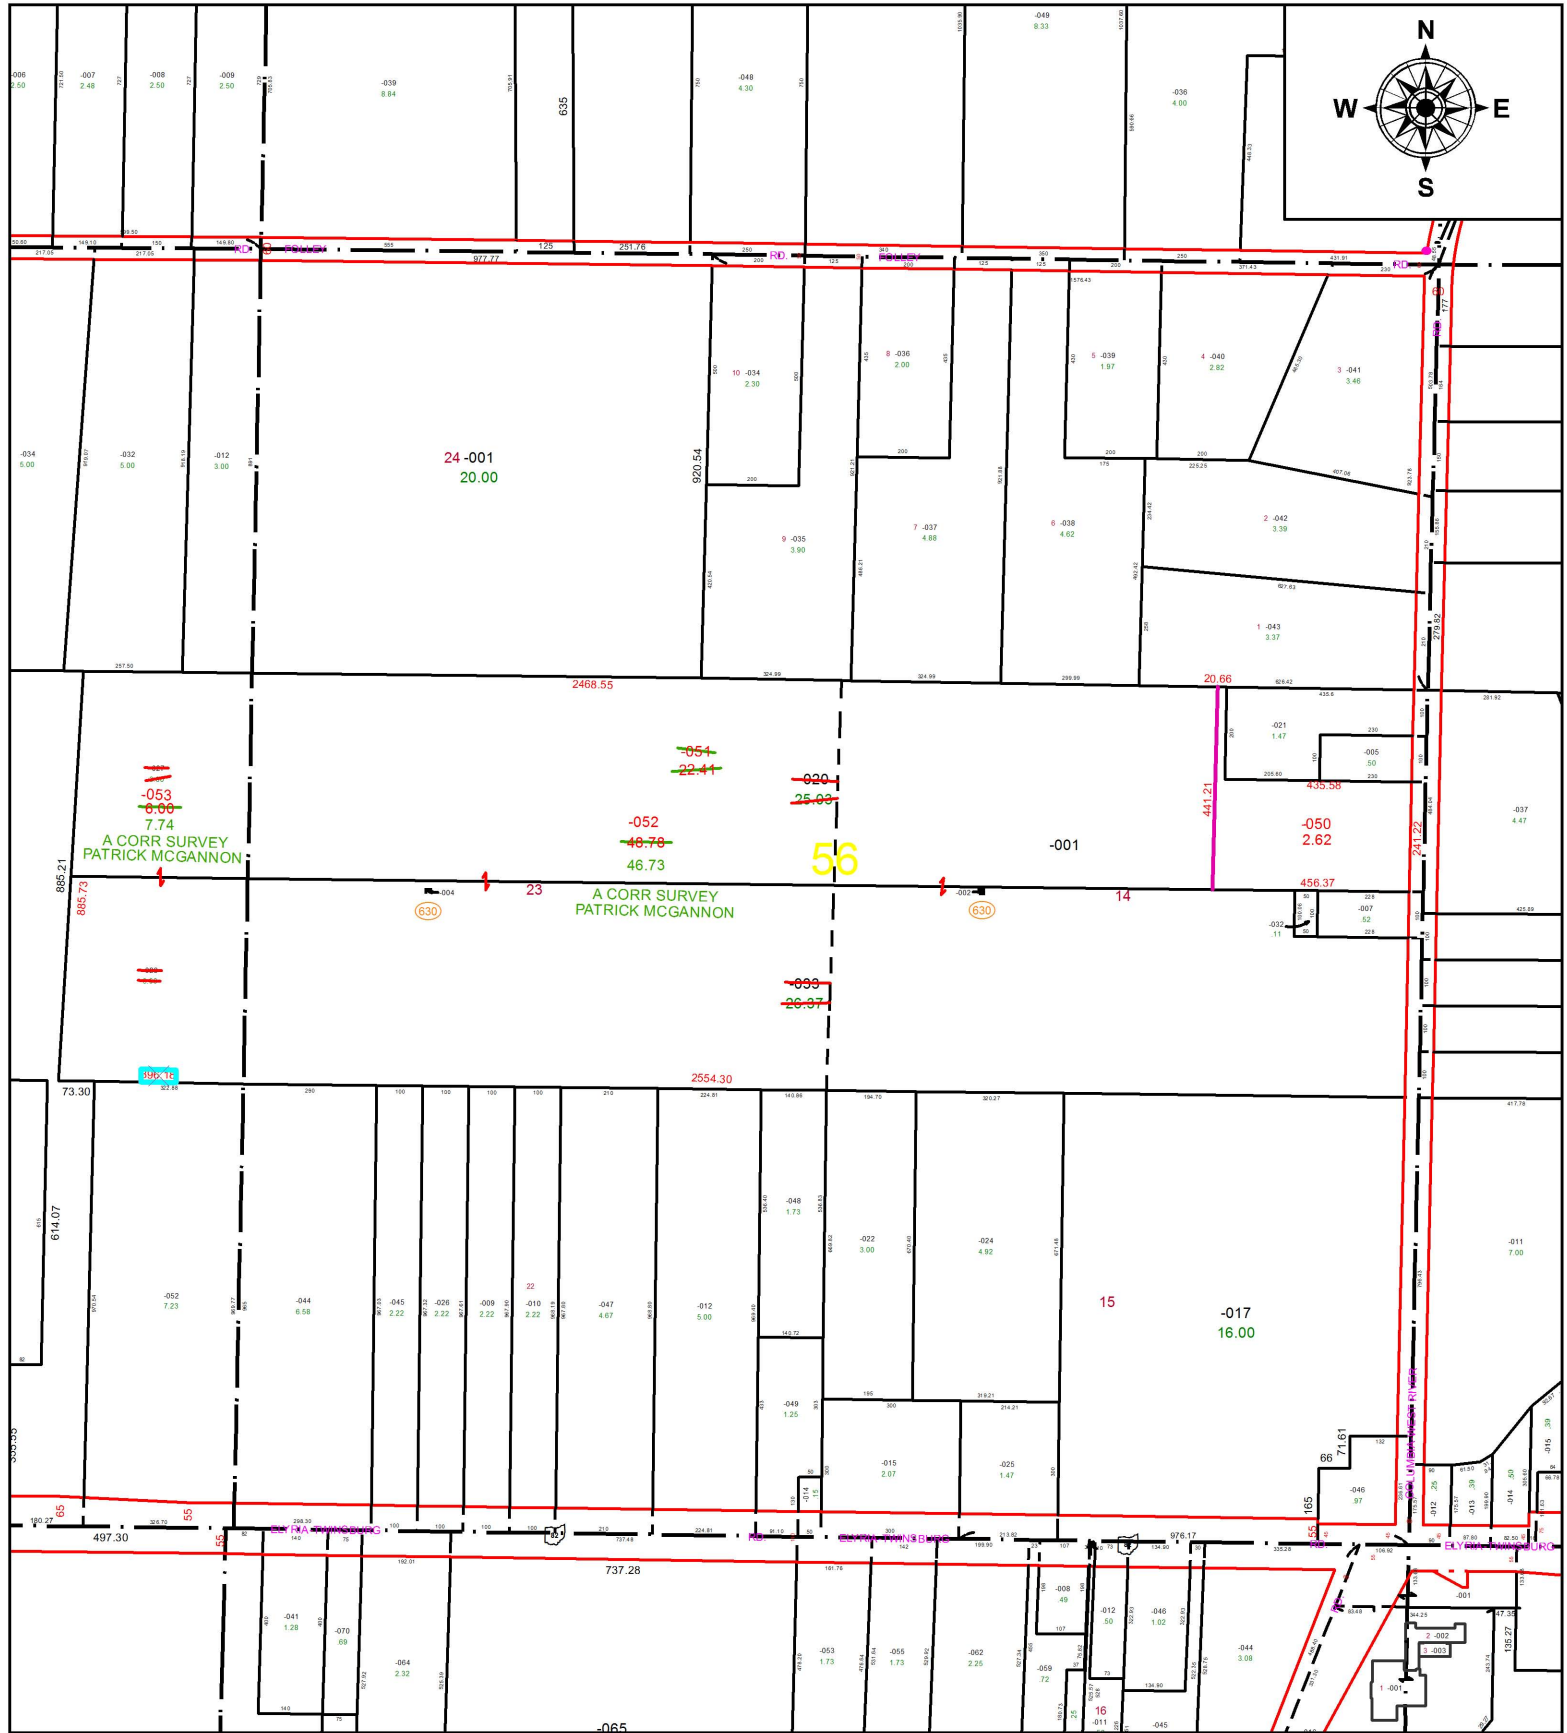

**SPLITS/DEEDS PROCESSED**  
LORAIN COUNTY TAX MAP DEPARTMENT  
226 MIDDLE AVE. ELYRIA, OH

SURVEYED BY: PATRICK MCGANNON

CLOSURE: 1:288236

MAP PAGE(S): 12-00-056

APPROVED BY: JAH DATE: 4/6/2017

SCALE: 1 in = 417 ft PRIOR INSTRUMENT: 20060130769