
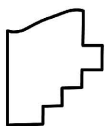


PARENT PARCEL: 01-00-034-000-008

CHILD PARCEL: XX-XX-XXX-XXX-XXX

17-03656-C

STARTING POINT: INTERSECTION OF C/L OF VERMILION RD. AND C/L OF COOPER FOSTER PARK RD.

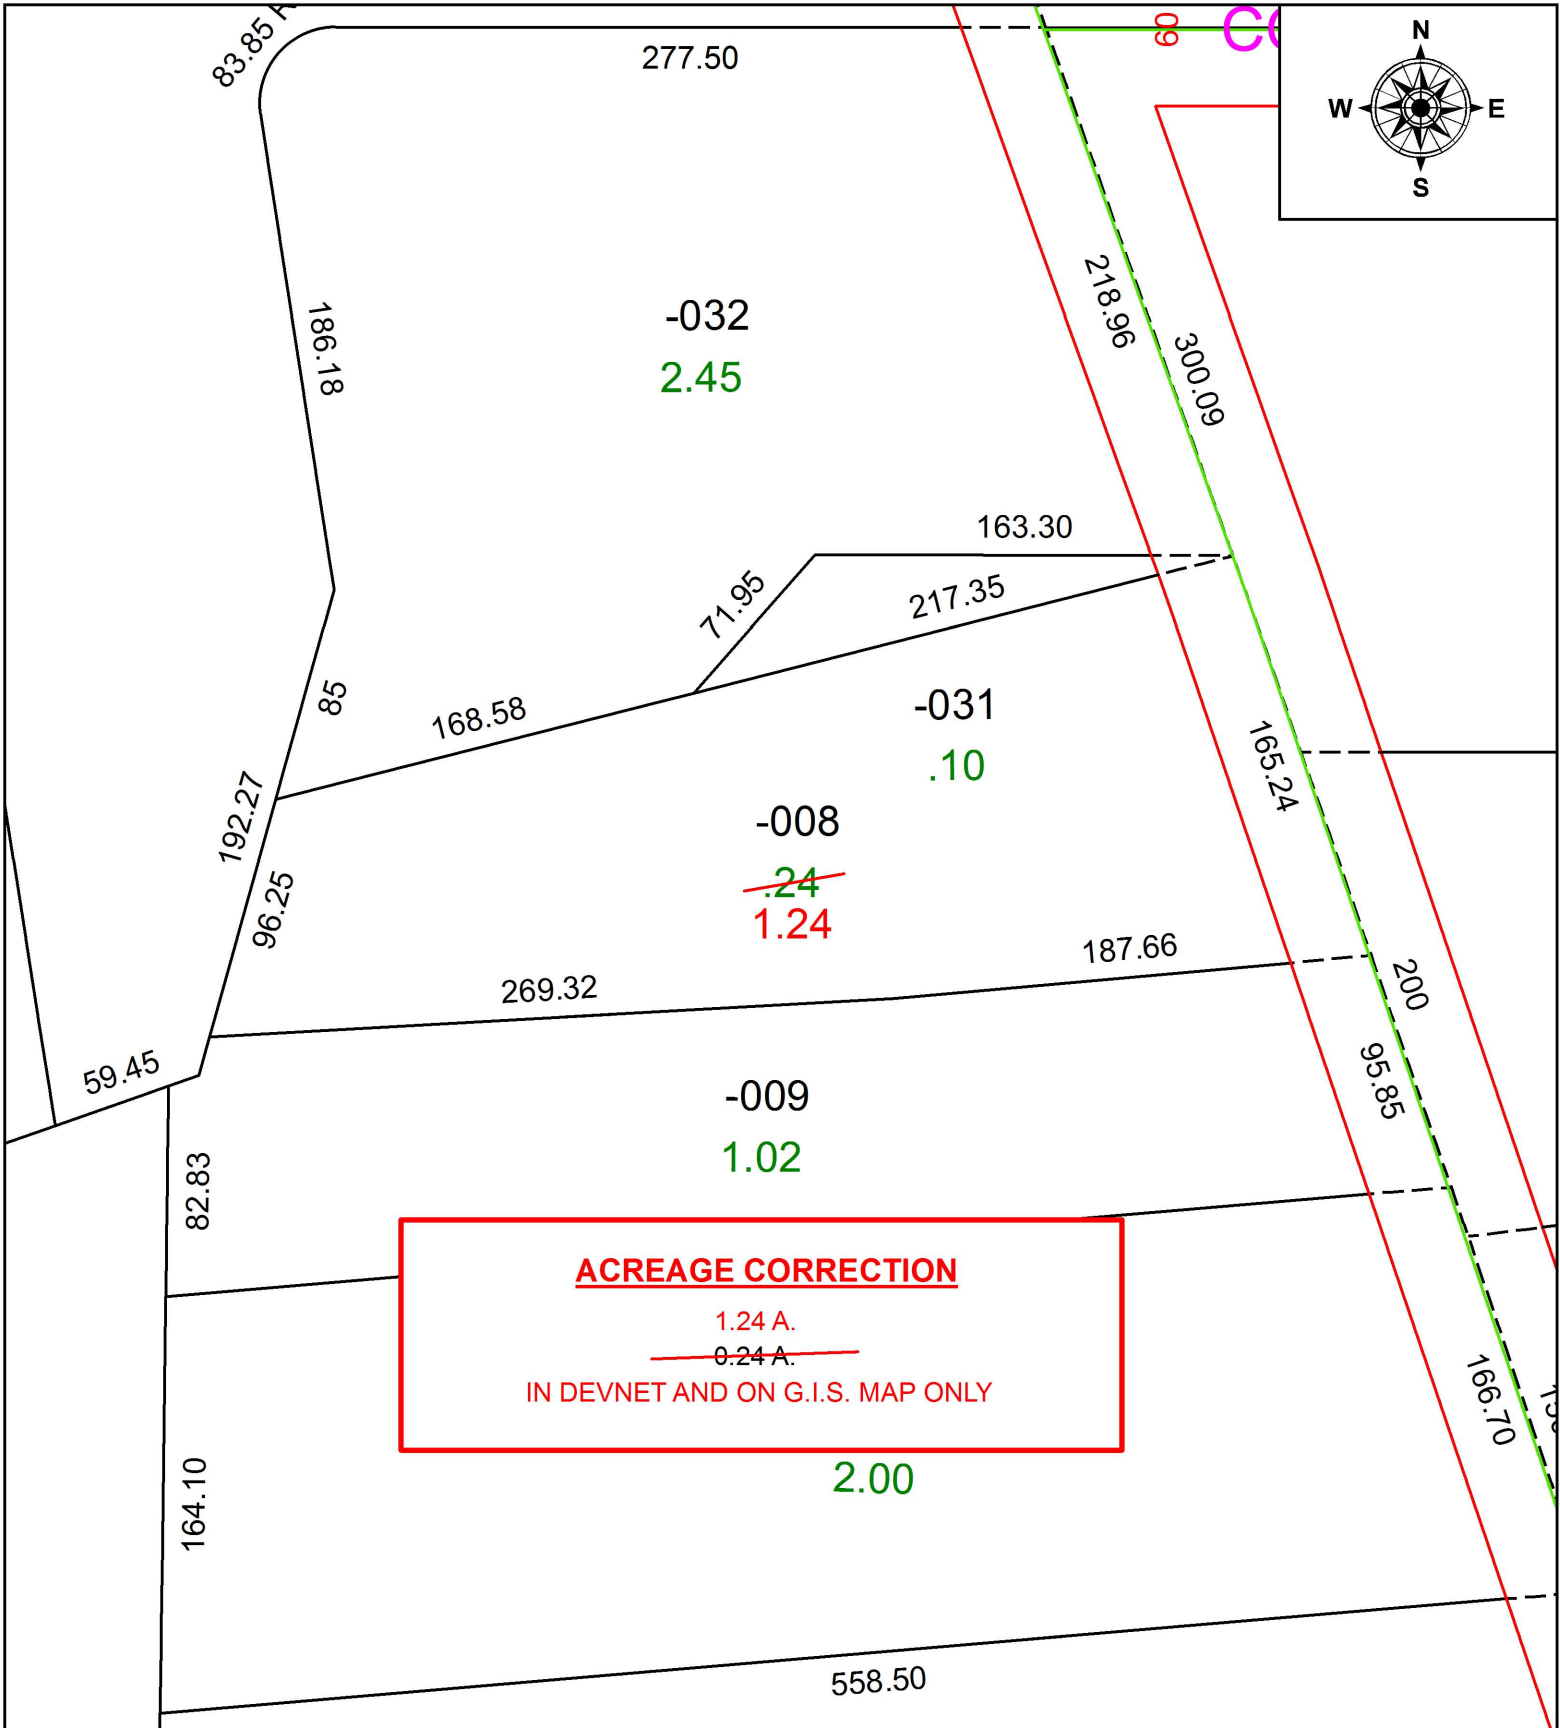

**SPLITS/DEEDS PROCESSED**  
LORAIN COUNTY TAX MAP DEPARTMENT  
226 MIDDLE AVE. ELYRIA, OH

SURVEYED BY:	N/A
CLOSURE:	N/A
MAP PAGE(S):	1-00-034
APPROVED BY:	RRM DATE: 4-18-17
SCALE:	1" = 75' PRIOR INSTRUMENT: 20080267330