
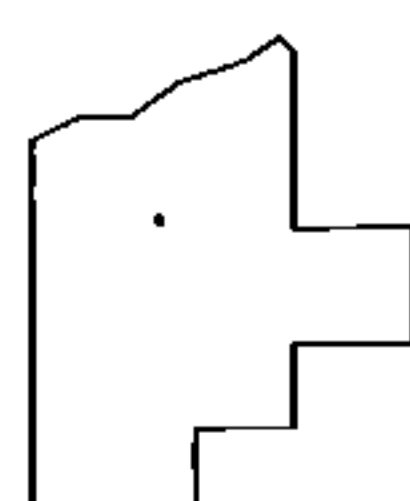
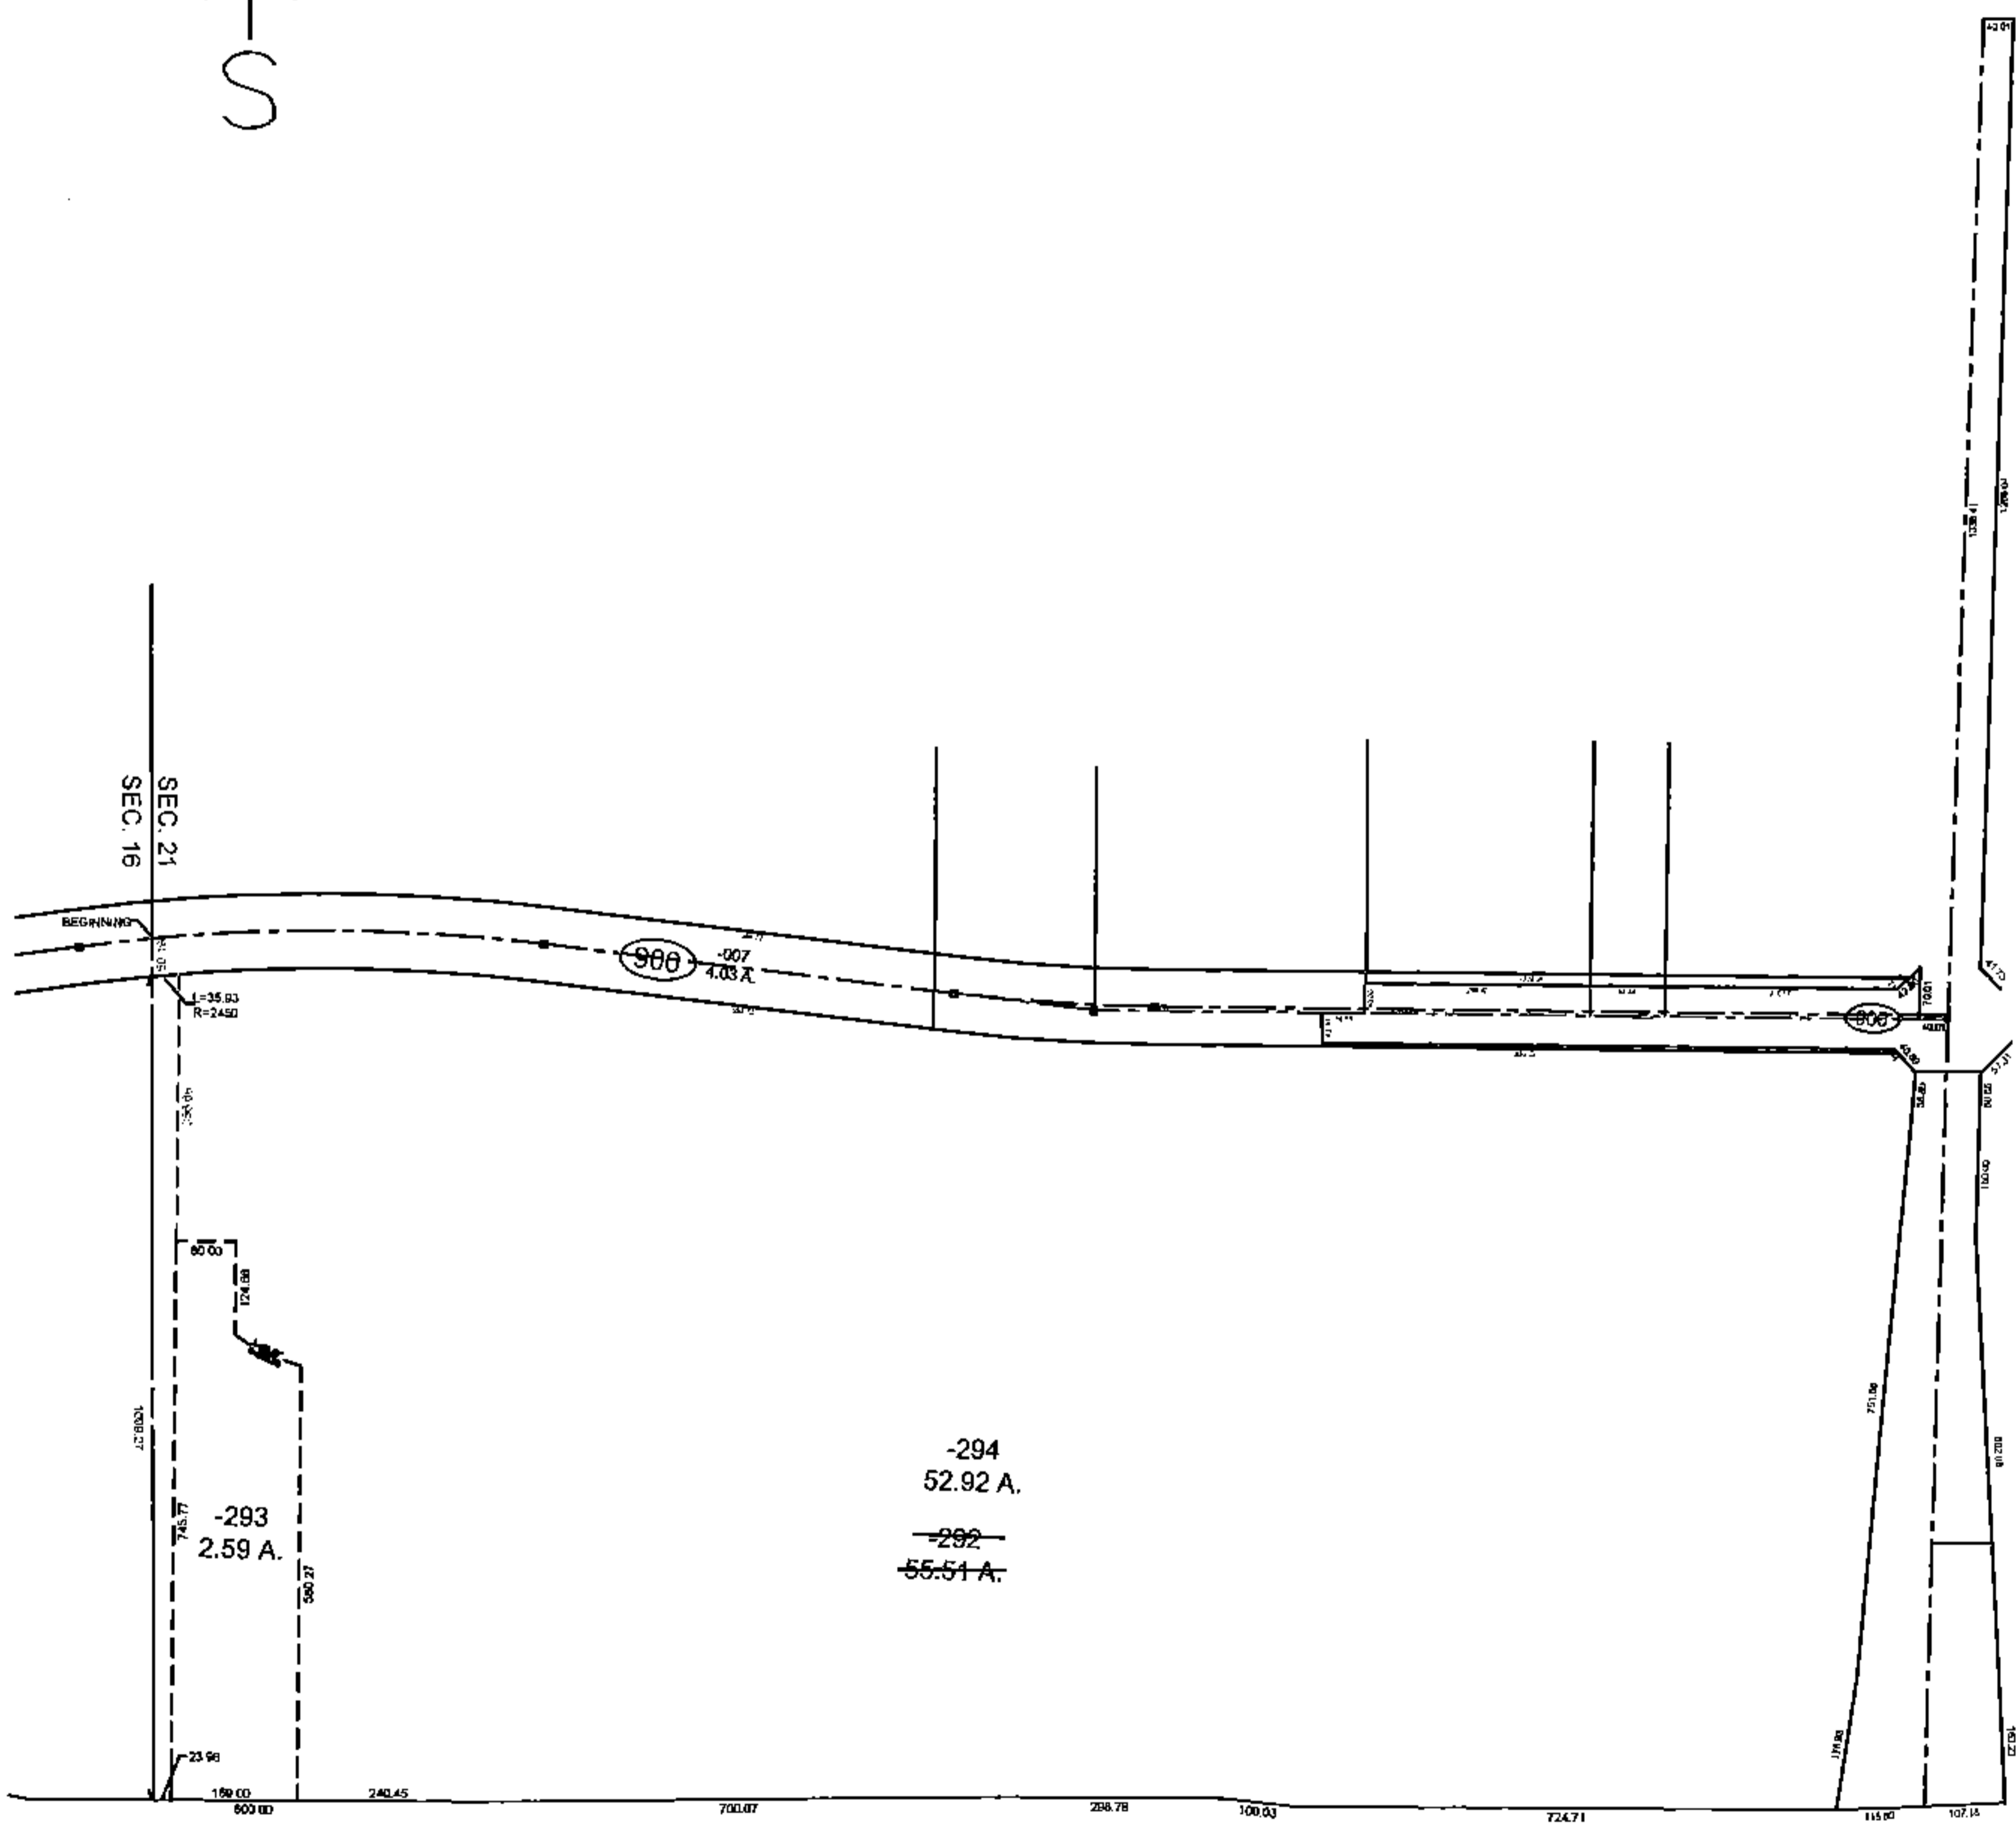


PARENT PARCEL: 04-00-021-000-292  
CHILD PARCEL: 04-00-021-000-293 & -294  
STARTING POINT: CL OF CHESTER RD. & WEST LINE OF SECTION 21

17-03656

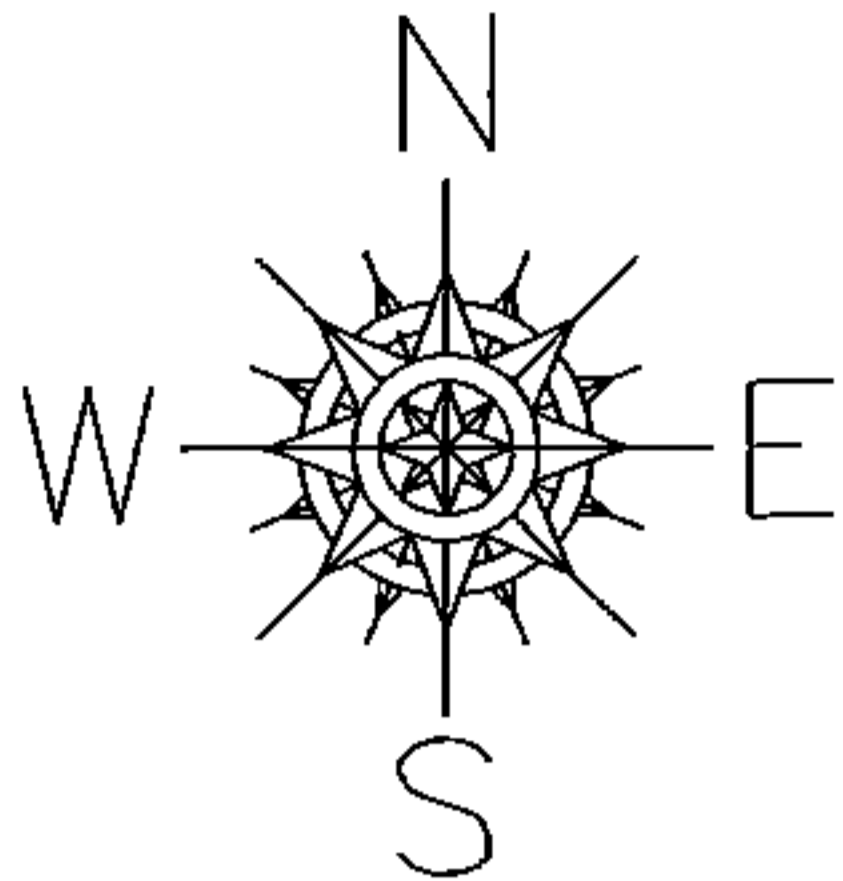

**SPLITS/DEEDS PROCESSED**  
LORAIN COUNTY TAX MAP DEPARTMENT  
226 MIDDLE AVE. ELYRIA, OHIO

SURVEYED BY: AMY M. KELLY  
CLOSURE: 1: 525701.73  
MAP PAGE(S): 4-00-021  
APPROVED BY: TJS DATE: 4/10/17  
SCALE: 1"= 400 PRIOR INSTRUMENT: 20080256715