

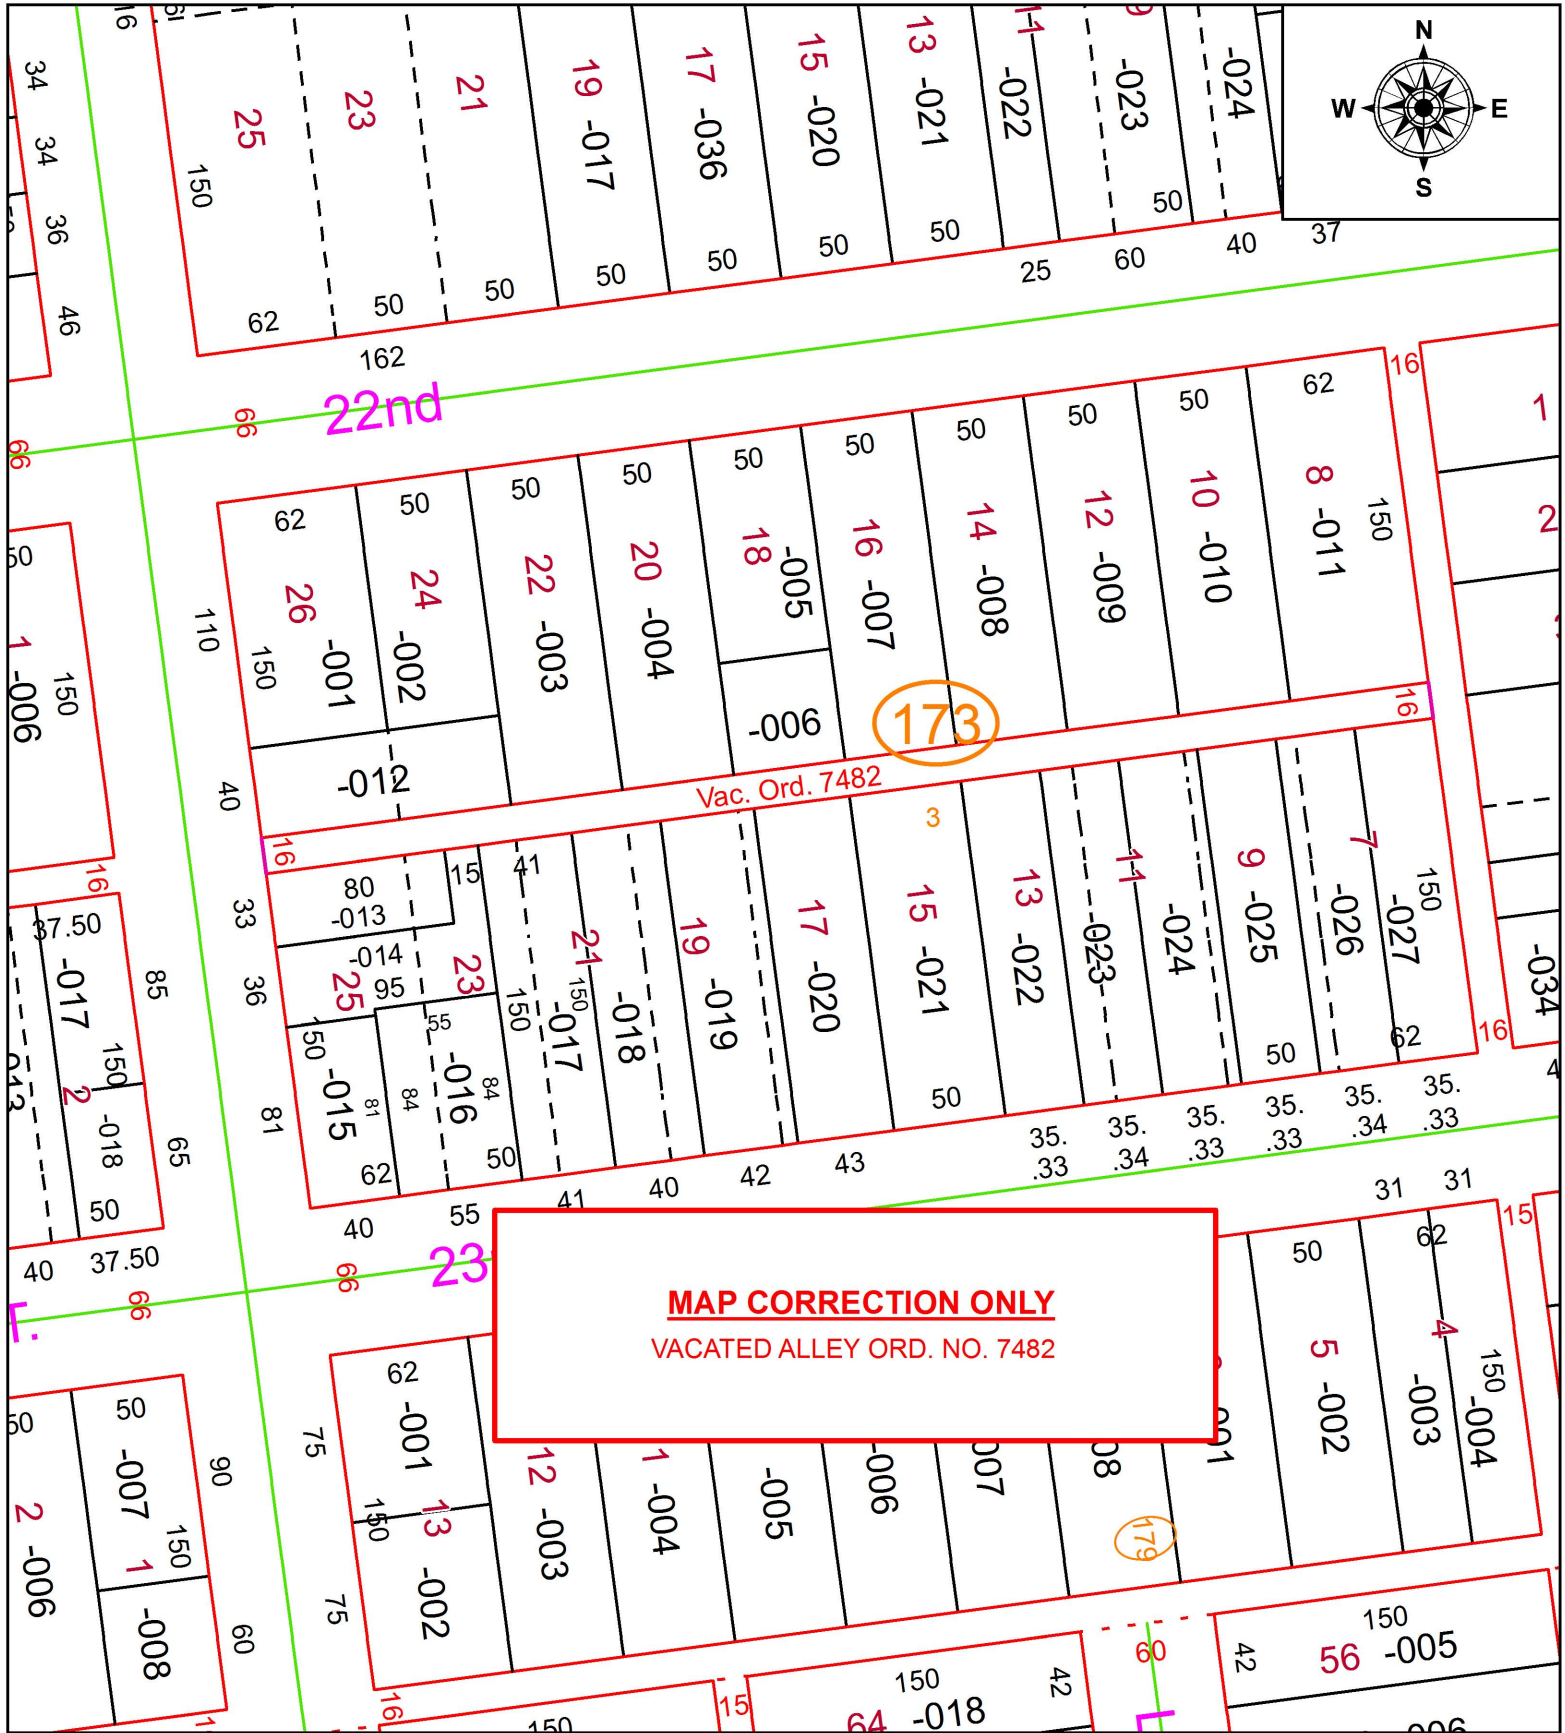


PARENT PARCEL: 02-01-003-173-XXX
CHILD PARCEL: XX-XX-XXX-XXX-XXX
STARTING POINT: VAC. ORD. 7482

17-03660-V

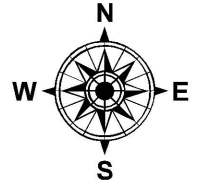

MAP CORRECTION ONLY
VACATED ALLEY ORD. NO. 7482

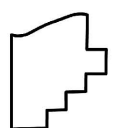

SPLITS/DEEDS PROCESSED
LORAIN COUNTY TAX MAP DEPARTMENT
226 MIDDLE AVE. ELYRIA, OH

SURVEYED BY: _____ N/A
CLOSURE: _____ N/A
MAP PAGE(S): 2-01-003
APPROVED BY: RRM DATE: 4-26-17
SCALE: 1" = 85' PRIOR INSTRUMENT: ORD NO. 7482