



PARENT PARCEL: 02-00-051-103-XXX
CHILD PARCEL: XX-XX-XXX-XXX-XXX
STARTING POINT: ORD. NO. 52-94

17-03661-V

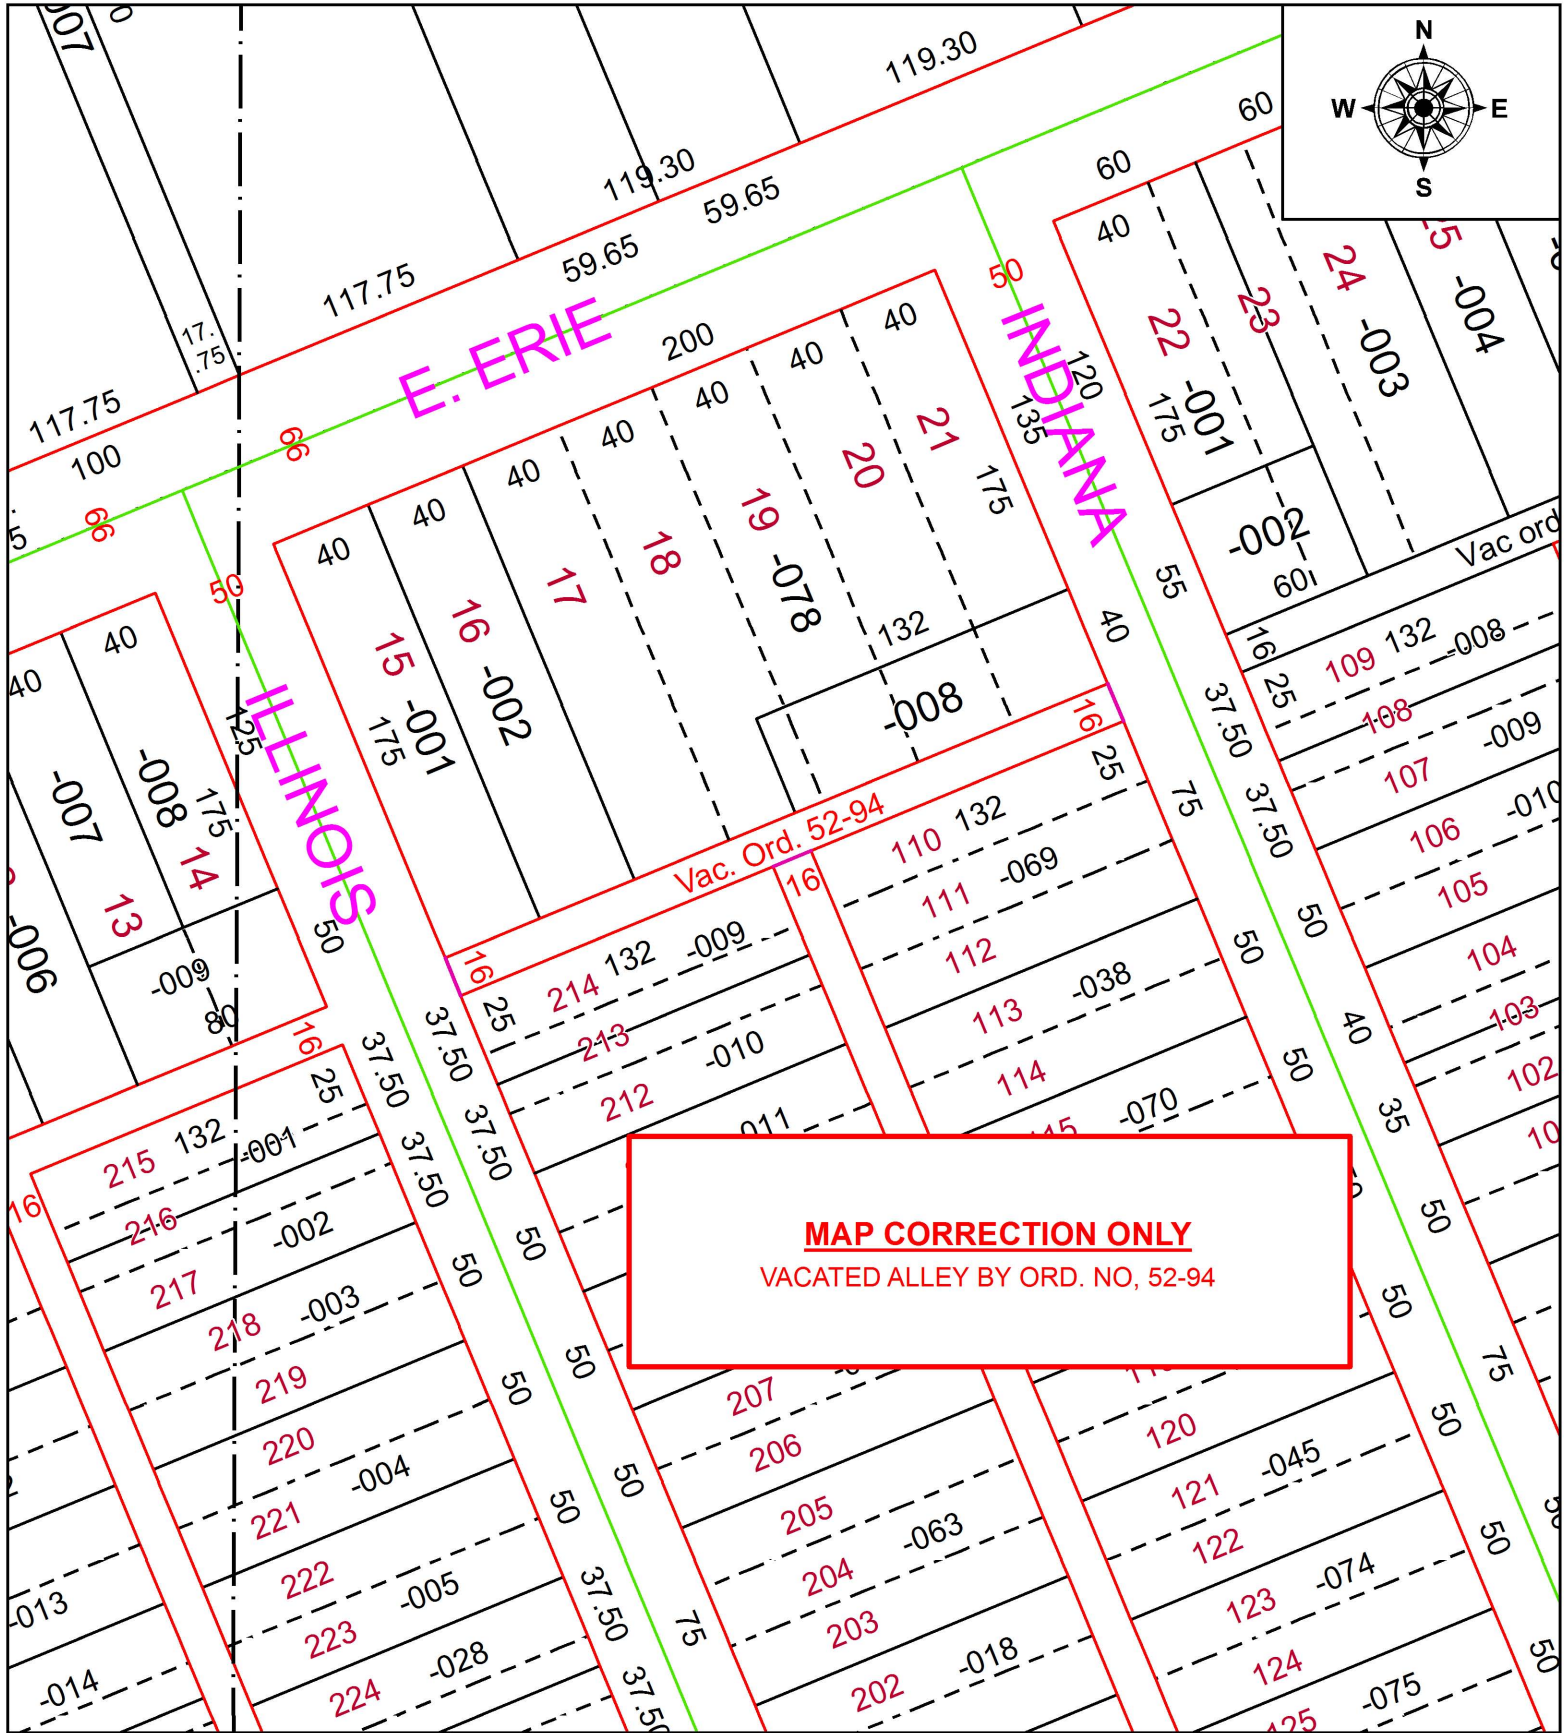

MAP CORRECTION ONLY
VACATED ALLEY BY ORD. NO. 52-94

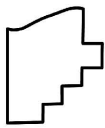

SPLITS/DEEDS PROCESSED
LORAIN COUNTY TAX MAP DEPARTMENT
226 MIDDLE AVE. ELYRIA, OH

SURVEYED BY: _____ N/A
CLOSURE: _____ N/A
MAP PAGE(S): _____ 2-00-051
APPROVED BY: _____ RRM DATE: _____ 4-26-17
SCALE: _____ 1" = 75 PRIORITY INSTRUMENT: _____ ORD NO. 52-94