




PARENT PARCEL: 09-00-088-106-010

CHILD PARCEL: XX-XX-XXX-XXX-XXX

STARTING POINT: NORTHEAST CORNER OF S/L 1 IN WILLOWBROOK FARMS SUB. NO.1

17-03662-C

547.15

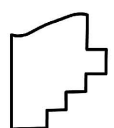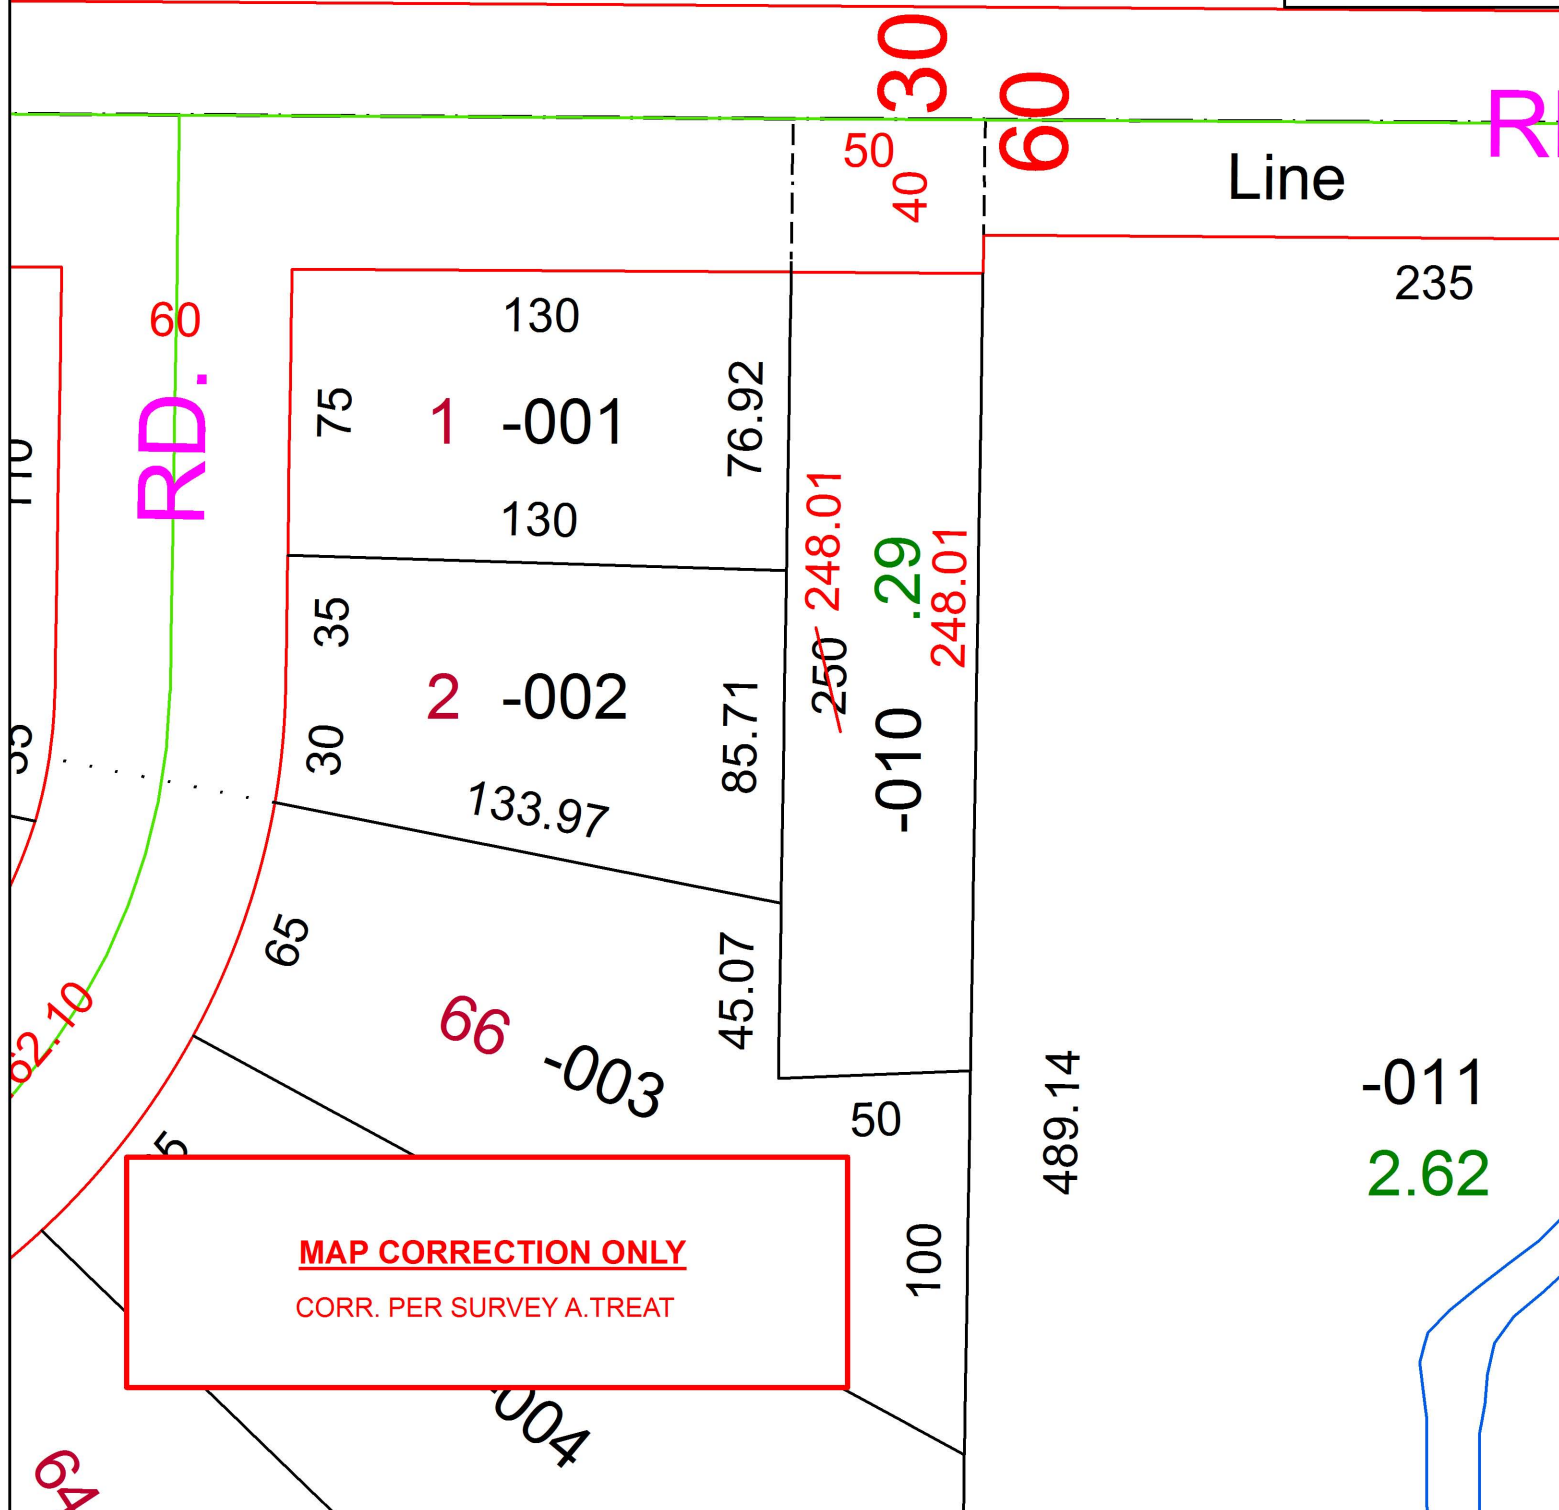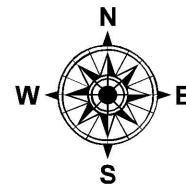

SPLITS/DEEDS PROCESSED
 LORAIN COUNTY TAX MAP DEPARTMENT
 226 MIDDLE AVE. ELYRIA, OH

SURVEYED BY: ADAM D. TREAT
 CLOSURE: 1: 2147483648
 MAP PAGE(S): 9-00-088
 APPROVED BY: RRM DATE: 4-27-17
 SCALE: 1" = 50 PRIOR INSTRUMENT: 20170619987