


PARENT PARCEL: 01-00-037-102-001, -002

CHILD PARCEL: 01-00-037-102-051, -052

STARTING POINT: CENTERLINES OF COOPER FOSTER PARK RD & SUNNYSIDE RD

17-03662

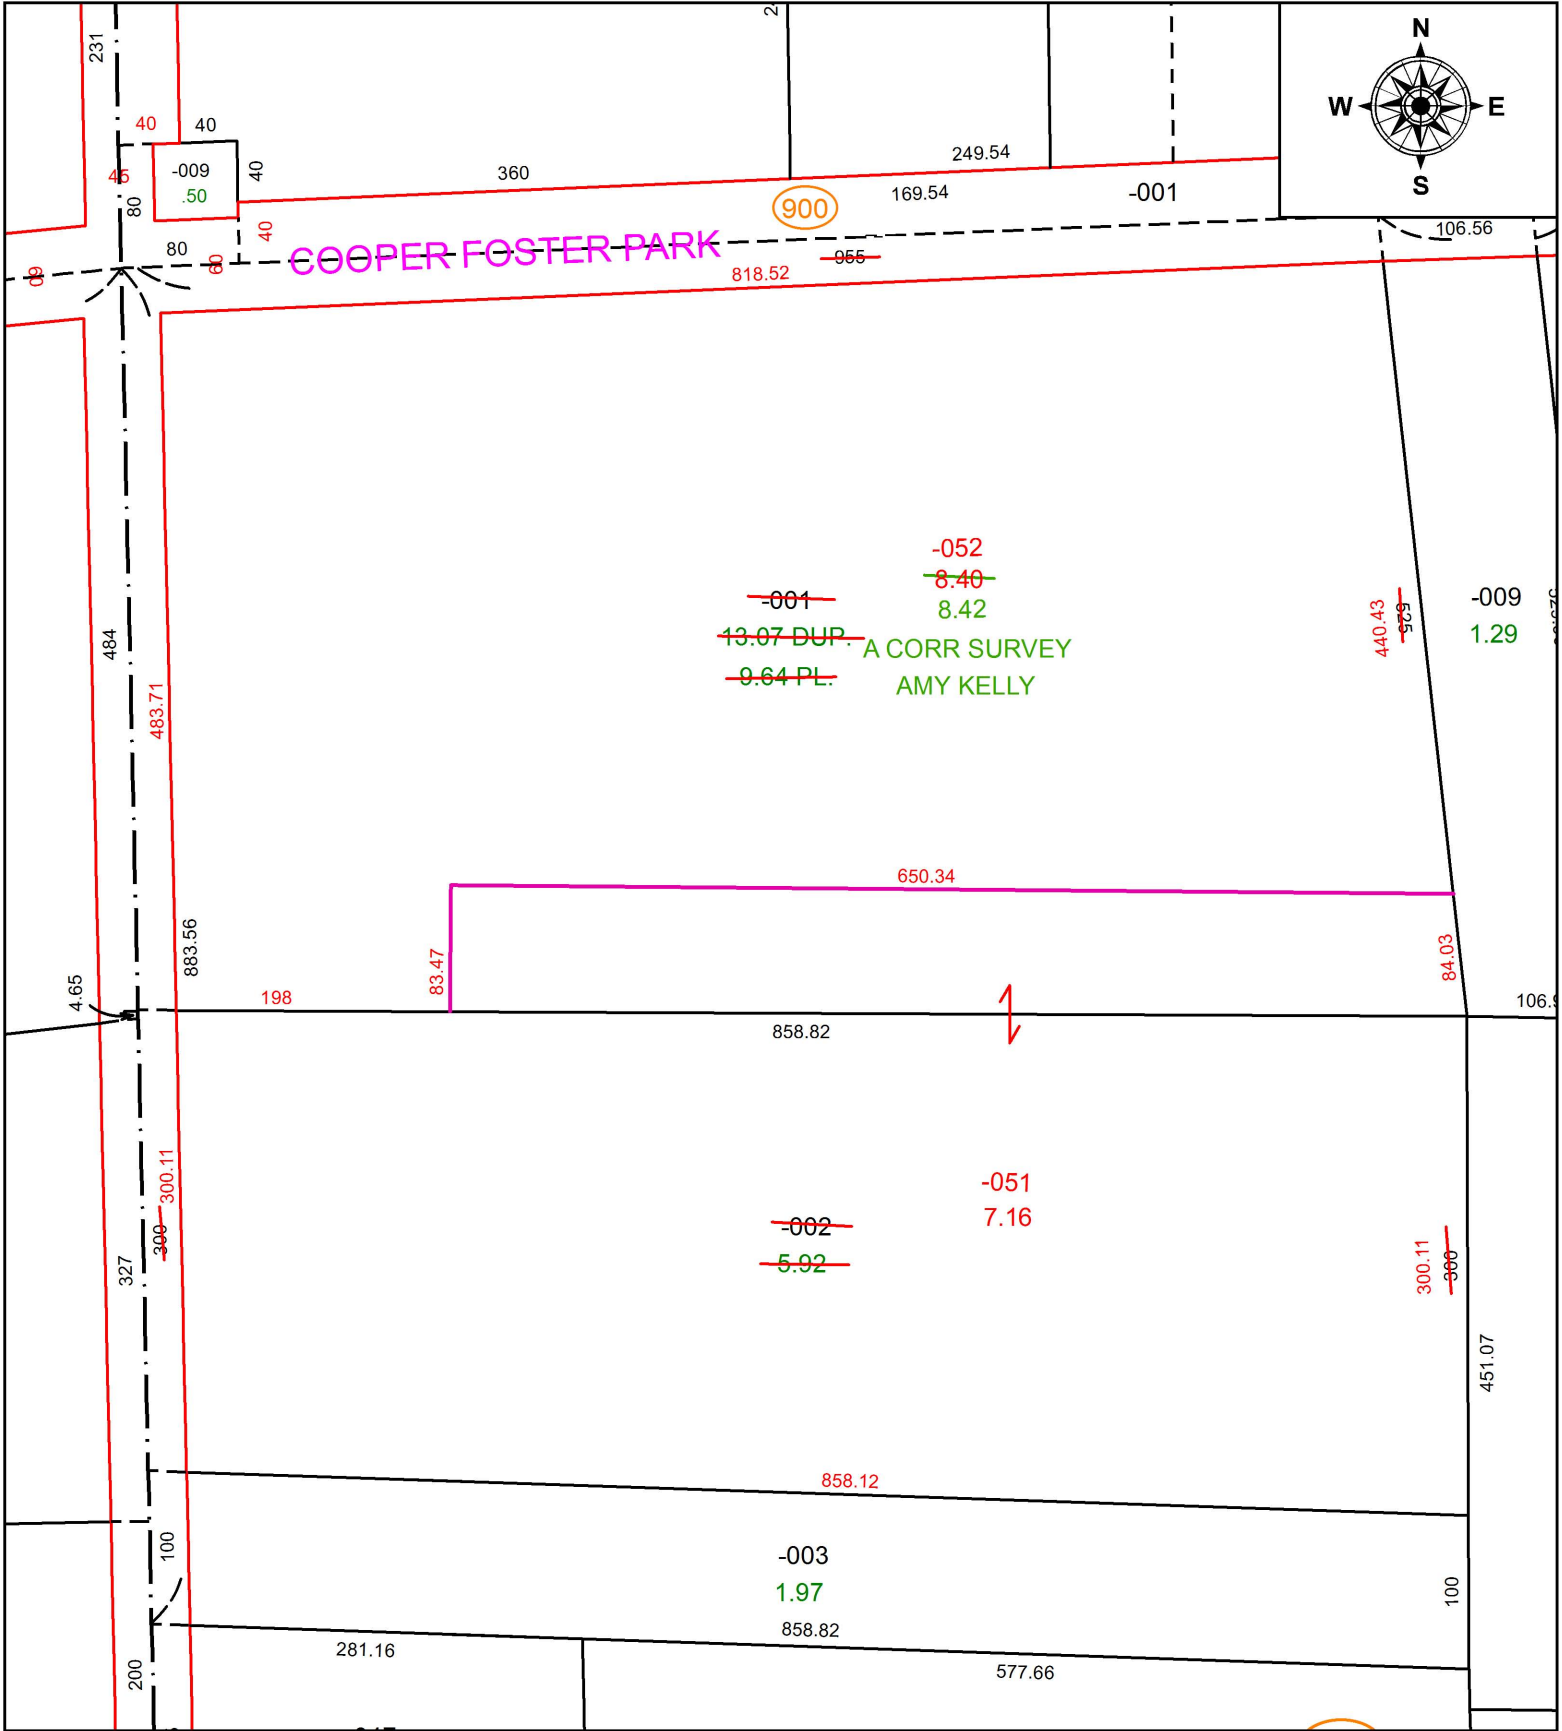

SPLITS/DEEDS PROCESSED
 LORAIN COUNTY TAX MAP DEPARTMENT
 226 MIDDLE AVE. ELYRIA, OH

SURVEYED BY: AMY KELLY
 CLOSURE: 1: 33,000
 MAP PAGE(S): 01-00-037
 APPROVED BY: JAH DATE: 04-20-2017
 SCALE: 1 in = 125 ft PRIOR INSTRUMENT: 20130485190