


PARENT PARCEL: 05-00-061-104-023

CHILD PARCEL: XX-XX-XXX-XXX-XXX

STARTING POINT: N/A

17-03664-C

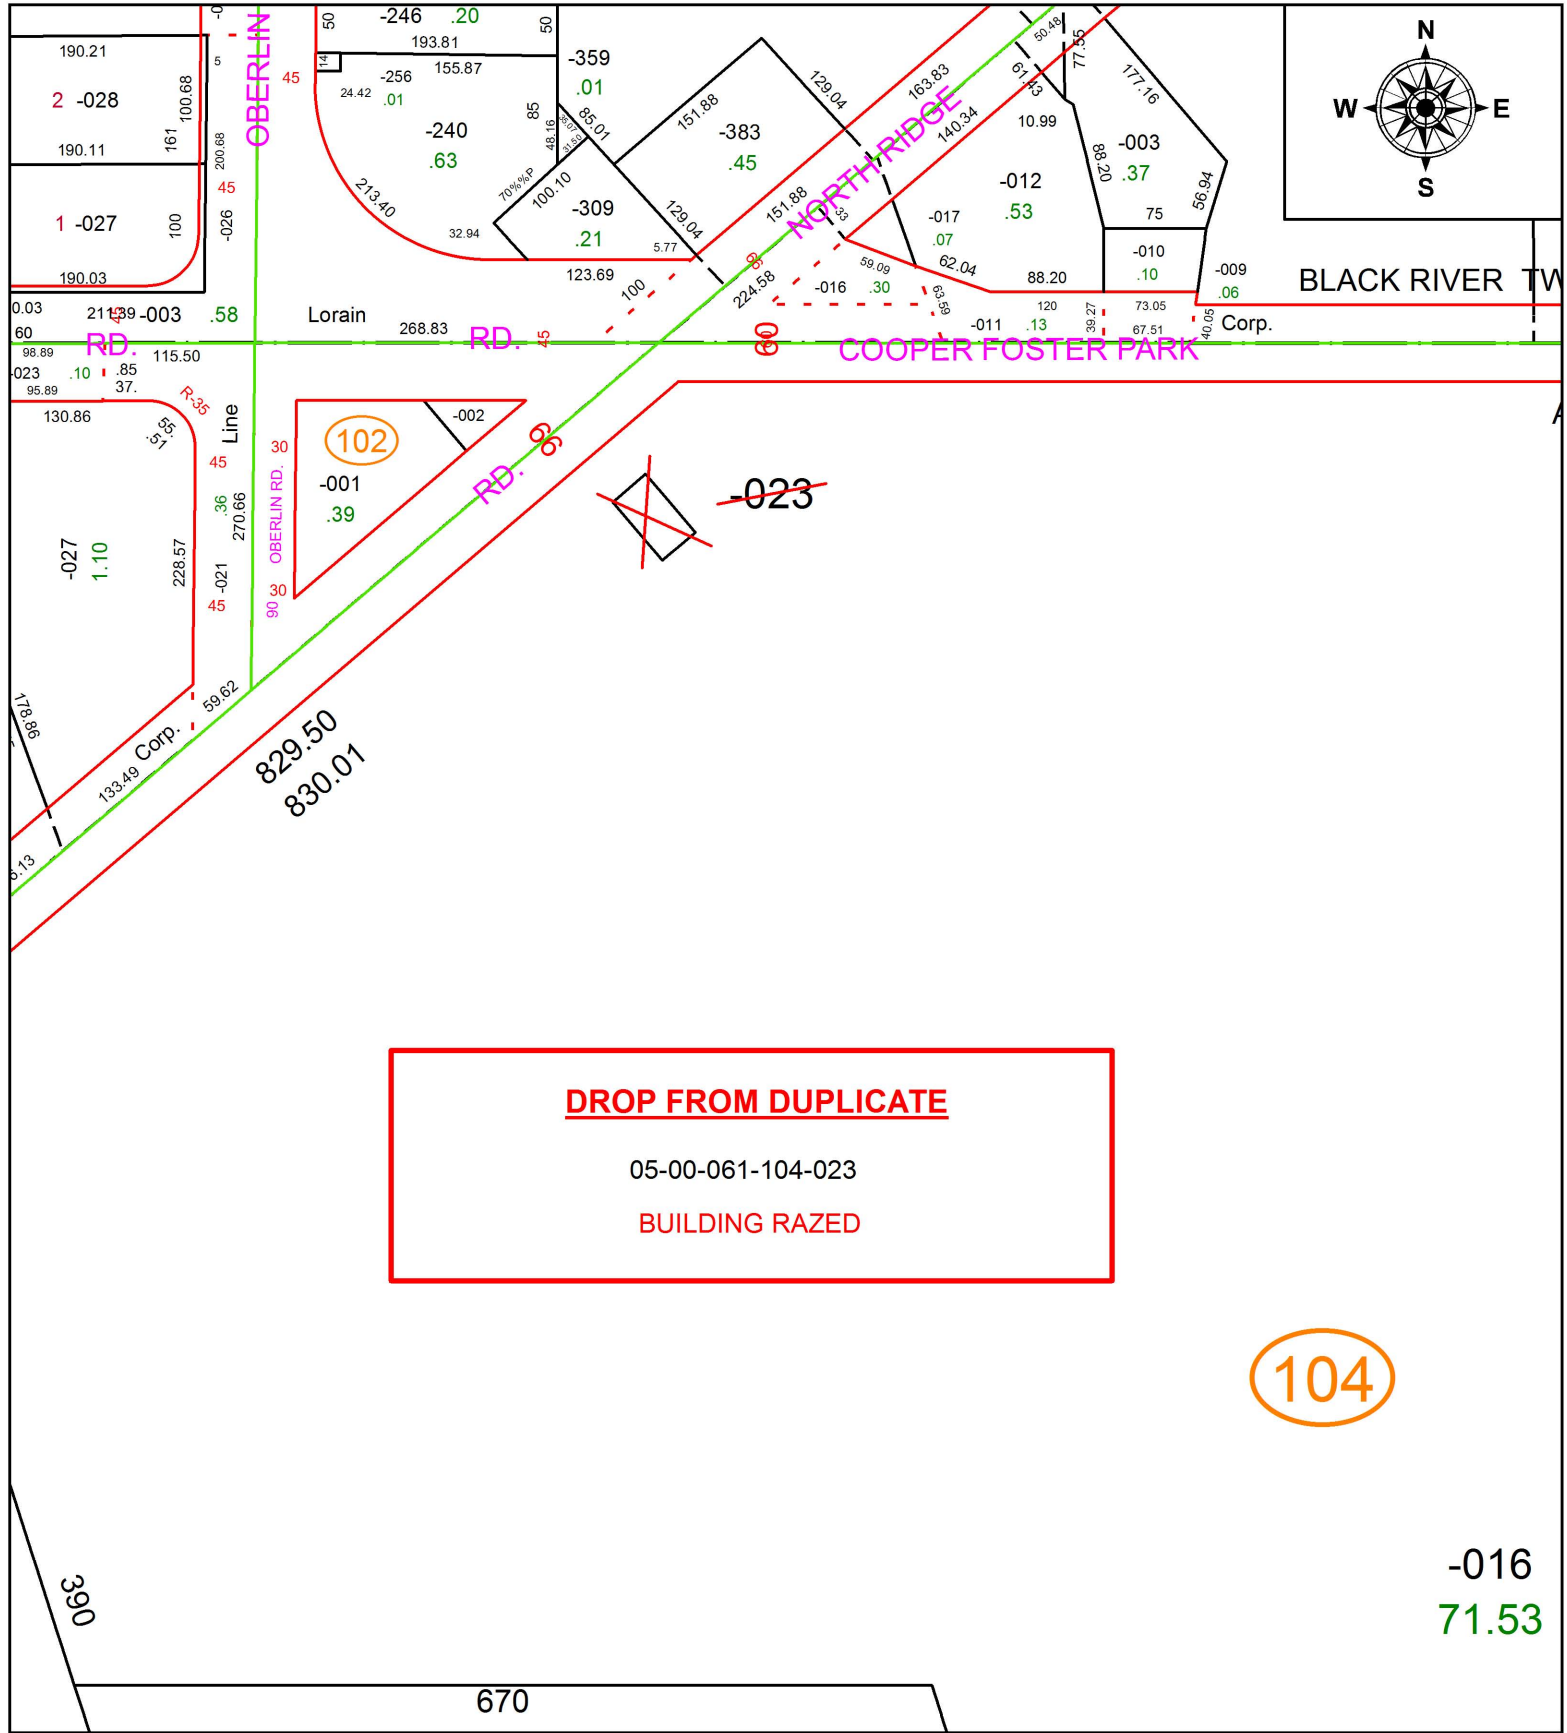

DROP FROM DUPLICATE

05-00-061-104-023

BUILDING RAZED

104

-016
71.53

SPLITS/DEEDS PROCESSED
 LORAIN COUNTY TAX MAP DEPARTMENT
 226 MIDDLE AVE. ELYRIA, OH

SURVEYED BY: _____ N/A
 CLOSURE: _____ N/A
 MAP PAGE(S): _____ 5-00-061
 APPROVED BY: _____ RRM DATE: _____ 5-3-17
 SCALE: _____ 1" = 150 _____ PRIOR INSTRUMENT: _____ N/A