
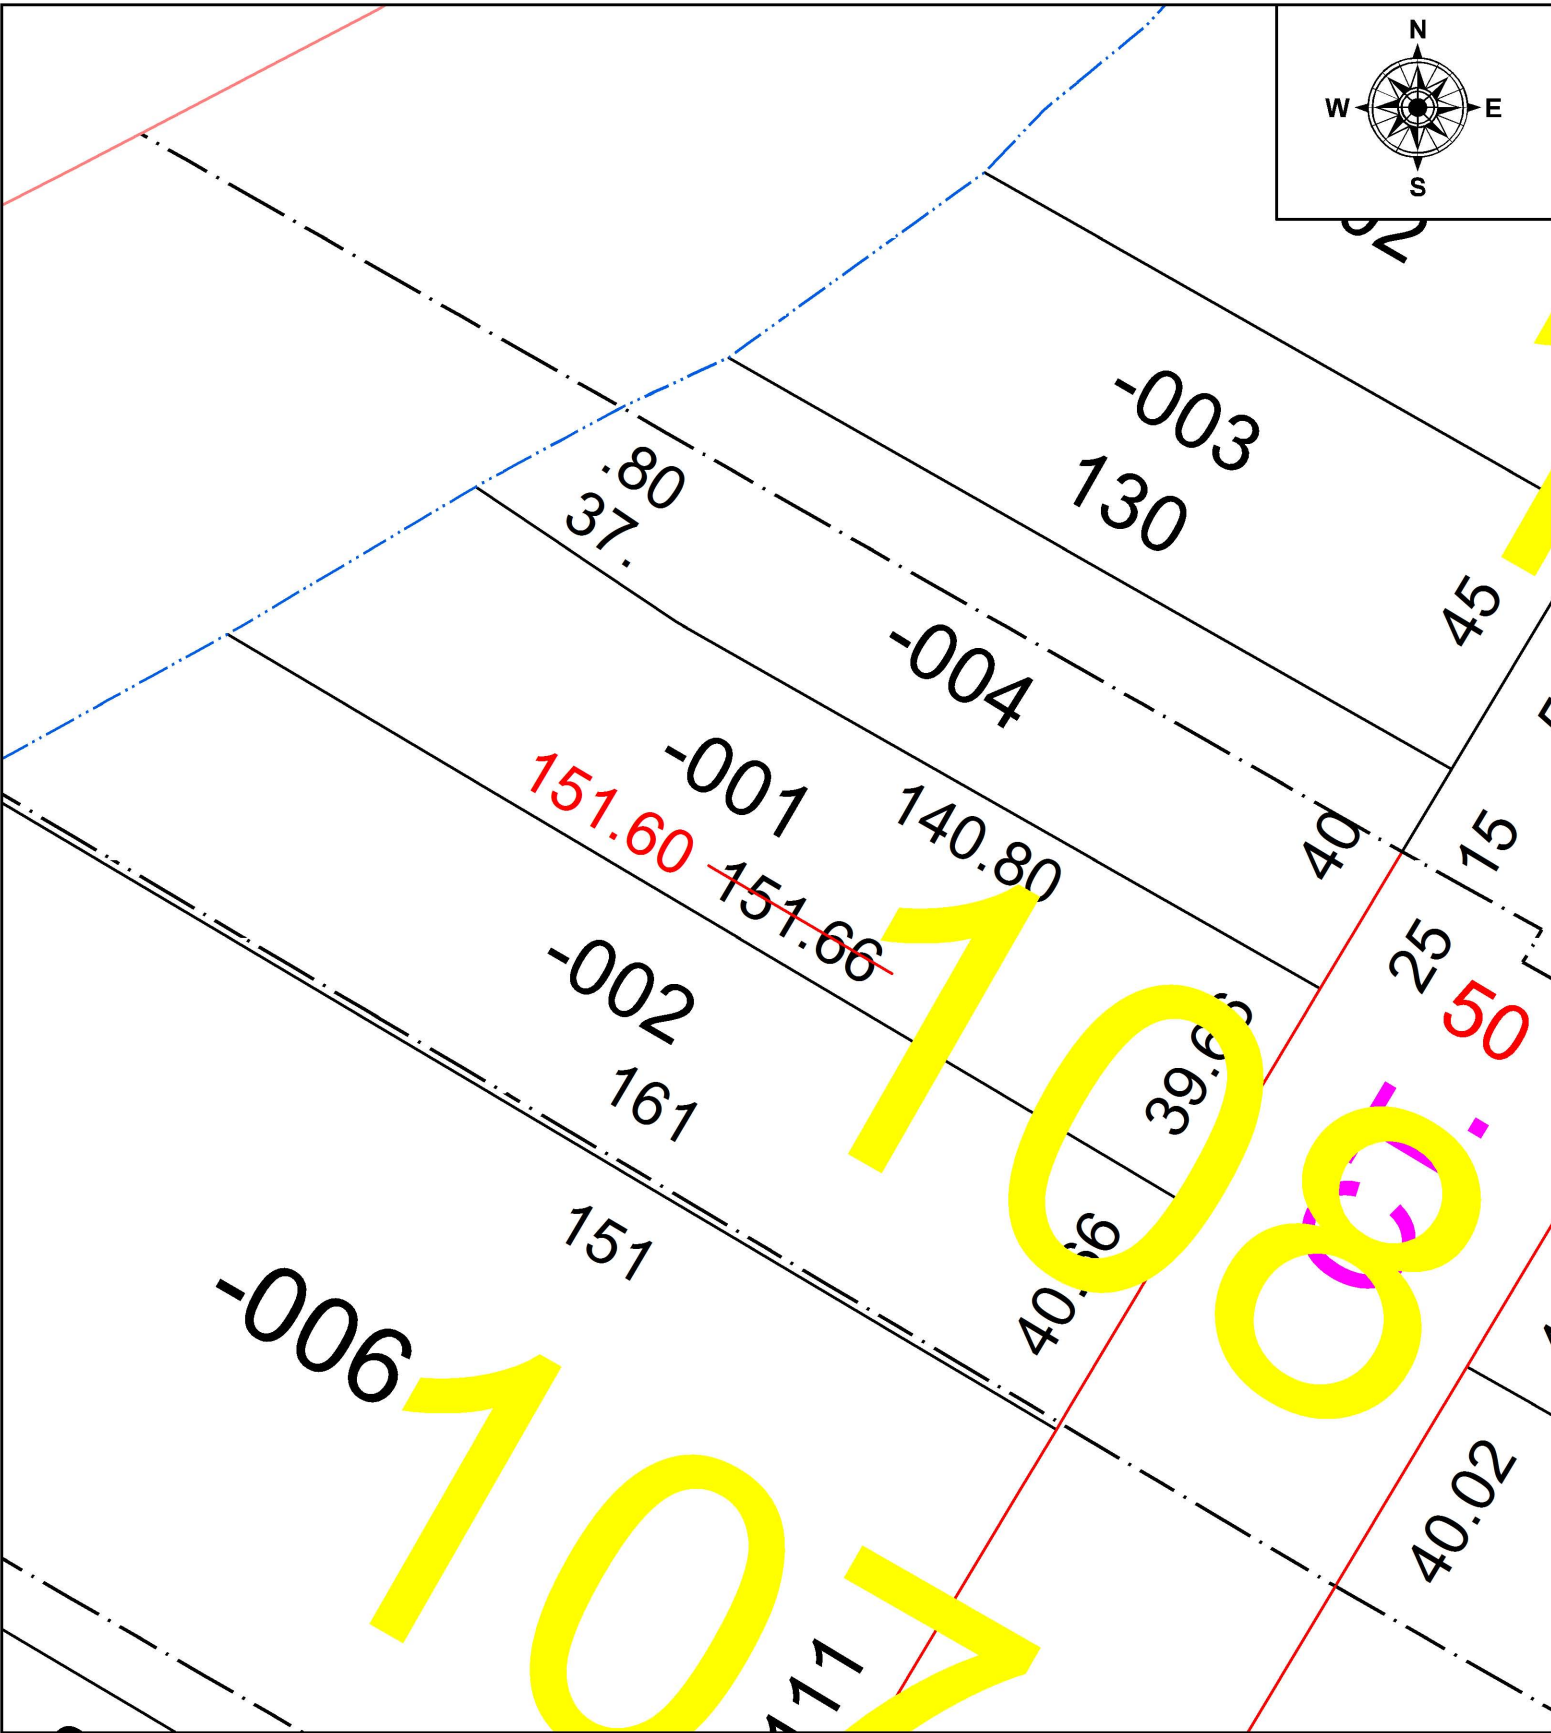


PARENT PARCEL: 06-25-108-000-001

CHILD PARCEL: **FR. & DEPTH CORRECTION**

STARTING POINT: S.E. CORNER OF DIEDRICK DV 393/309

17-03666-C

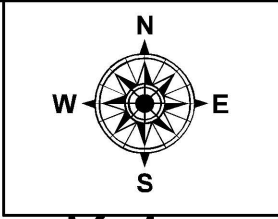

SPLITS/DEEDS PROCESSED
LORAIN COUNTY TAX MAP DEPARTMENT
226 MIDDLE AVE. ELYRIA, OH

SURVEYED BY:	NA
CLOSURE:	NA
MAP PAGE(S):	06-25-108
APPROVED BY:	TJS DATE: 5/8/17
SCALE:	1" = 30'
PRIOR INSTRUMENT:	DV 393/309