
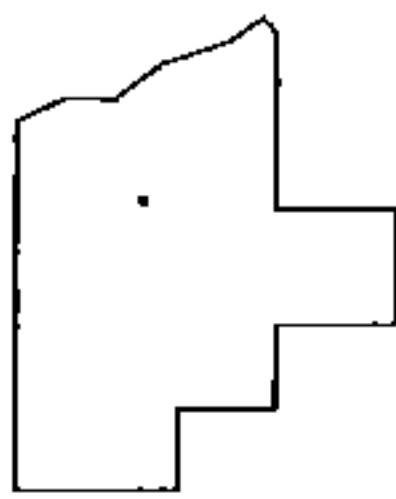
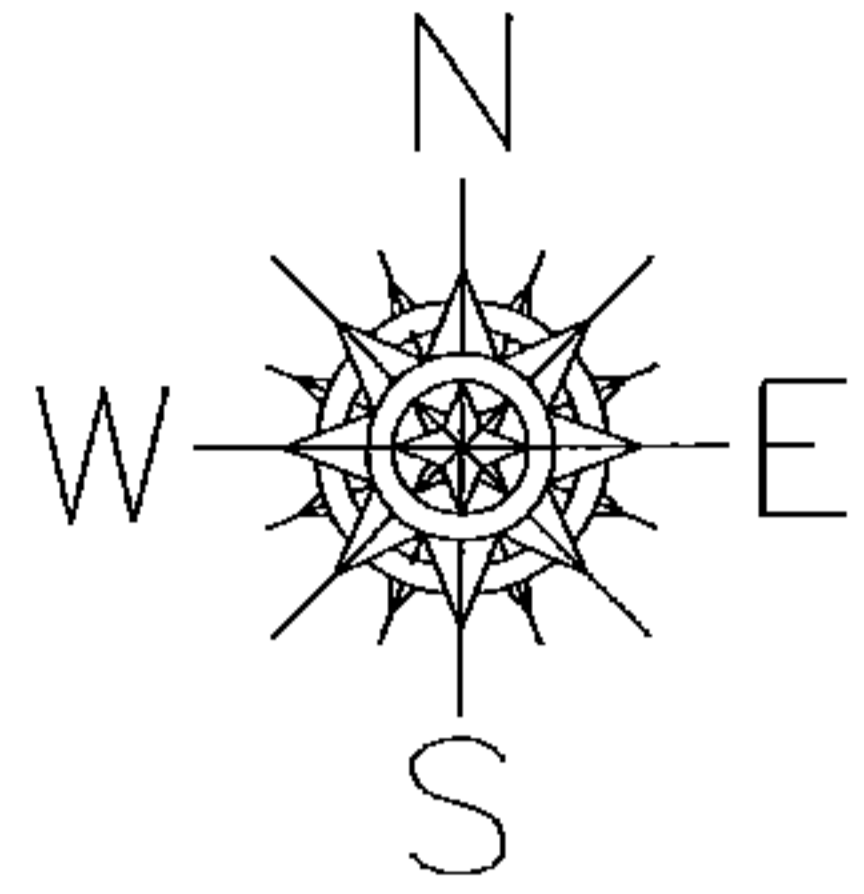


PARENT PARCEL: 05-00-029-000-031, 05-00-028-000-002 THRU -005, & -011, 05-00-029-000-001 & -007
 CHILD PARCEL: 05-00-028-000-013 THRU -023, 05-00-029-000-096 & -097, 05-00-033-000-070
 STARTING POINT: I.P. FOUND, S.W. CORNER OF O.L. 28

17-03666

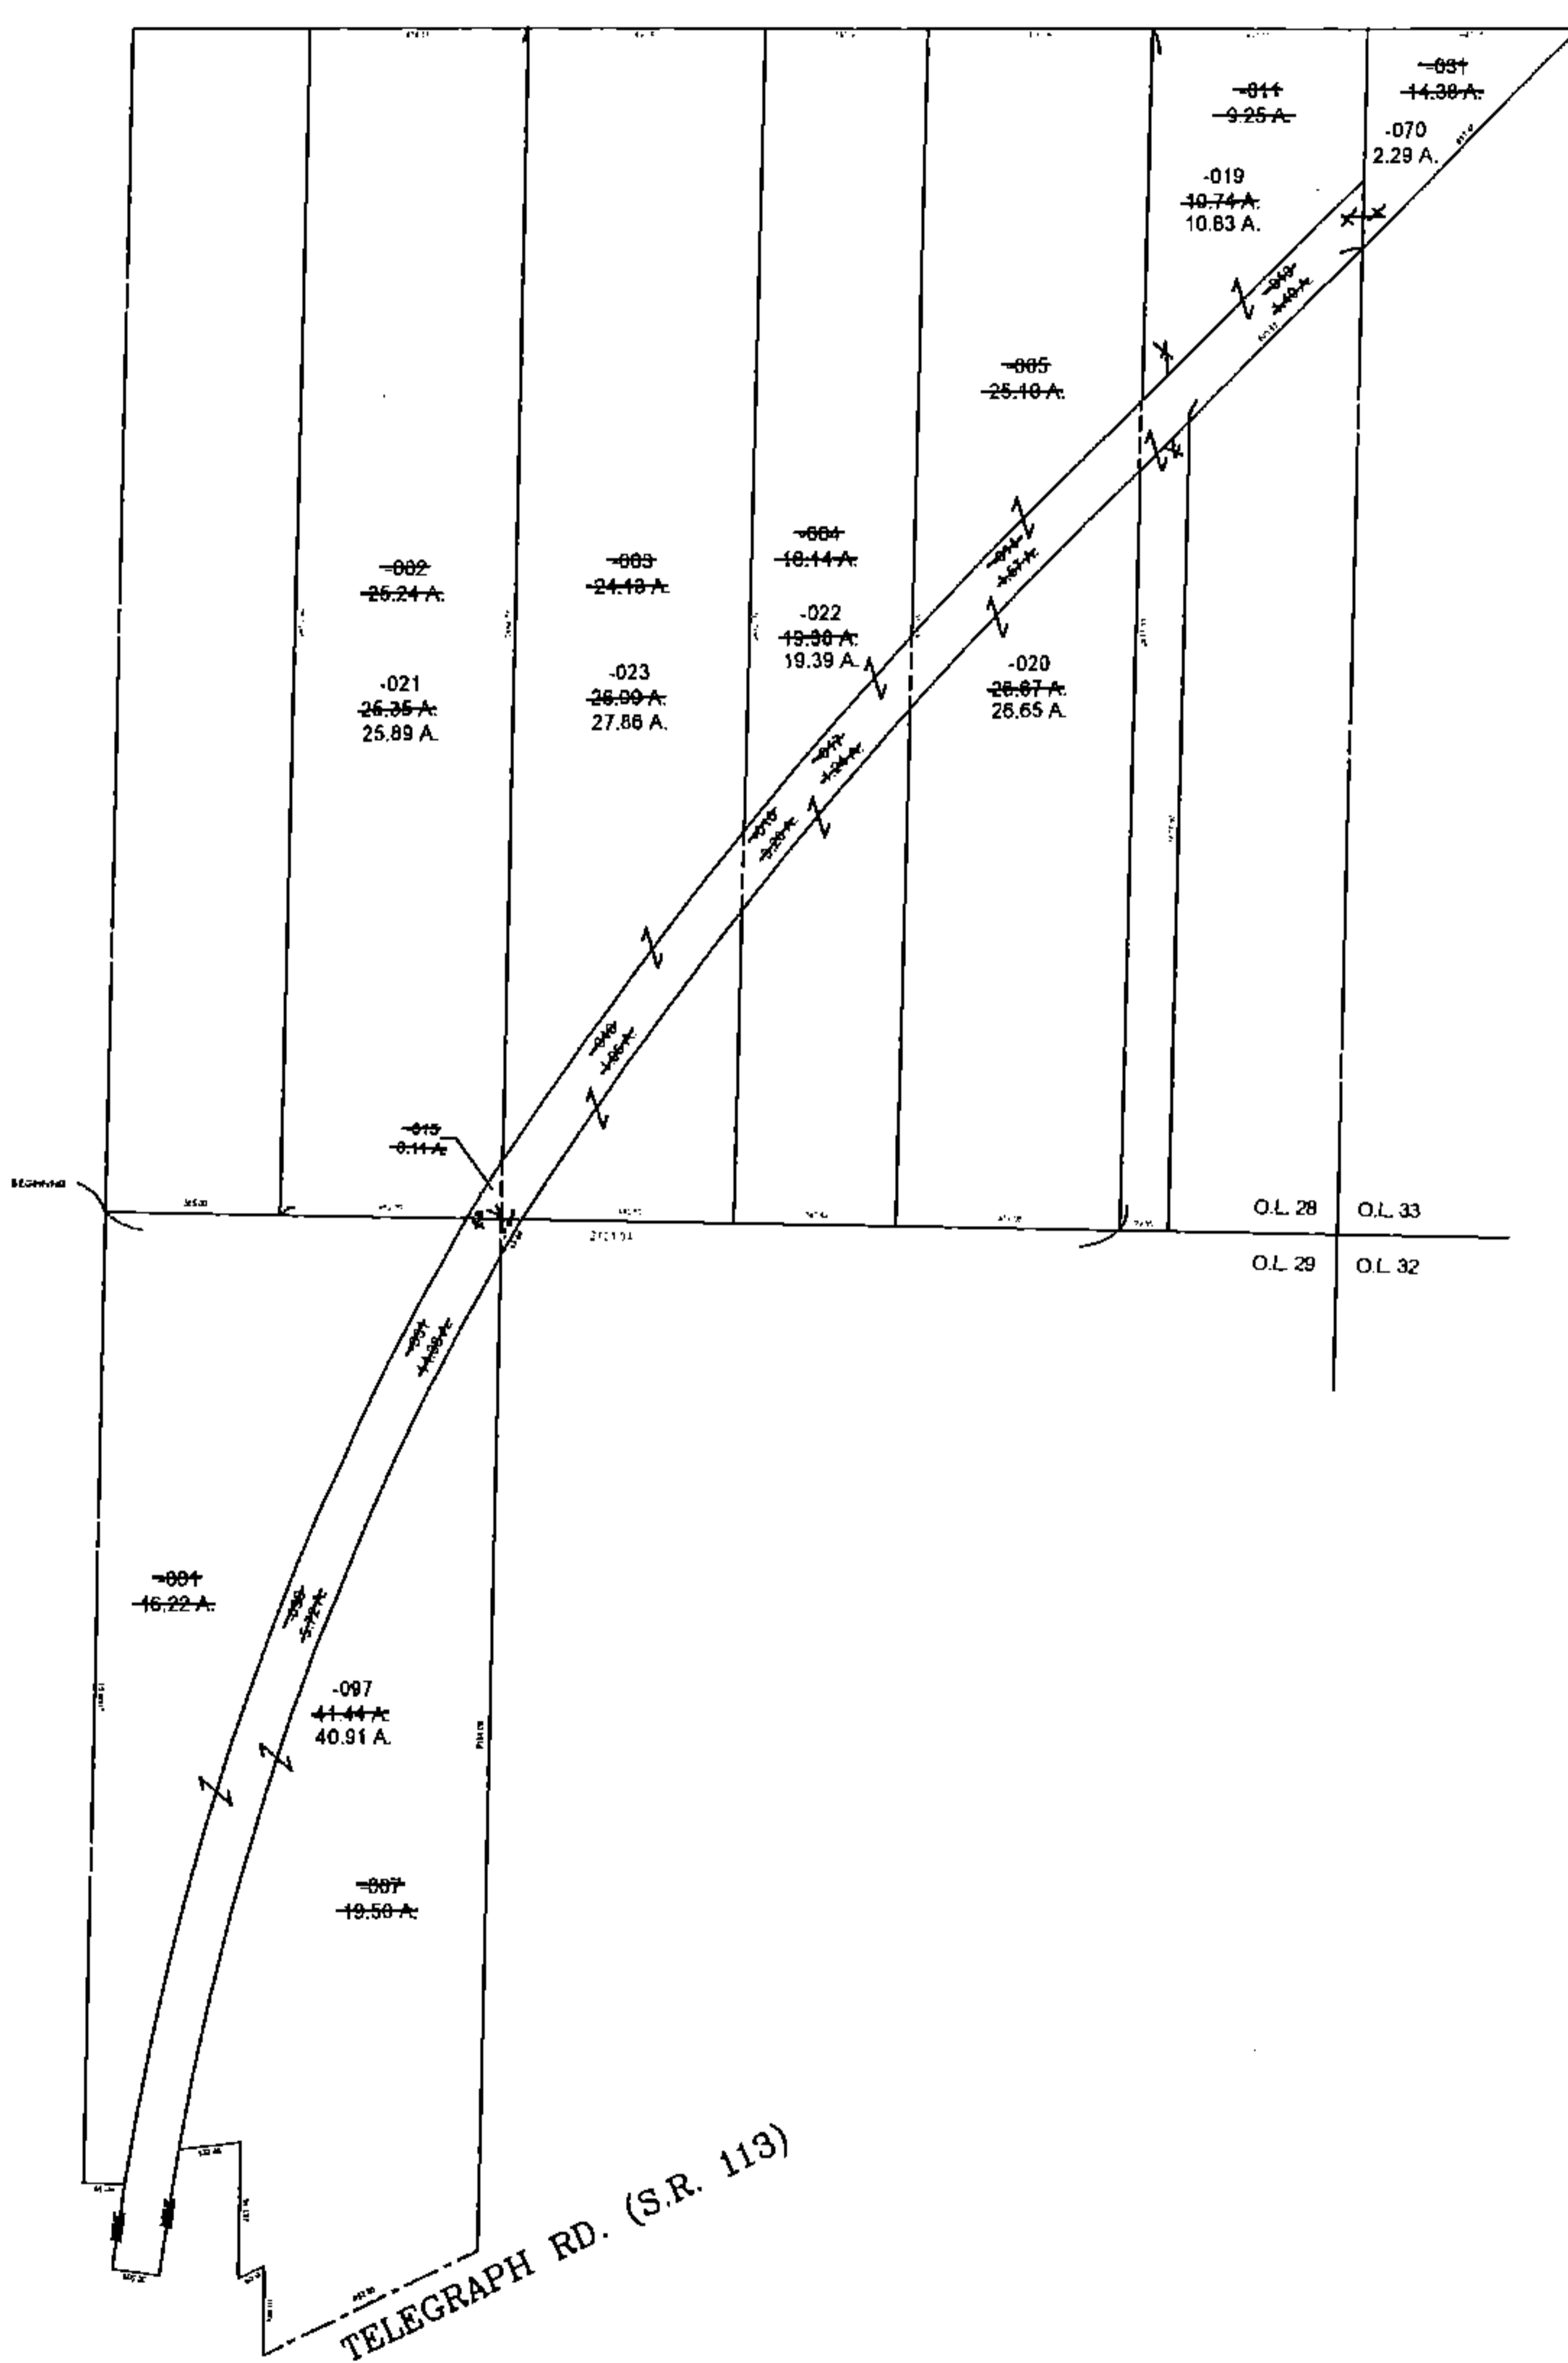

SPLITS/DEEDS PROCESSED
 LORAIN COUNTY TAX MAP DEPARTMENT
 226 MIDDLE AVE. ELYRIA, OHIO

SURVEYED BY: PATRICK A. MCGANNON
 CLOSURE: 0.01 : 10,000
 MAP PAGE(S): 05-00-028, -029, -033
 APPROVED BY: TJS DATE: 5/26/17
 SCALE: 1" = 600 PRIOR INSTRUMENT: 2017-0623845