



PARENT PARCEL: MAP CORRECTION FOR THE STARTING DISTANCE OF #99-00077  
 CHILD PARCEL: 05-00-063-101-188 THRU -194  
 STARTING POINT: CL OF RUSTIC HILL LANE & CL OF ALLANDALE DR.

17-03667-C

RUSTIC HILL LN. 60'

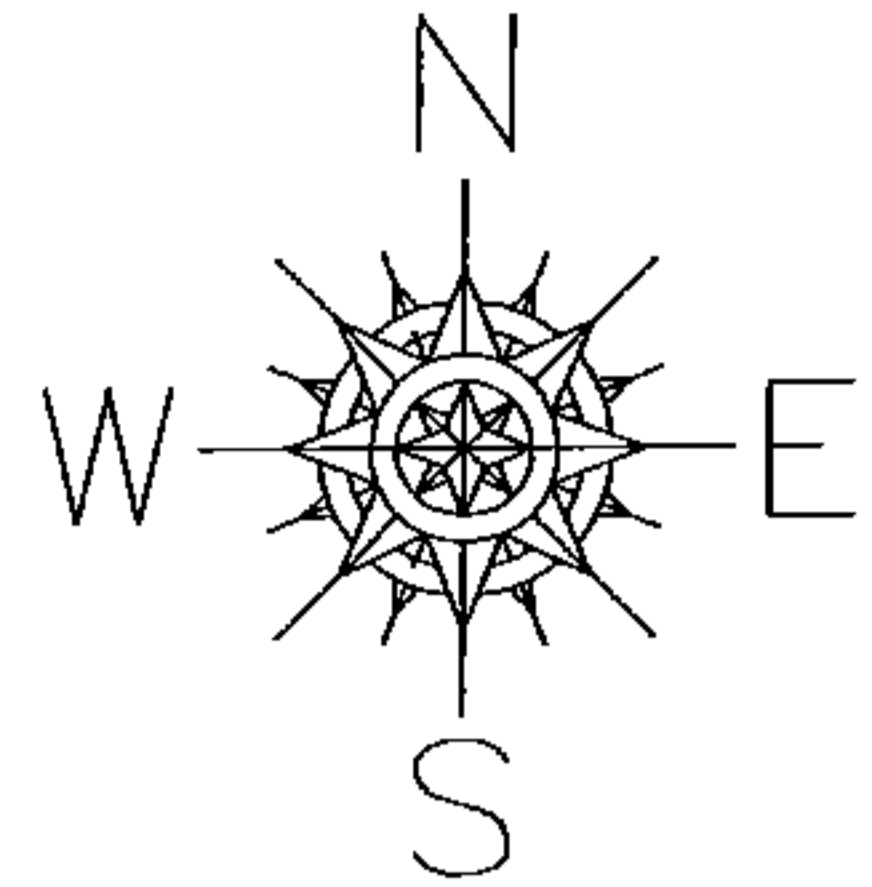

DETAIL NO SCALE


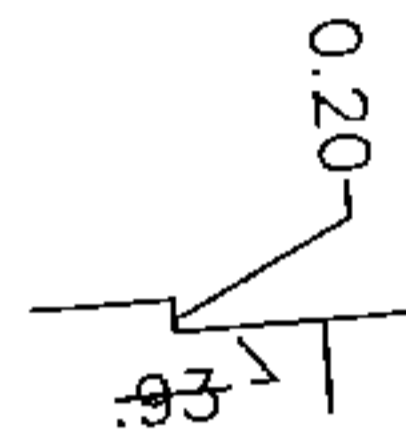


ALLANDALE DR.


DR. 60'

204.86  
~~174.86~~  
 R=3211.81  
 L=199.94

16  
 R=3070.43  
 L=216.41

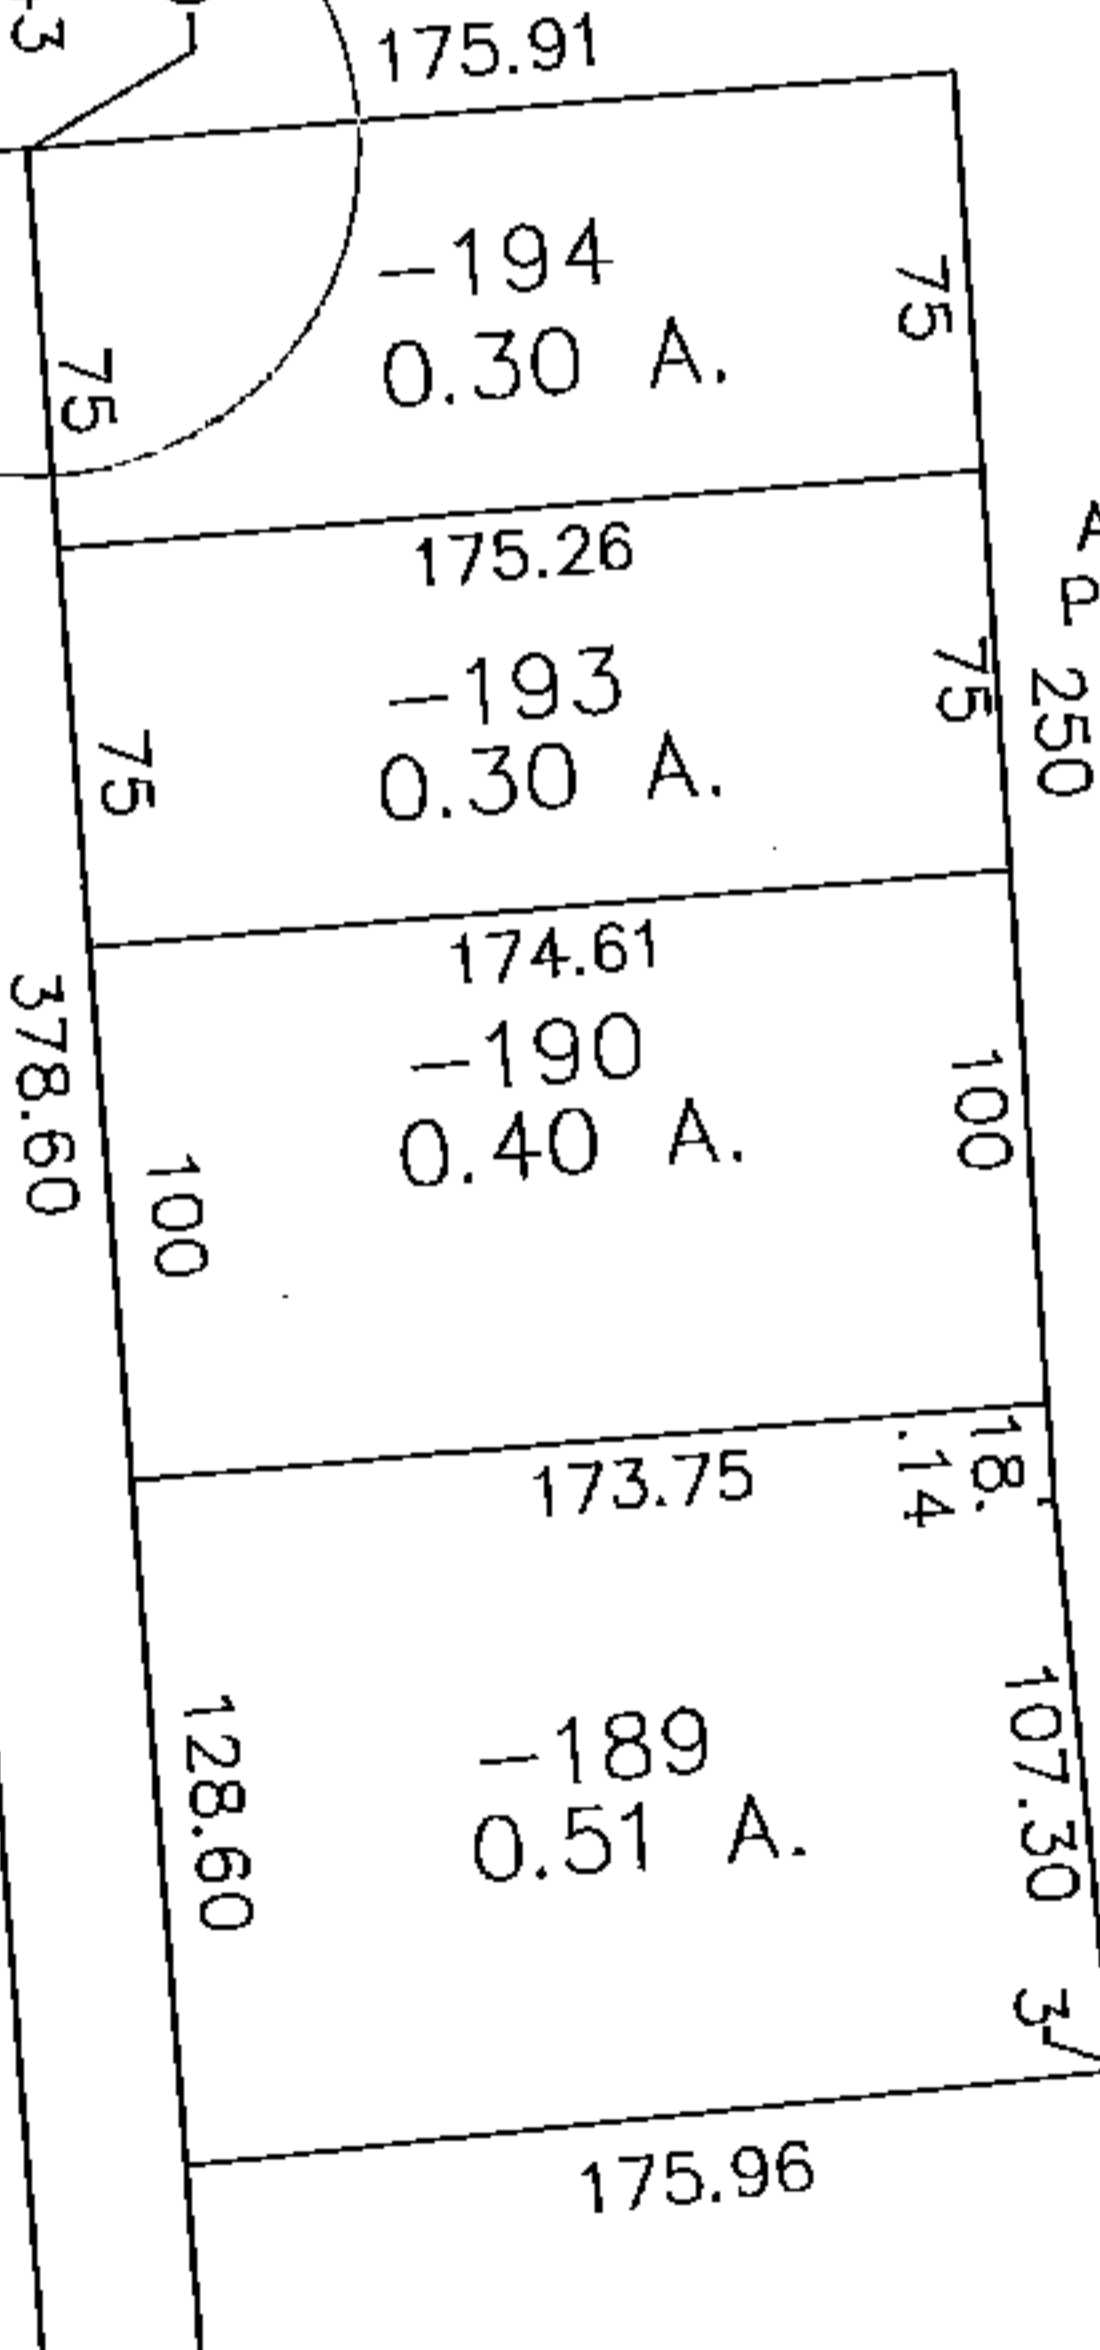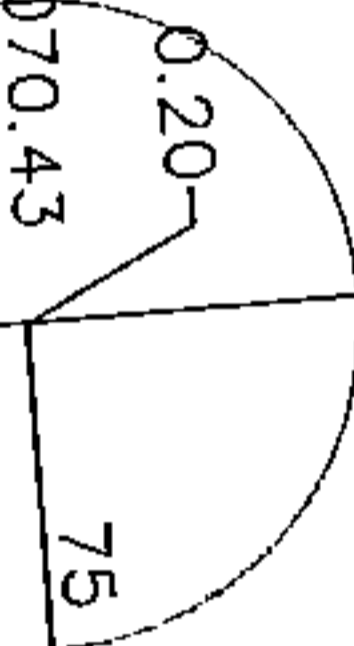

AC. CORR. PER SURV.  
 PATRICK A. MCGANNON

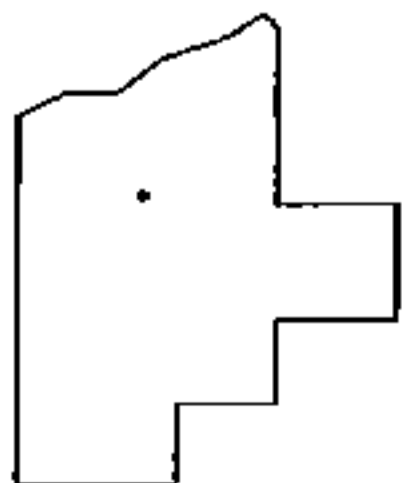

SPLITS/DEEDS PROCESSED

LORAIN COUNTY TAX MAP DEPARTMENT  
 226 MIDDLE AVE. ELYRIA, OHIO

SURVEYED BY: PATRICK A. MCGANNON  
 CLOSURE: 0.15 : 10.000  
 MAP PAGE(S): 05-00-063-A  
 APPROVED BY: TJS DATE: 5/4/17  
 SCALE: 1"=100 PRIOR INSTRUMENT: 19980582466