


PARENT PARCEL: 18-00-031-000-015, -018

CHILD PARCEL: 18-00-031-000-055 THRU -059

STARTING POINT: INTERSECTION OF C/L OF PITTS RD, AND C/L OF PECK WADSWORTH RD,

17-03667

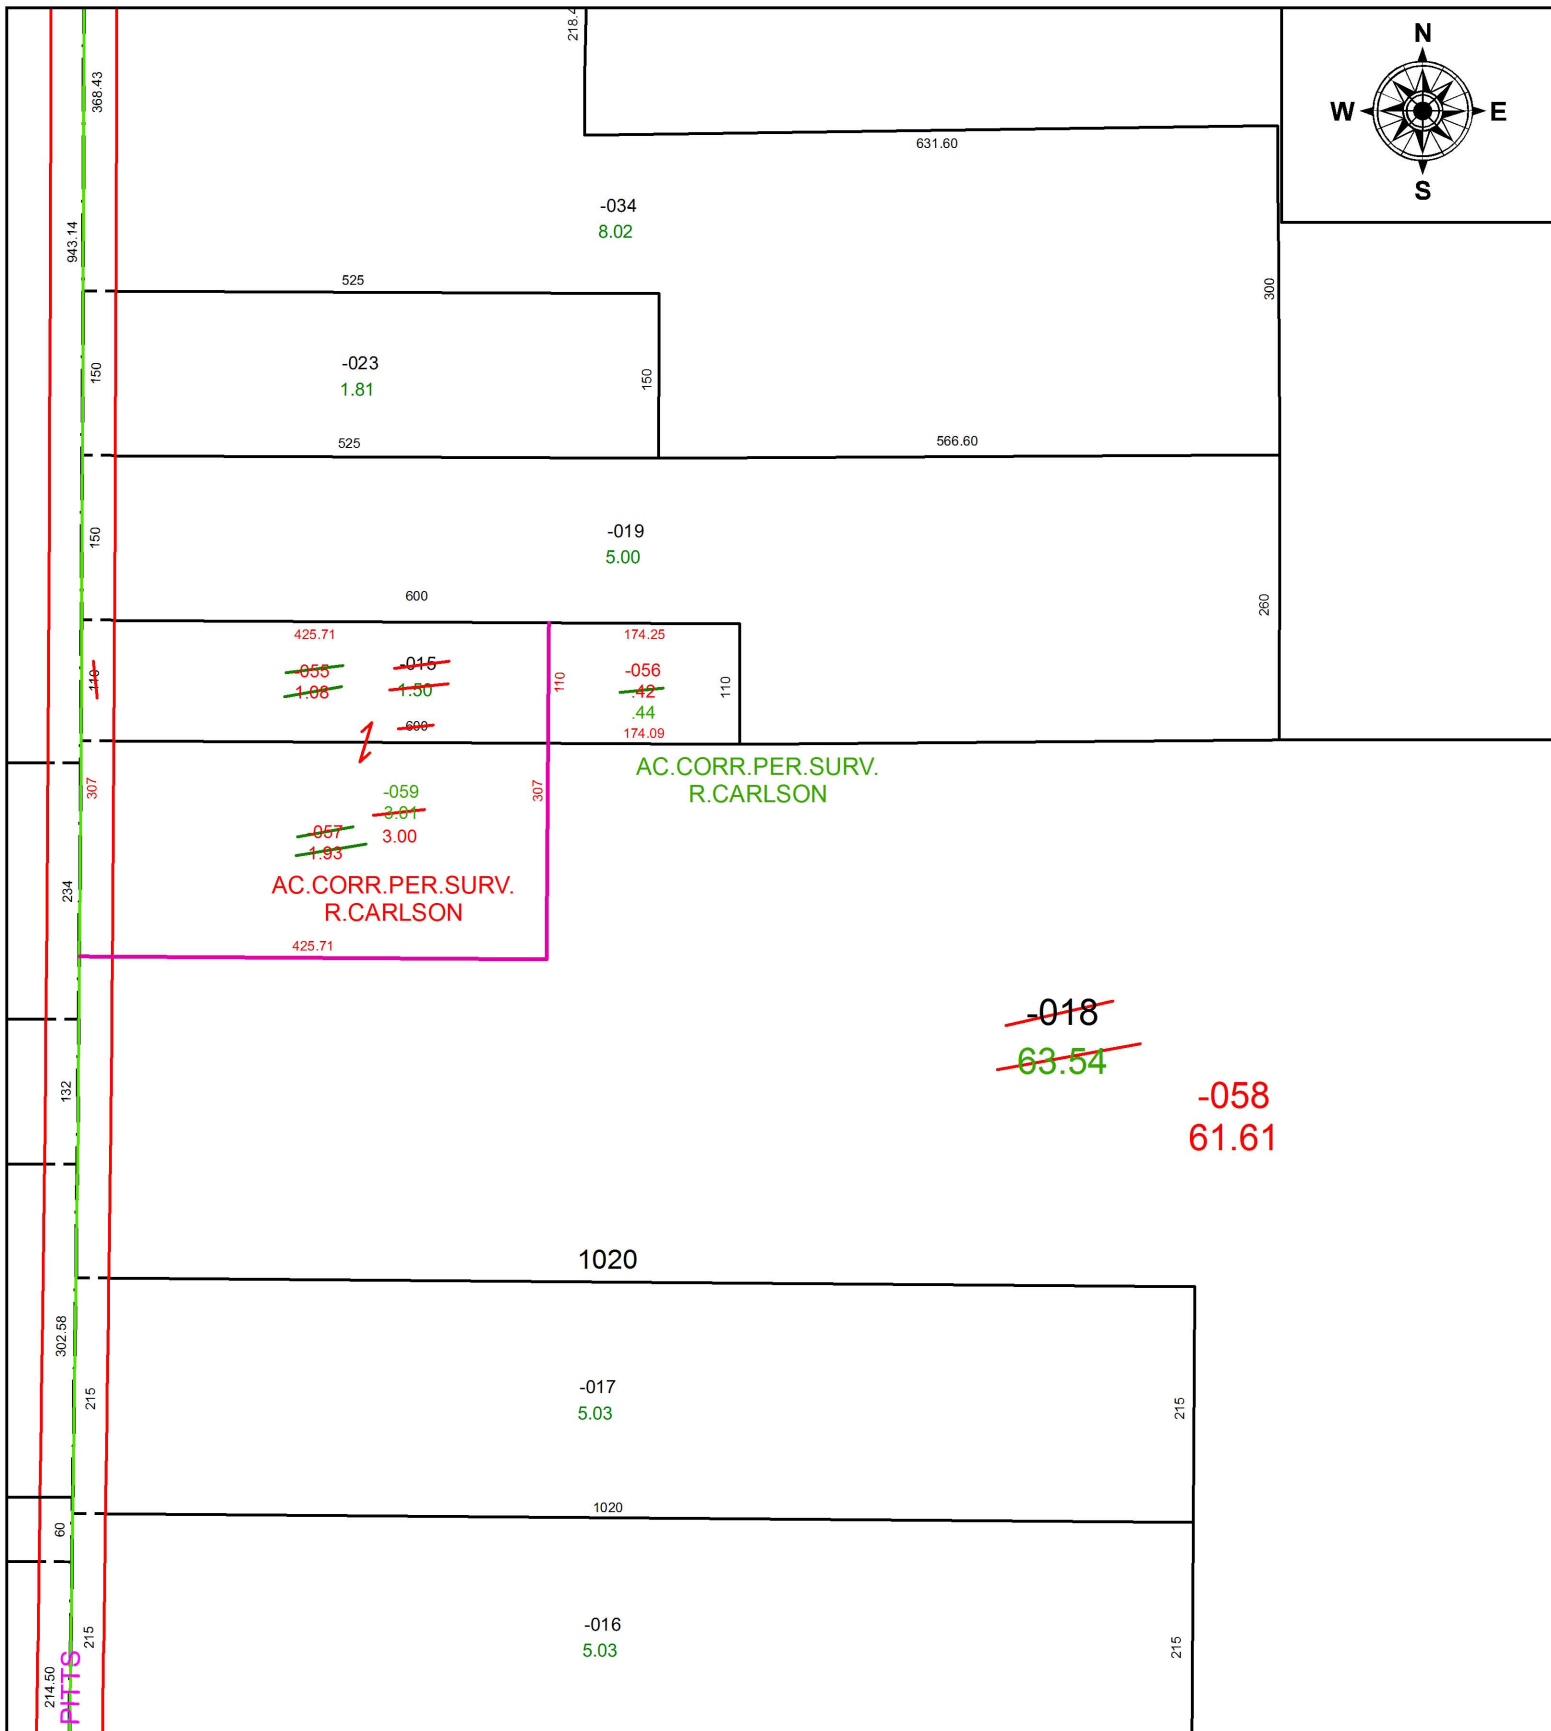

**SPLITS/DEEDS PROCESSED**  
 LORAIN COUNTY TAX MAP DEPARTMENT  
 226 MIDDLE AVE. ELYRIA, OH

**SURVEYED BY:** RICHARD D. CARLSON

**CLOSURE:** 1: 2147483648

**MAP PAGE(S):** 18-00-031

**APPROVED BY:** RRM **DATE:** 5-4-17

**SCALE:** 1" = 175 **PRIOR INSTRUMENT:** DV 1266/381