


PARENT PARCEL: 21-05-016-000-003

CHILD PARCEL: 21-05-012-000-033, 21-05-013-000-017, 21-05-014-000-002, 21-05-015-000-002, -003, 21-05-016-000-004, -005

STARTING POINT: INTERSECTION OF C/L OF GRIGGS RD. AND C/L OF CLARK RD.

17-03673

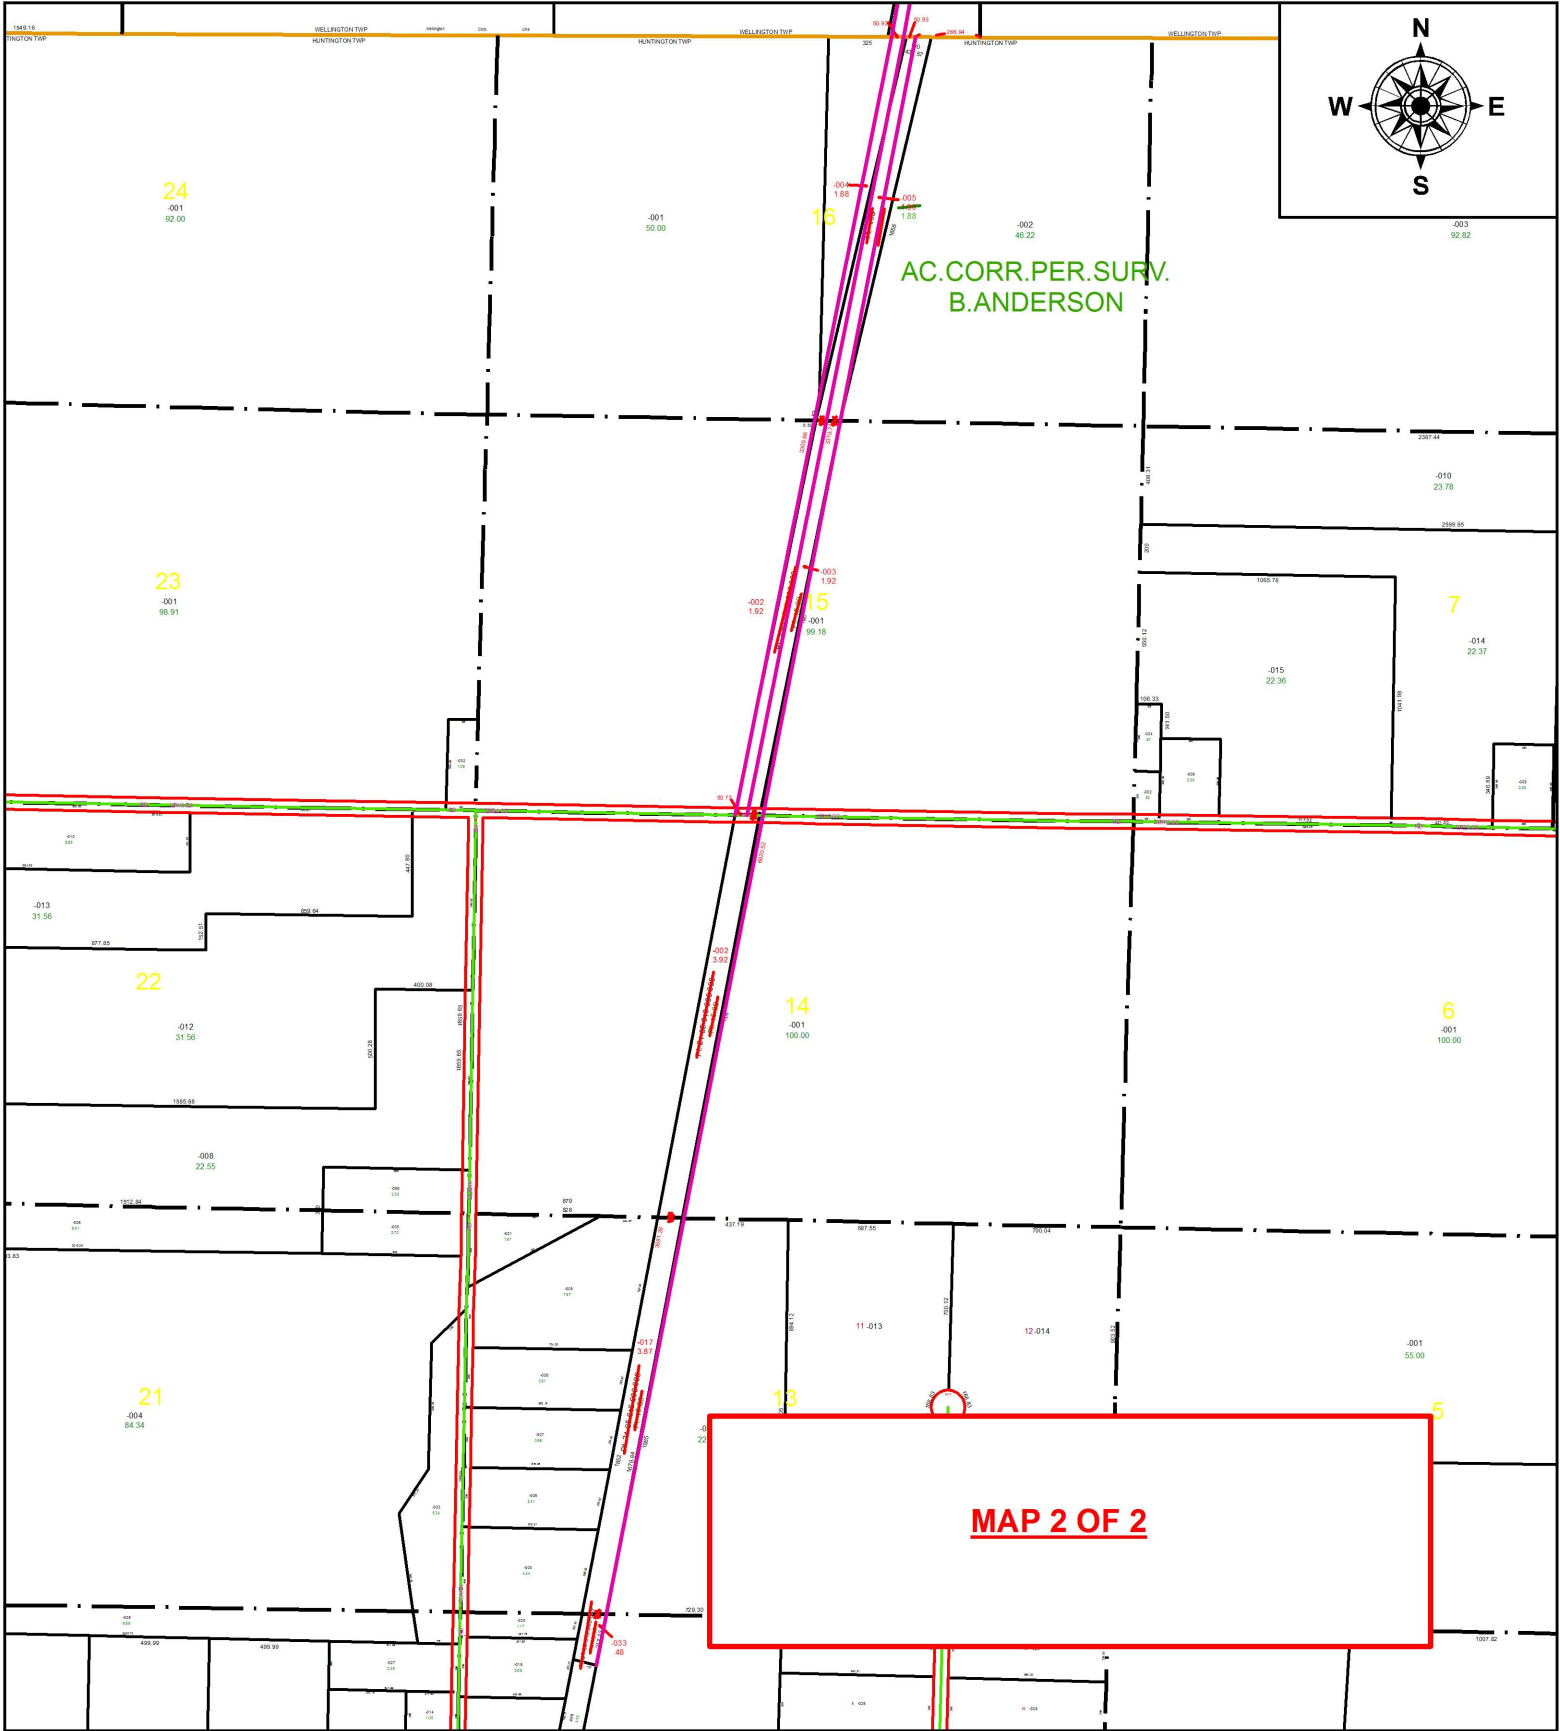

**SPLITS/DEEDS PROCESSED**  
 LORAIN COUNTY TAX MAP DEPARTMENT  
 226 MIDDLE AVE. ELYRIA, OH

**SURVEYED BY:** BRENT D. ANDERSON

**CLOSURE:** 1: 652,934

**MAP PAGE(S):** 21-B

**APPROVED BY:** RRM **DATE:** 5-26-17

**SCALE:** 1" = 800 **PRIOR INSTRUMENT:** DV 782/392