
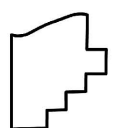


PARENT PARCEL: 09-00-095-104-003, -004

CHILD PARCEL: 09-00-095-104-031 THRU -033

STARTING POINT: SOUTHEAST CORNER OF S/L 4 IN VILLAGE PLAT OF OBERLIN

17-03679

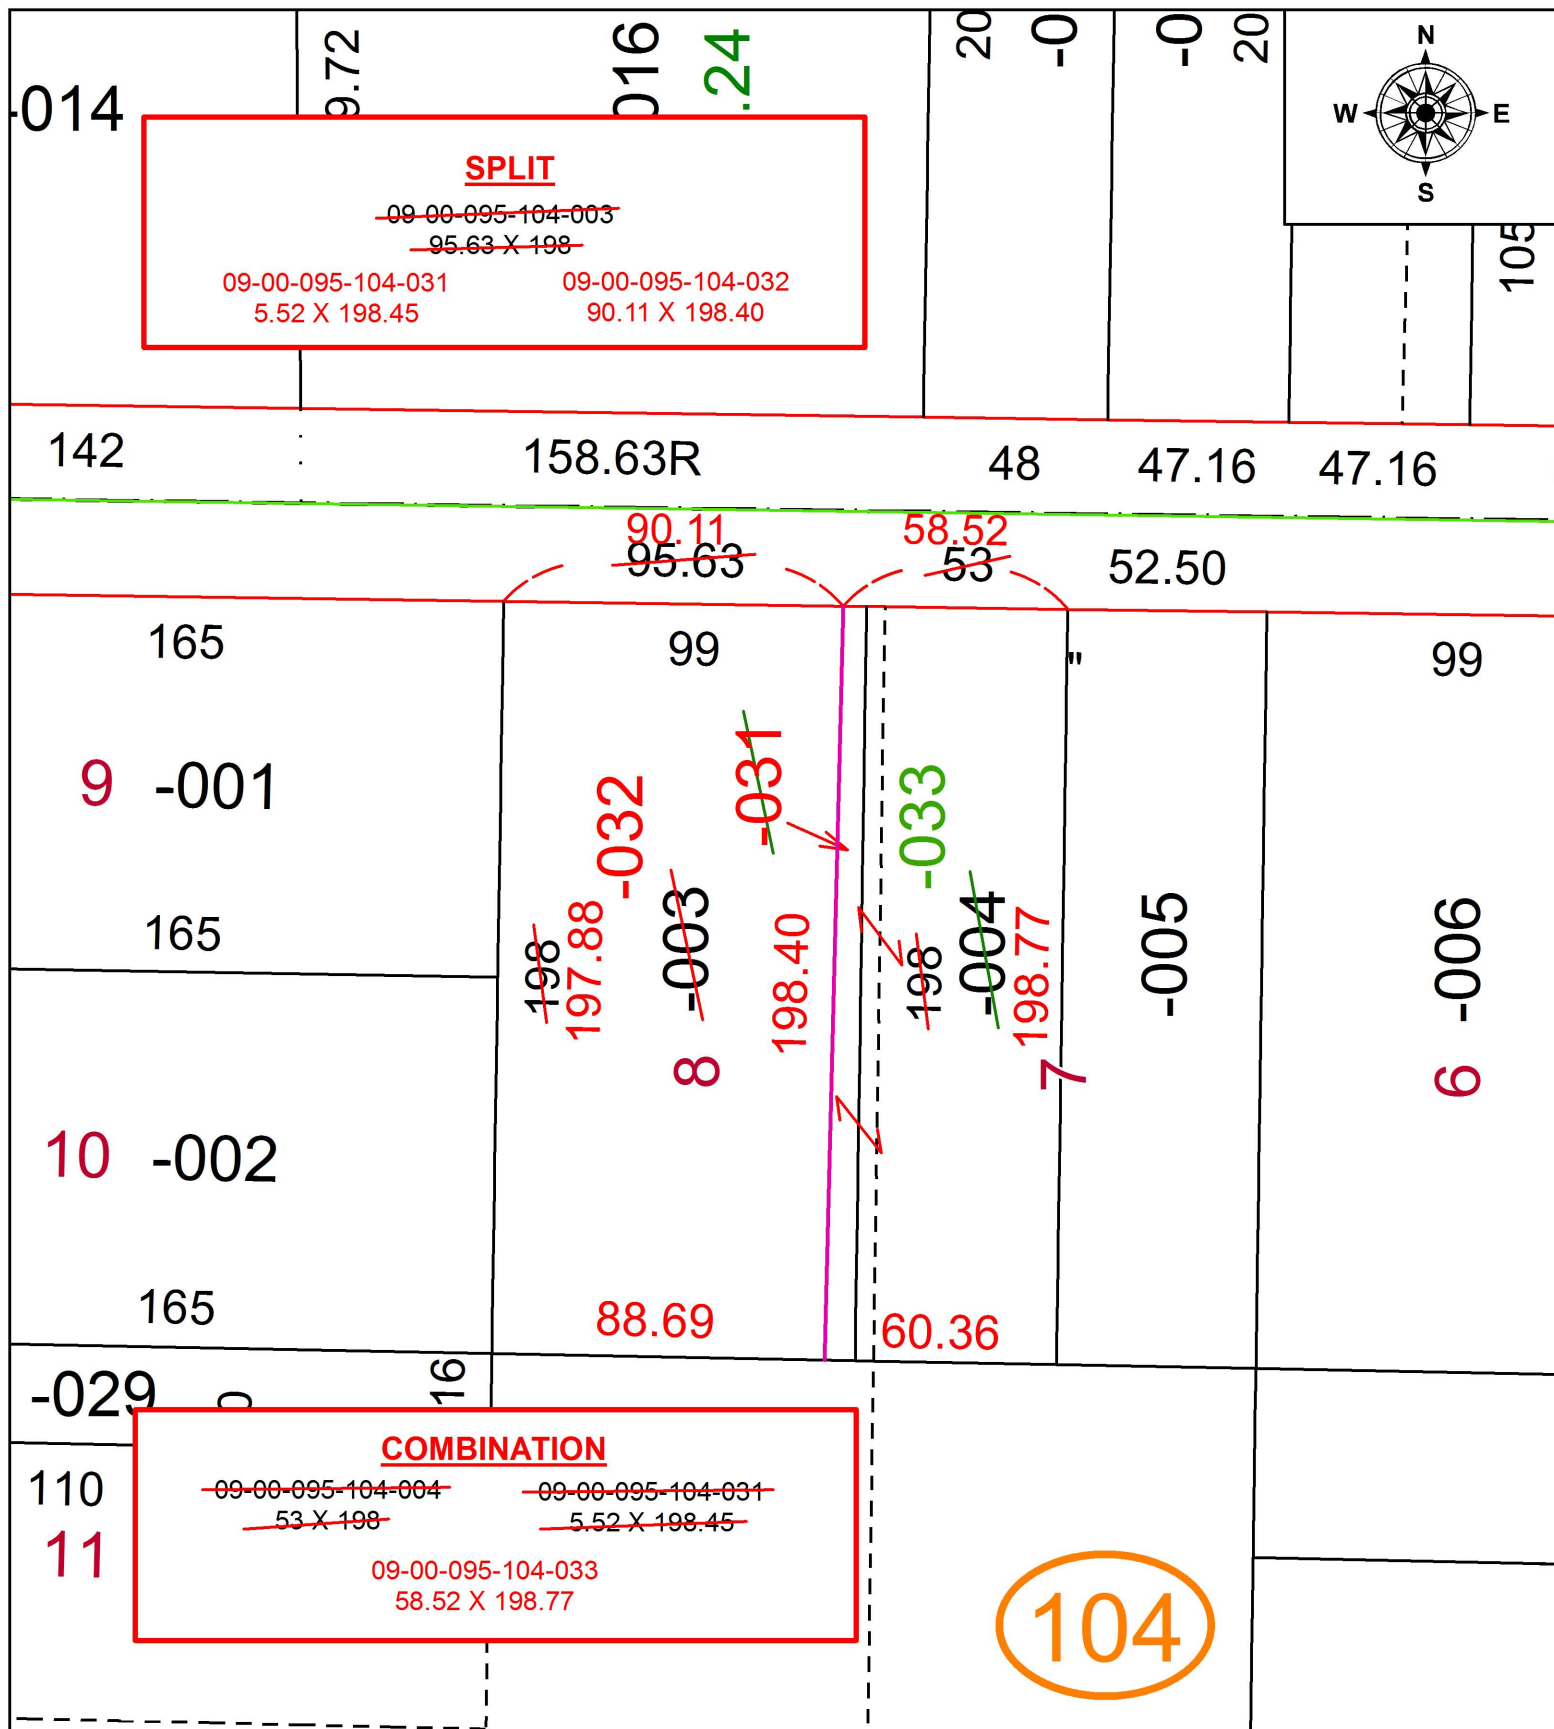

SPLITS/DEEDS PROCESSED
 LORAIN COUNTY TAX MAP DEPARTMENT
 226 MIDDLE AVE. ELYRIA, OH

SURVEYED BY: RICHARD A. FREDRICKSON
 CLOSURE: 1: 157,093
 MAP PAGE(S): 9-00-095
 APPROVED BY: RRM DATE: 6-20-17
 SCALE: 1" = 50 PRIOR INSTRUMENT: OR 1457/756