


PARENT PARCEL: 01-00-056-000-089

CHILD PARCEL: 01-00-056-000-090, -091

STARTING POINT: NORTHWEST CORNER OF O.L.56

17-03682

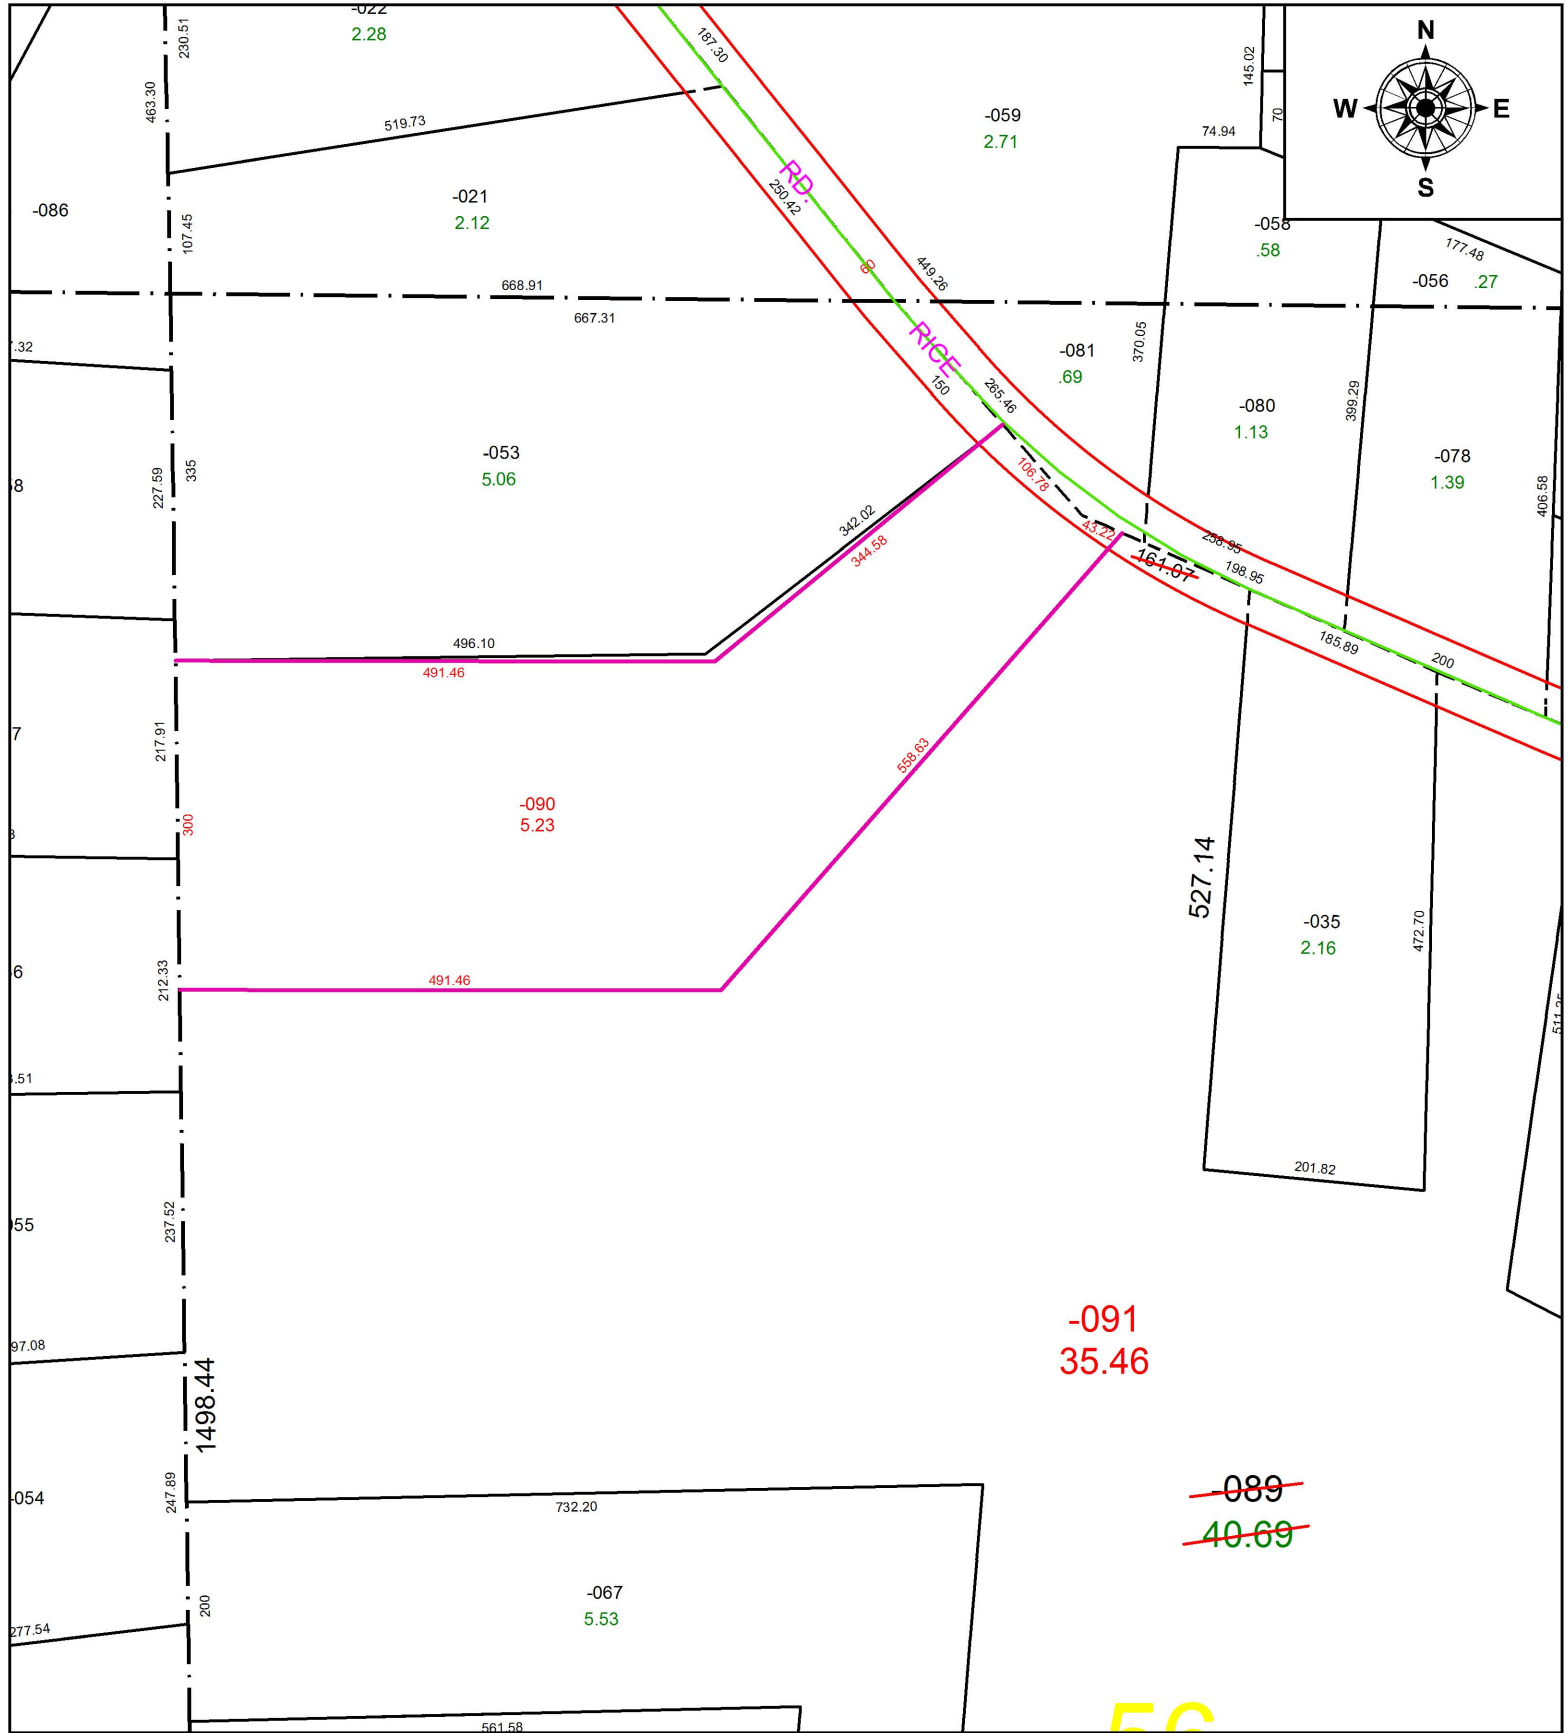

SPLITS/DEEDS PROCESSED
 LORAIN COUNTY TAX MAP DEPARTMENT
 226 MIDDLE AVE. ELYRIA, OH

SURVEYED BY: THOMAS A. SIMON
CLOSURE: 1: 463,954
MAP PAGE(S): 1-00-056
APPROVED BY: RRM **DATE:** 6-22-17
SCALE: 1" = 175 **PRIOR INSTRUMENT:** 20120411208