
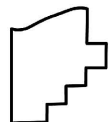


PARENT PARCEL: 11-00-047-000-055, 11-00-034-000-050
 CHILD PARCEL: 11-00-047-000-056, -057, 11-00-034-000-050
 STARTING POINT: SOUTHEAST CORNER OF O.L.47

17-03684

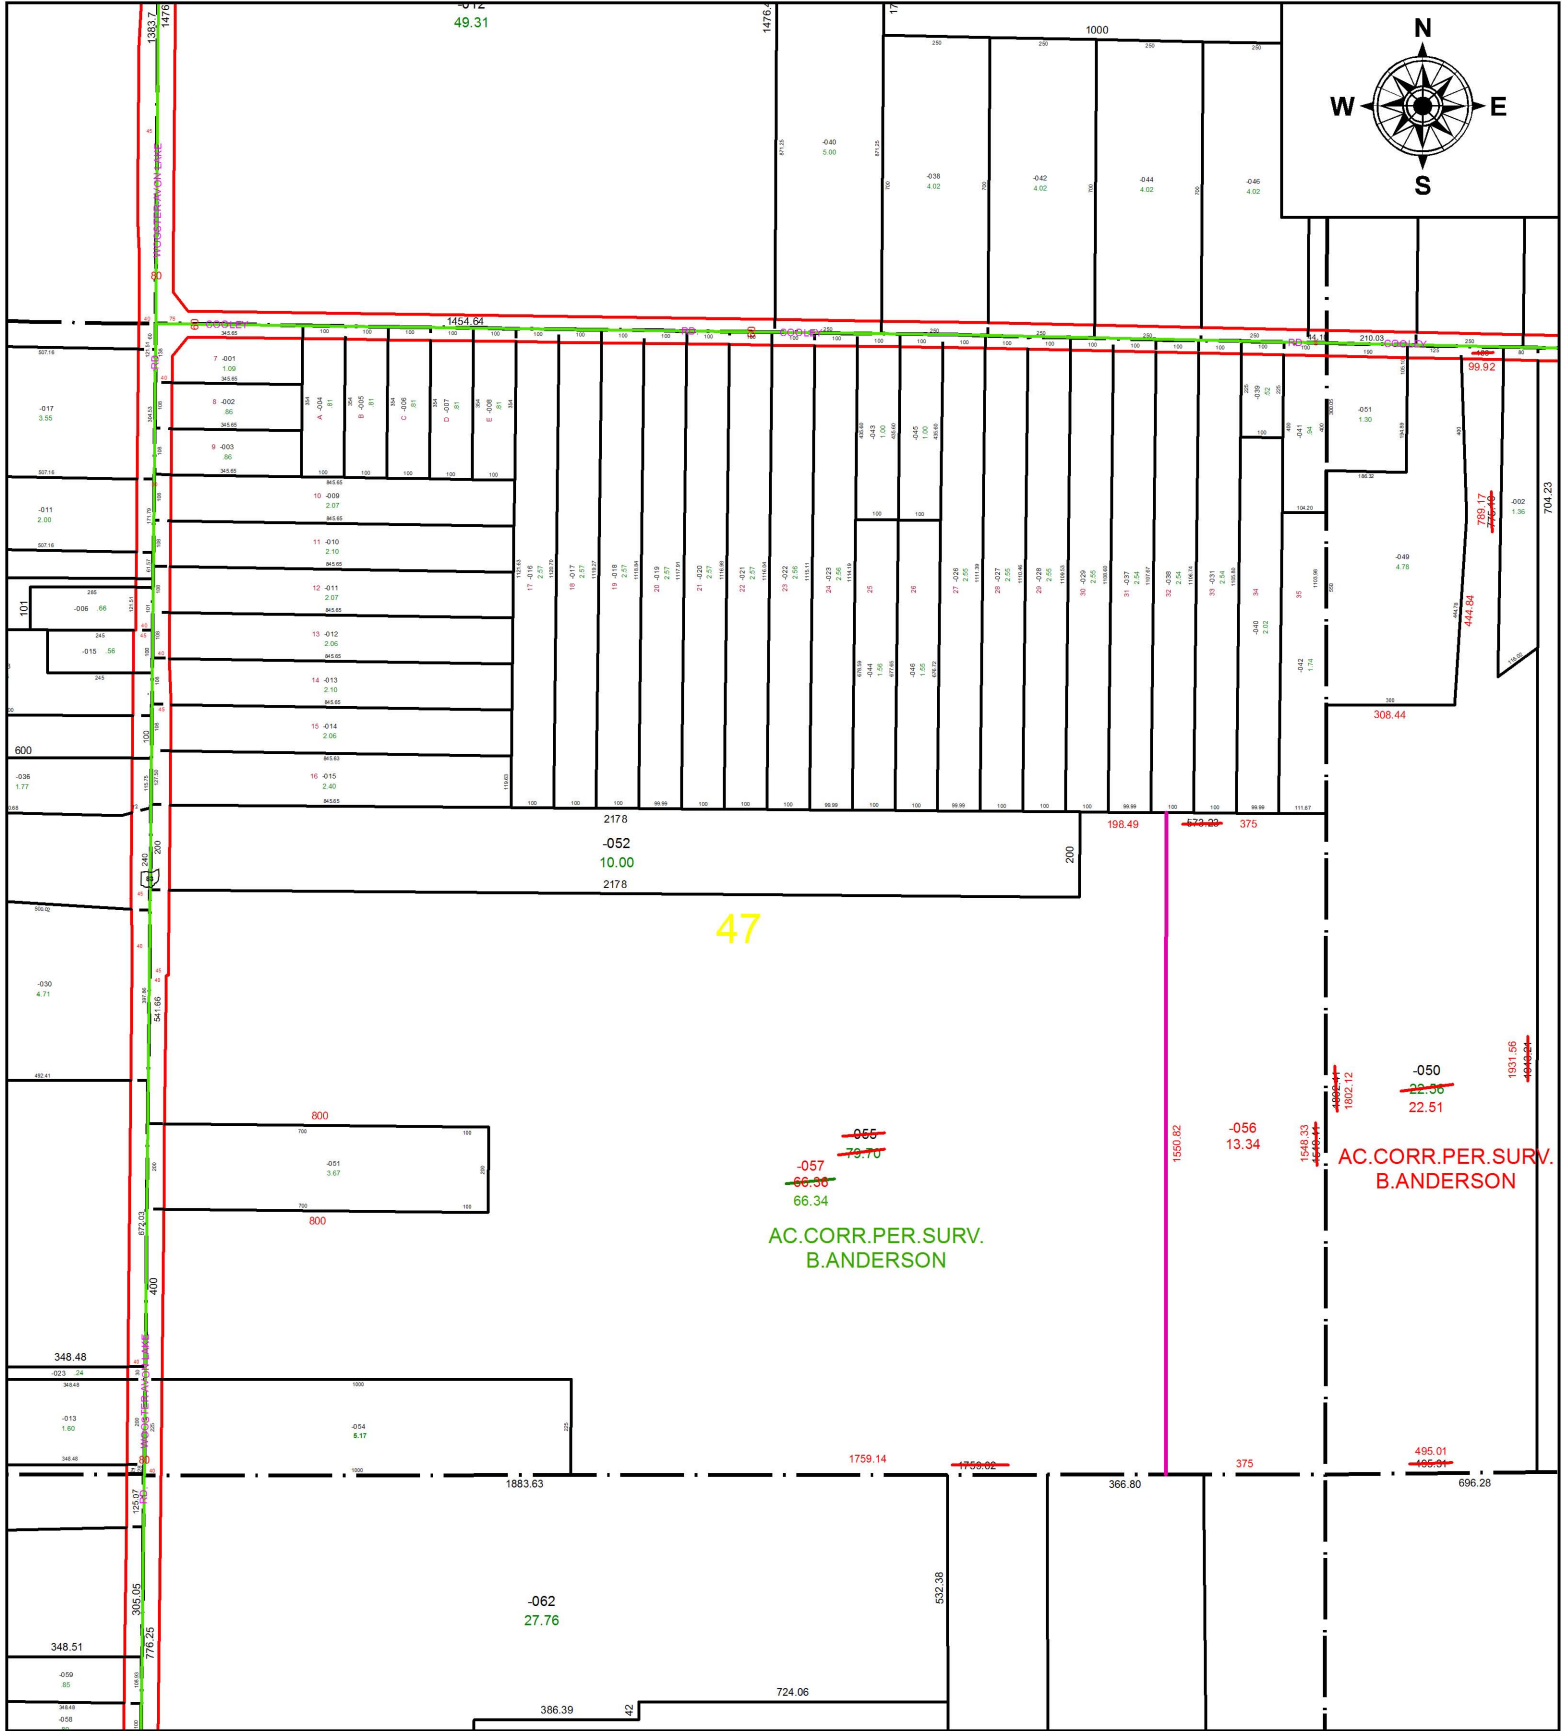

SPLITS/DEEDS PROCESSED
 LORAIN COUNTY TAX MAP DEPARTMENT
 226 MIDDLE AVE. ELYRIA, OH

SURVEYED BY: BRENT D, ANDERSON
 CLOSURE: 1: 98,816
 MAP PAGE(S): 11-00-047
 APPROVED BY: RRM DATE: 6-22-17
 SCALE: 1" = 450 PRIOR INSTRUMENT: 20080276466