


PARENT PARCEL: 15-00-099-101-220, -221

CHILD PARCEL: 15-00-099-101-234 THRU -236

STARTING POINT: SOUTHEAST CORNER OF O.L.99

17-03685

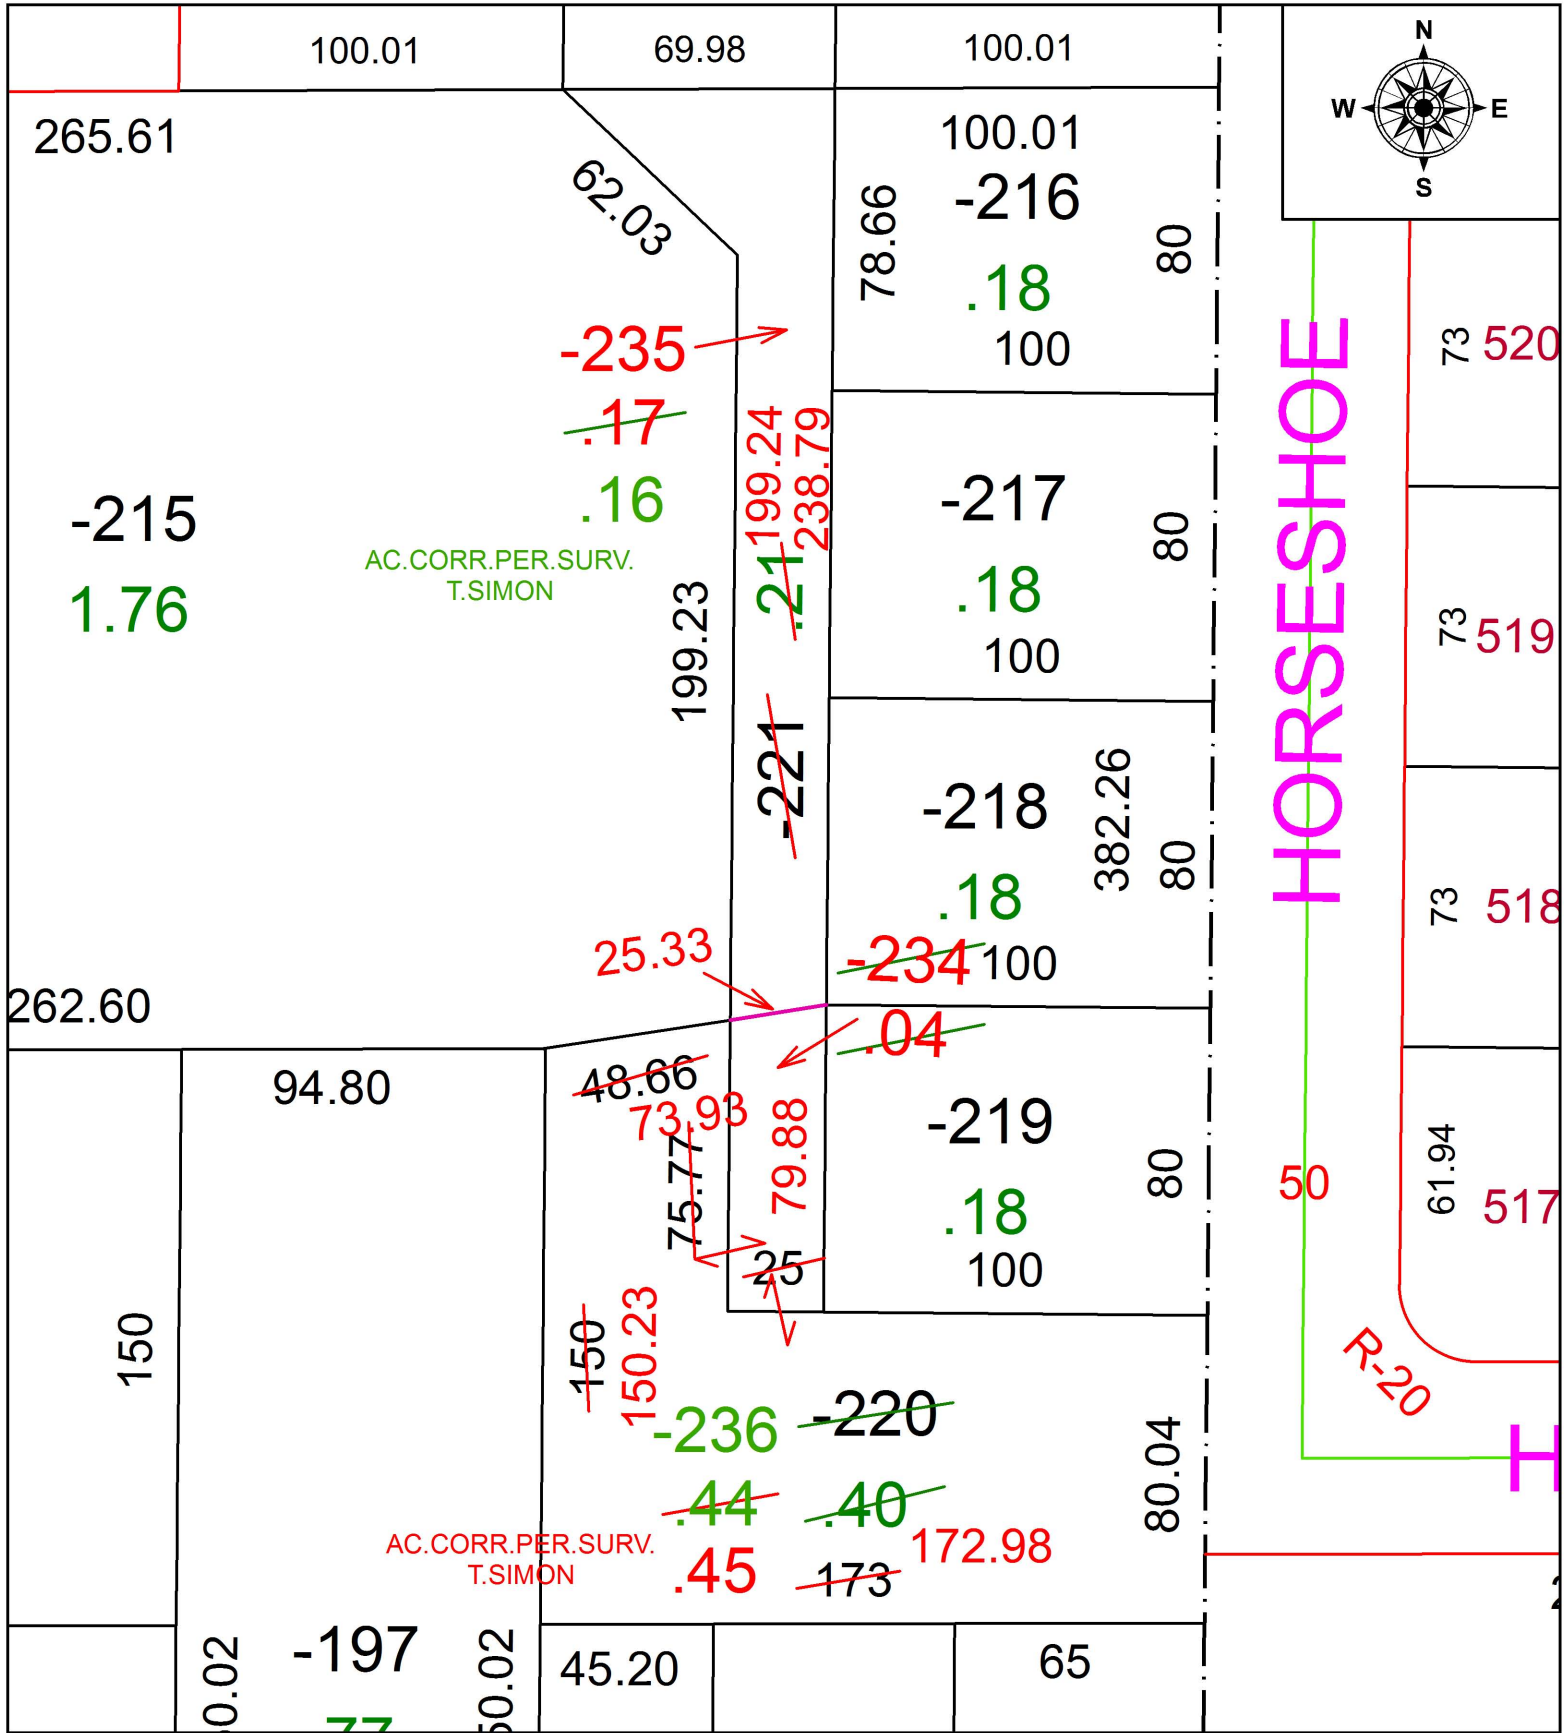

**SPLITS/DEEDS PROCESSED**  
 LORAIN COUNTY TAX MAP DEPARTMENT  
 226 MIDDLE AVE. ELYRIA, OH

SURVEYED BY: THOMAS A. SIMON  
 CLOSURE: 1: 42,824  
 MAP PAGE(S): 15-00-099  
 APPROVED BY: RRM DATE: 6-26-17  
 SCALE: 1" = 50 PRIOR INSTRUMENT: 20150554268