
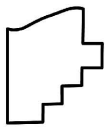


PARENT PARCEL: 15-00-098-106-046, -067

CHILD PARCEL: 15-00-098-106-046, -068, -069

STARTING POINT: NORTHWEST CORNER OF S/L 355 IN PHEASANT RUN VILLAGE PH.1

17-03686

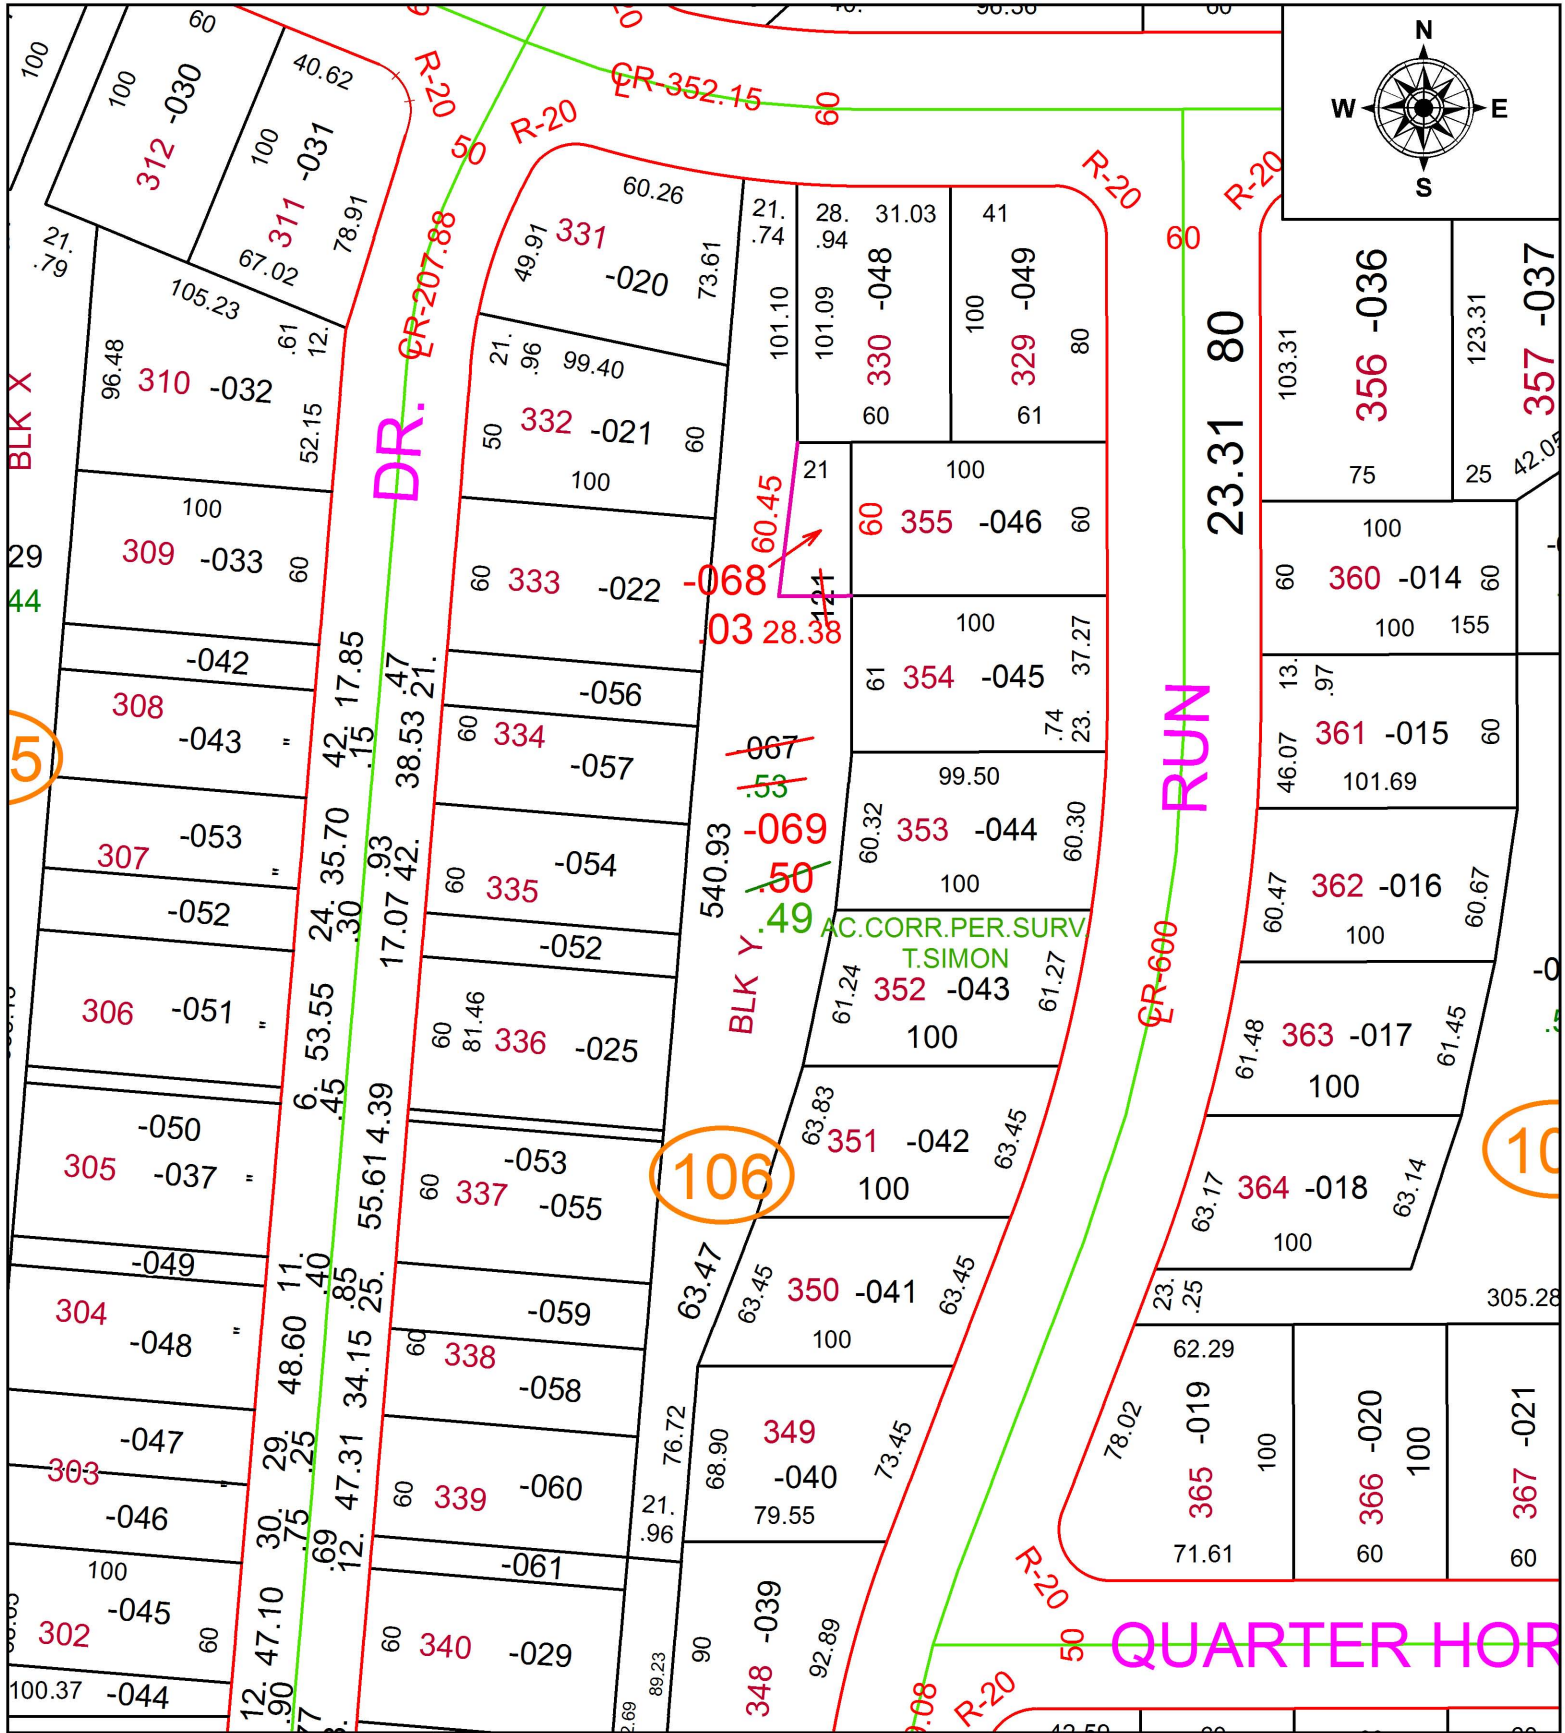

**SPLITS/DEEDS PROCESSED**

LORAIN COUNTY TAX MAP DEPARTMENT  
226 MIDDLE AVE. ELYRIA, OH

SURVEYED BY: THOMAS A. SIMON

CLOSURE: 1: 78,363

MAP PAGE(S): 15-00-098

APPROVED BY: RRM DATE: 6-26-17

SCALE: 1" = 75 PRIOR INSTRUMENT: 20150554268