


PARENT PARCEL: 01-00-006-102-045

CHILD PARCEL: 01-00-006-102-055, -056

STARTING POINT: INTERSECTION OF C/L OF LIBERTY AVE. AND C/L OF BAUMHART RD,

17-03687

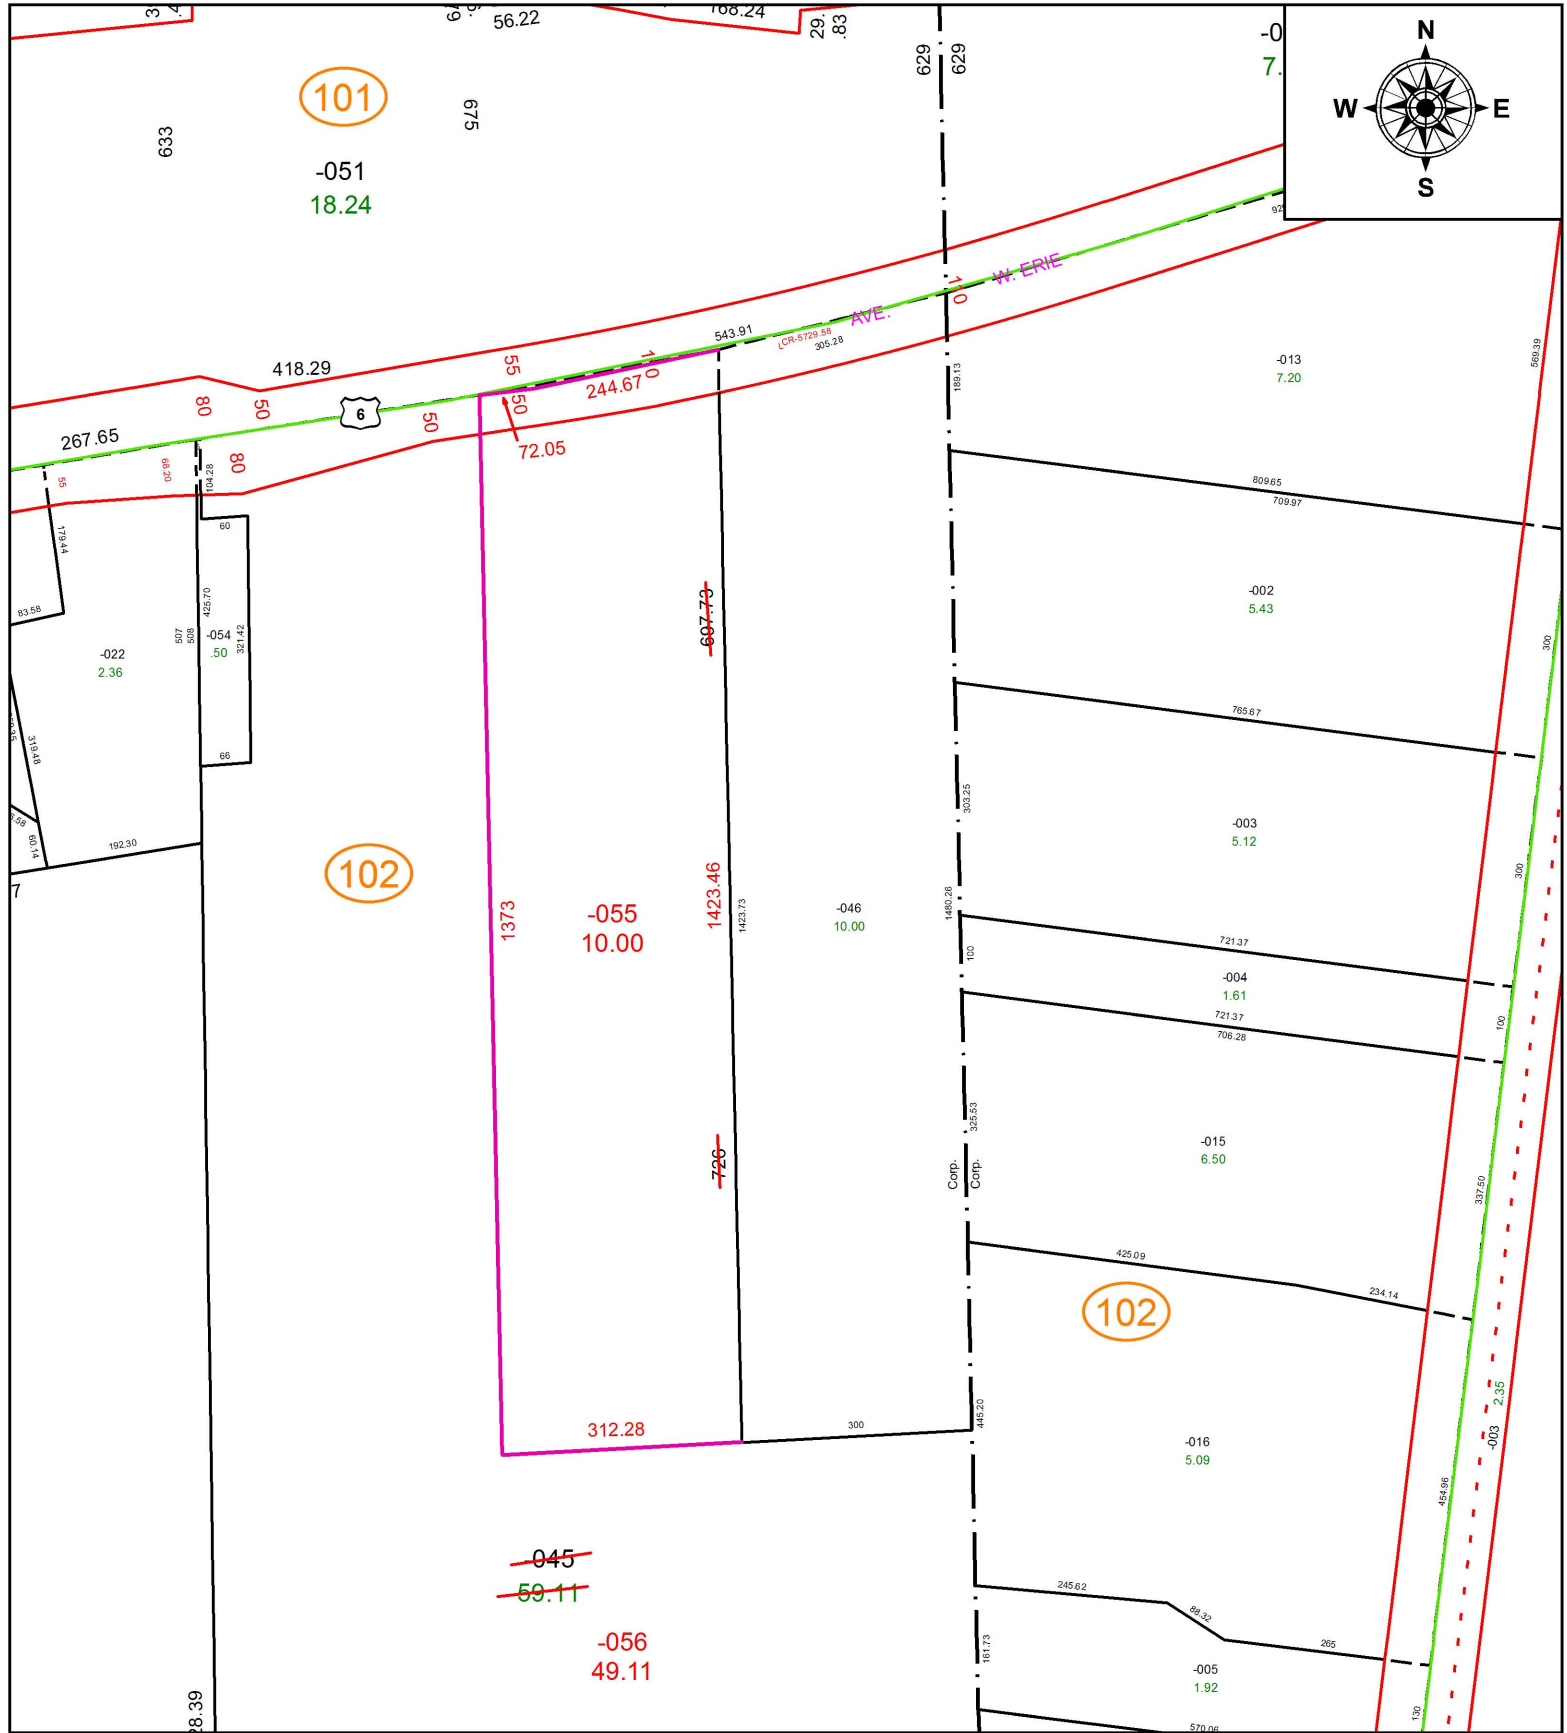

SPLITS/DEEDS PROCESSED
 LORAIN COUNTY TAX MAP DEPARTMENT
 226 MIDDLE AVE. ELYRIA, OH

SURVEYED BY: GUY P. HANEY
 CLOSURE: 1: 705,884
 MAP PAGE(S): 1-00-006
 APPROVED BY: RRM DATE: 6-29-17
 SCALE: 1" = 250 PRIOR INSTRUMENT: 20120399948