
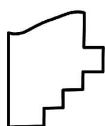


PARENT PARCEL: 02-02-001-104-063

CHILD PARCEL: XX-XX-XXX-XXX-XXX

STARTING POINT: CL OF KOLBE RD. & CL OF COOPER FOSTER PARK RD.

17-03690-C

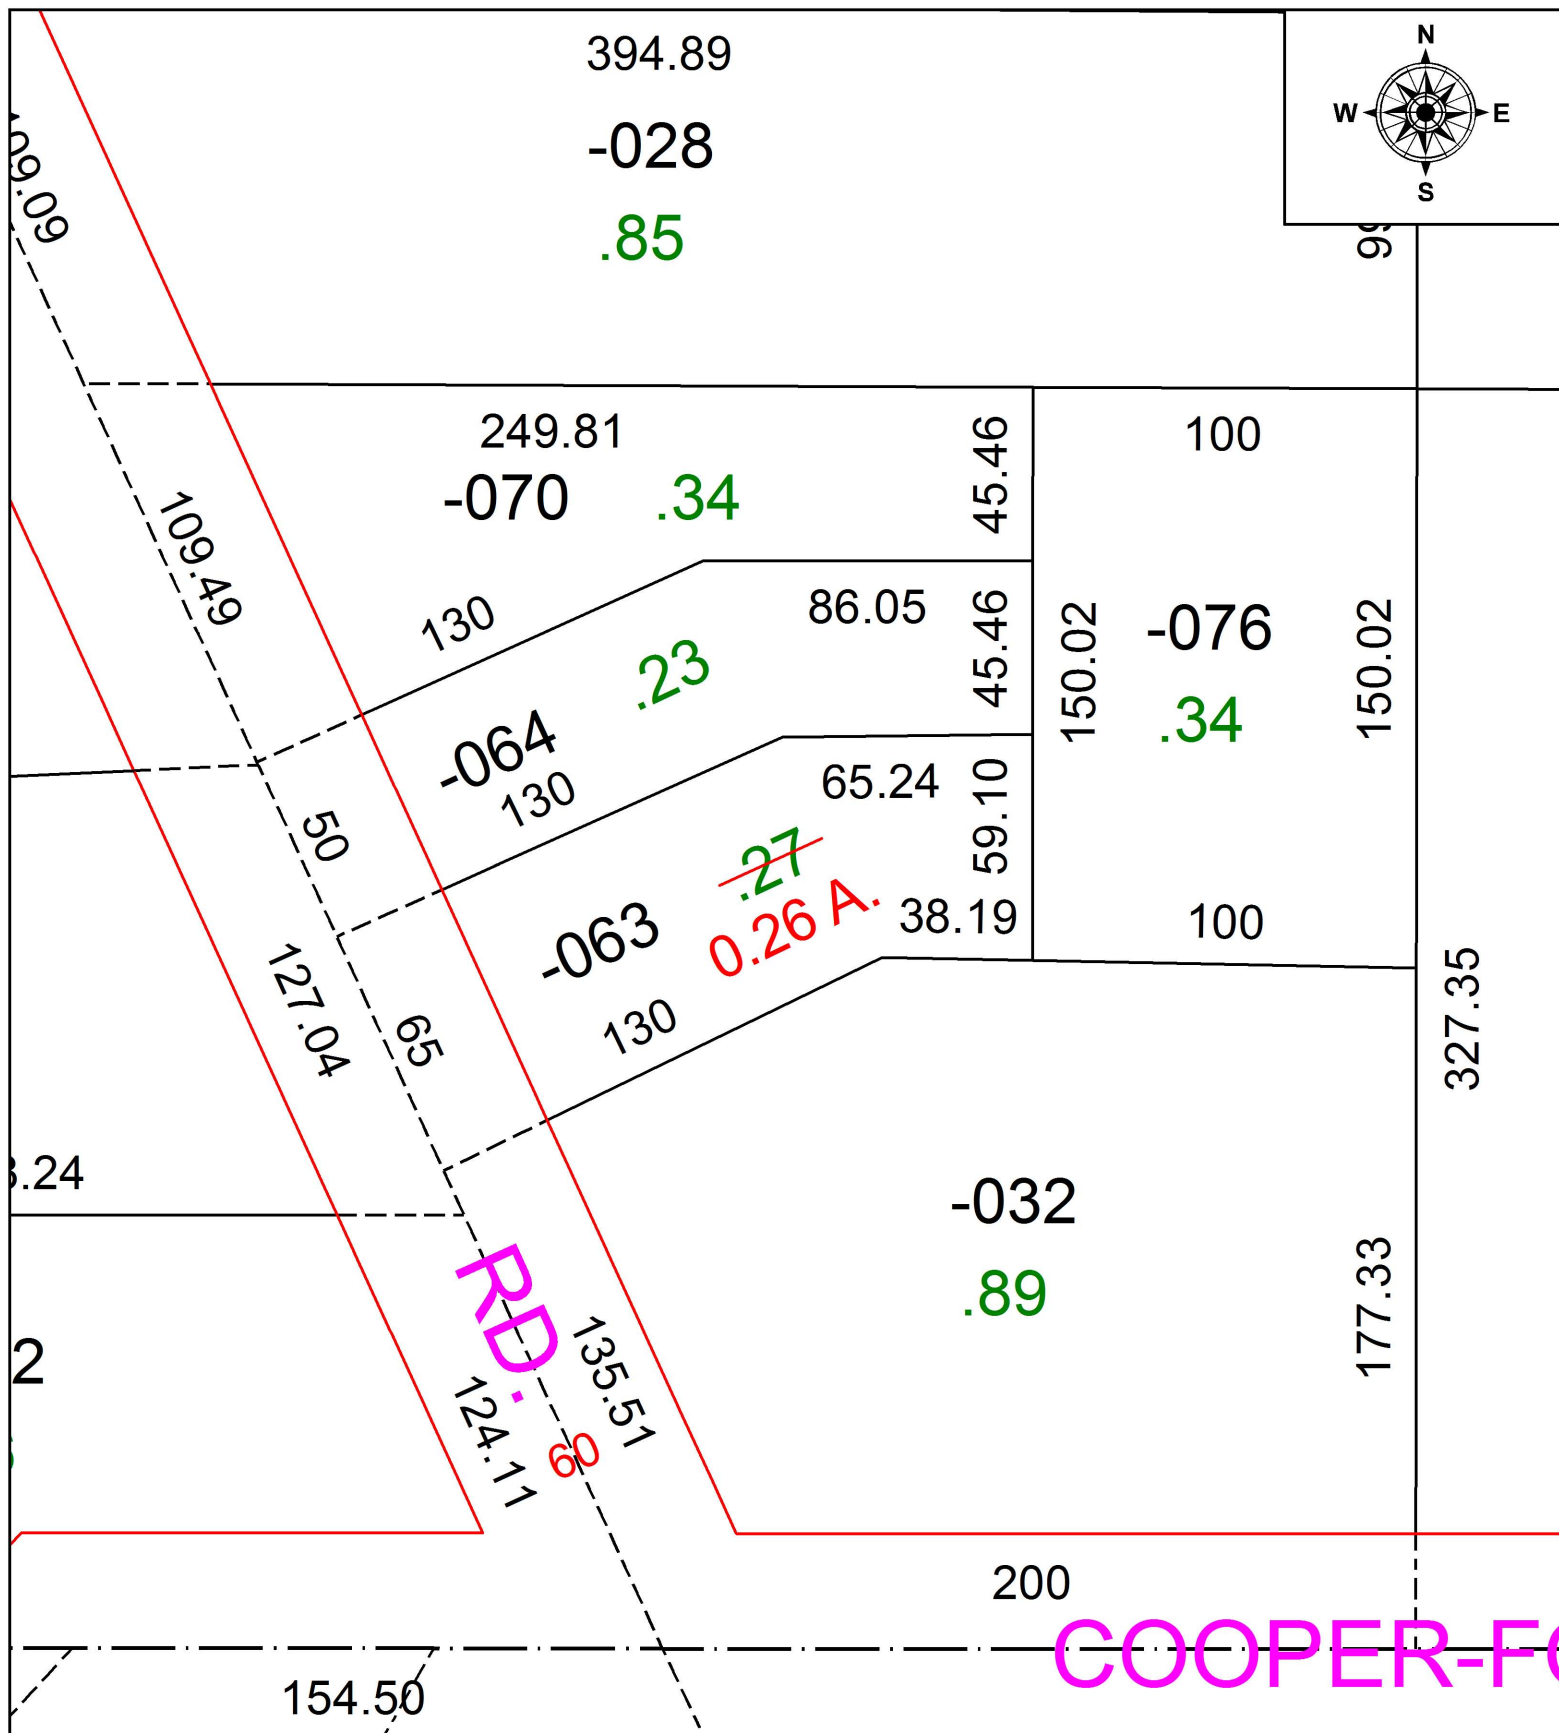

SPLITS/DEEDS PROCESSED
 LORAIN COUNTY TAX MAP DEPARTMENT
 226 MIDDLE AVE. ELYRIA, OH

SURVEYED BY: NA
 CLOSURE: 1: 33,000
 MAP PAGE(S): 02-02-001
 APPROVED BY: TJS DATE: 7/27/17
 SCALE: 1" = 50' PRIOR INSTRUMENT: 2017-0633737