


PARENT PARCEL: 02-02-029-101-020

CHILD PARCEL: XX-XX-XXX-XXX-XXX

STARTING POINT: NORTHWEST CORNER OF S/L 3 IN HARBOR VIEW ALLOT.

17-03693-X

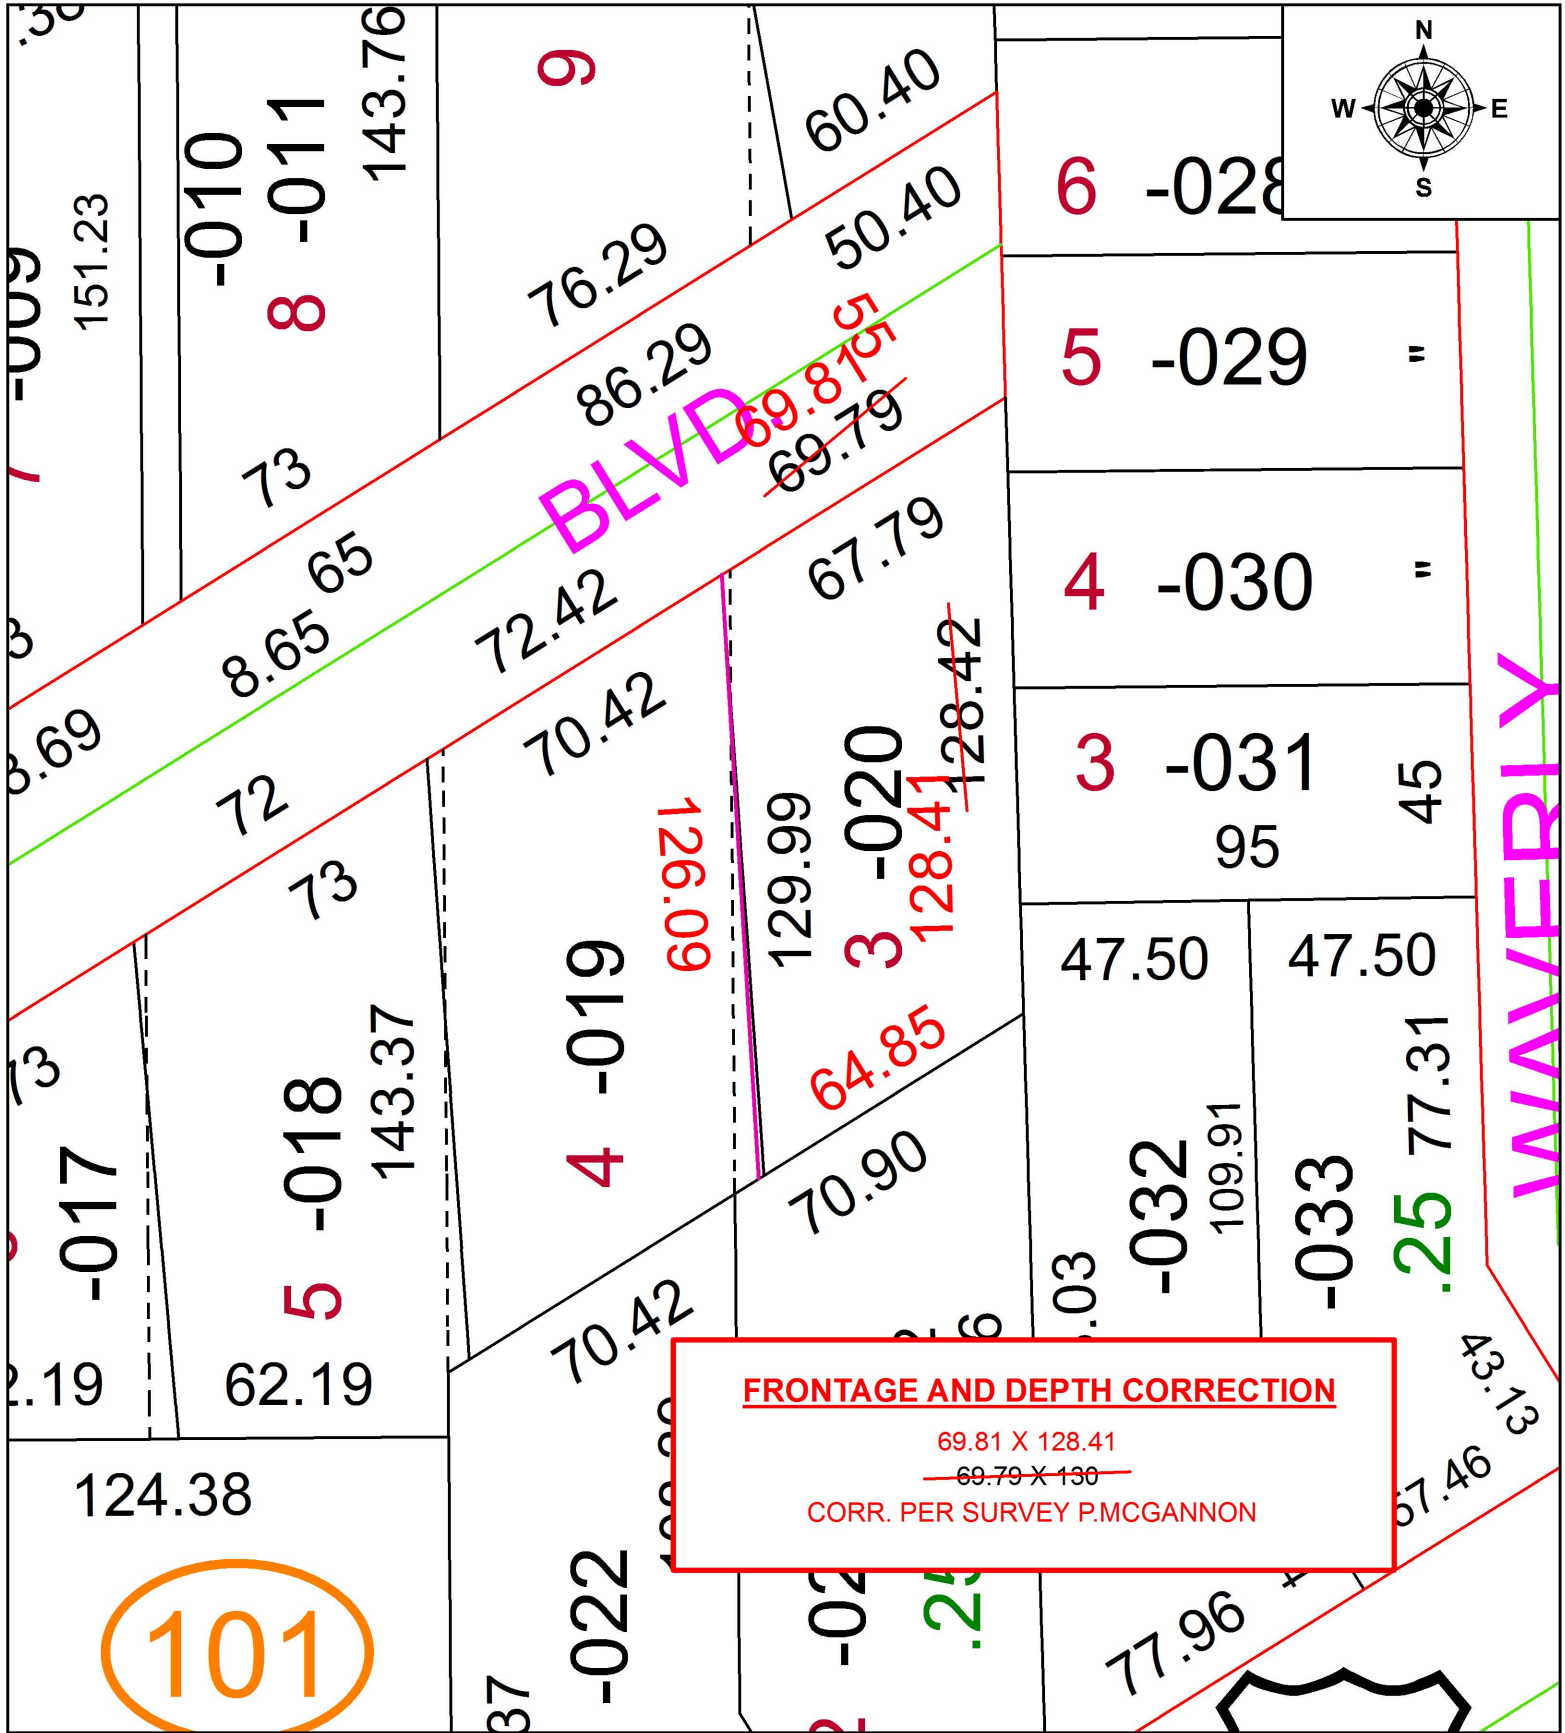

FRONTAGE AND DEPTH CORRECTION
 69.81 X 128.41
~~69.79 X 130~~
 CORR. PER SURVEY P.MCGANNON

101



SPLITS/DEEDS PROCESSED
 LORAIN COUNTY TAX MAP DEPARTMENT
 226 MIDDLE AVE. ELYRIA, OH

SURVEYED BY: PATRICK A. MCGANNON
 CLOSURE: 1: 52,919
 MAP PAGE(S): 2-02-029
 APPROVED BY: RRM DATE: 6-23-17
 SCALE: 1" = 40 PRIOR INSTRUMENT: 20140501953