
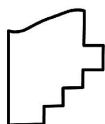
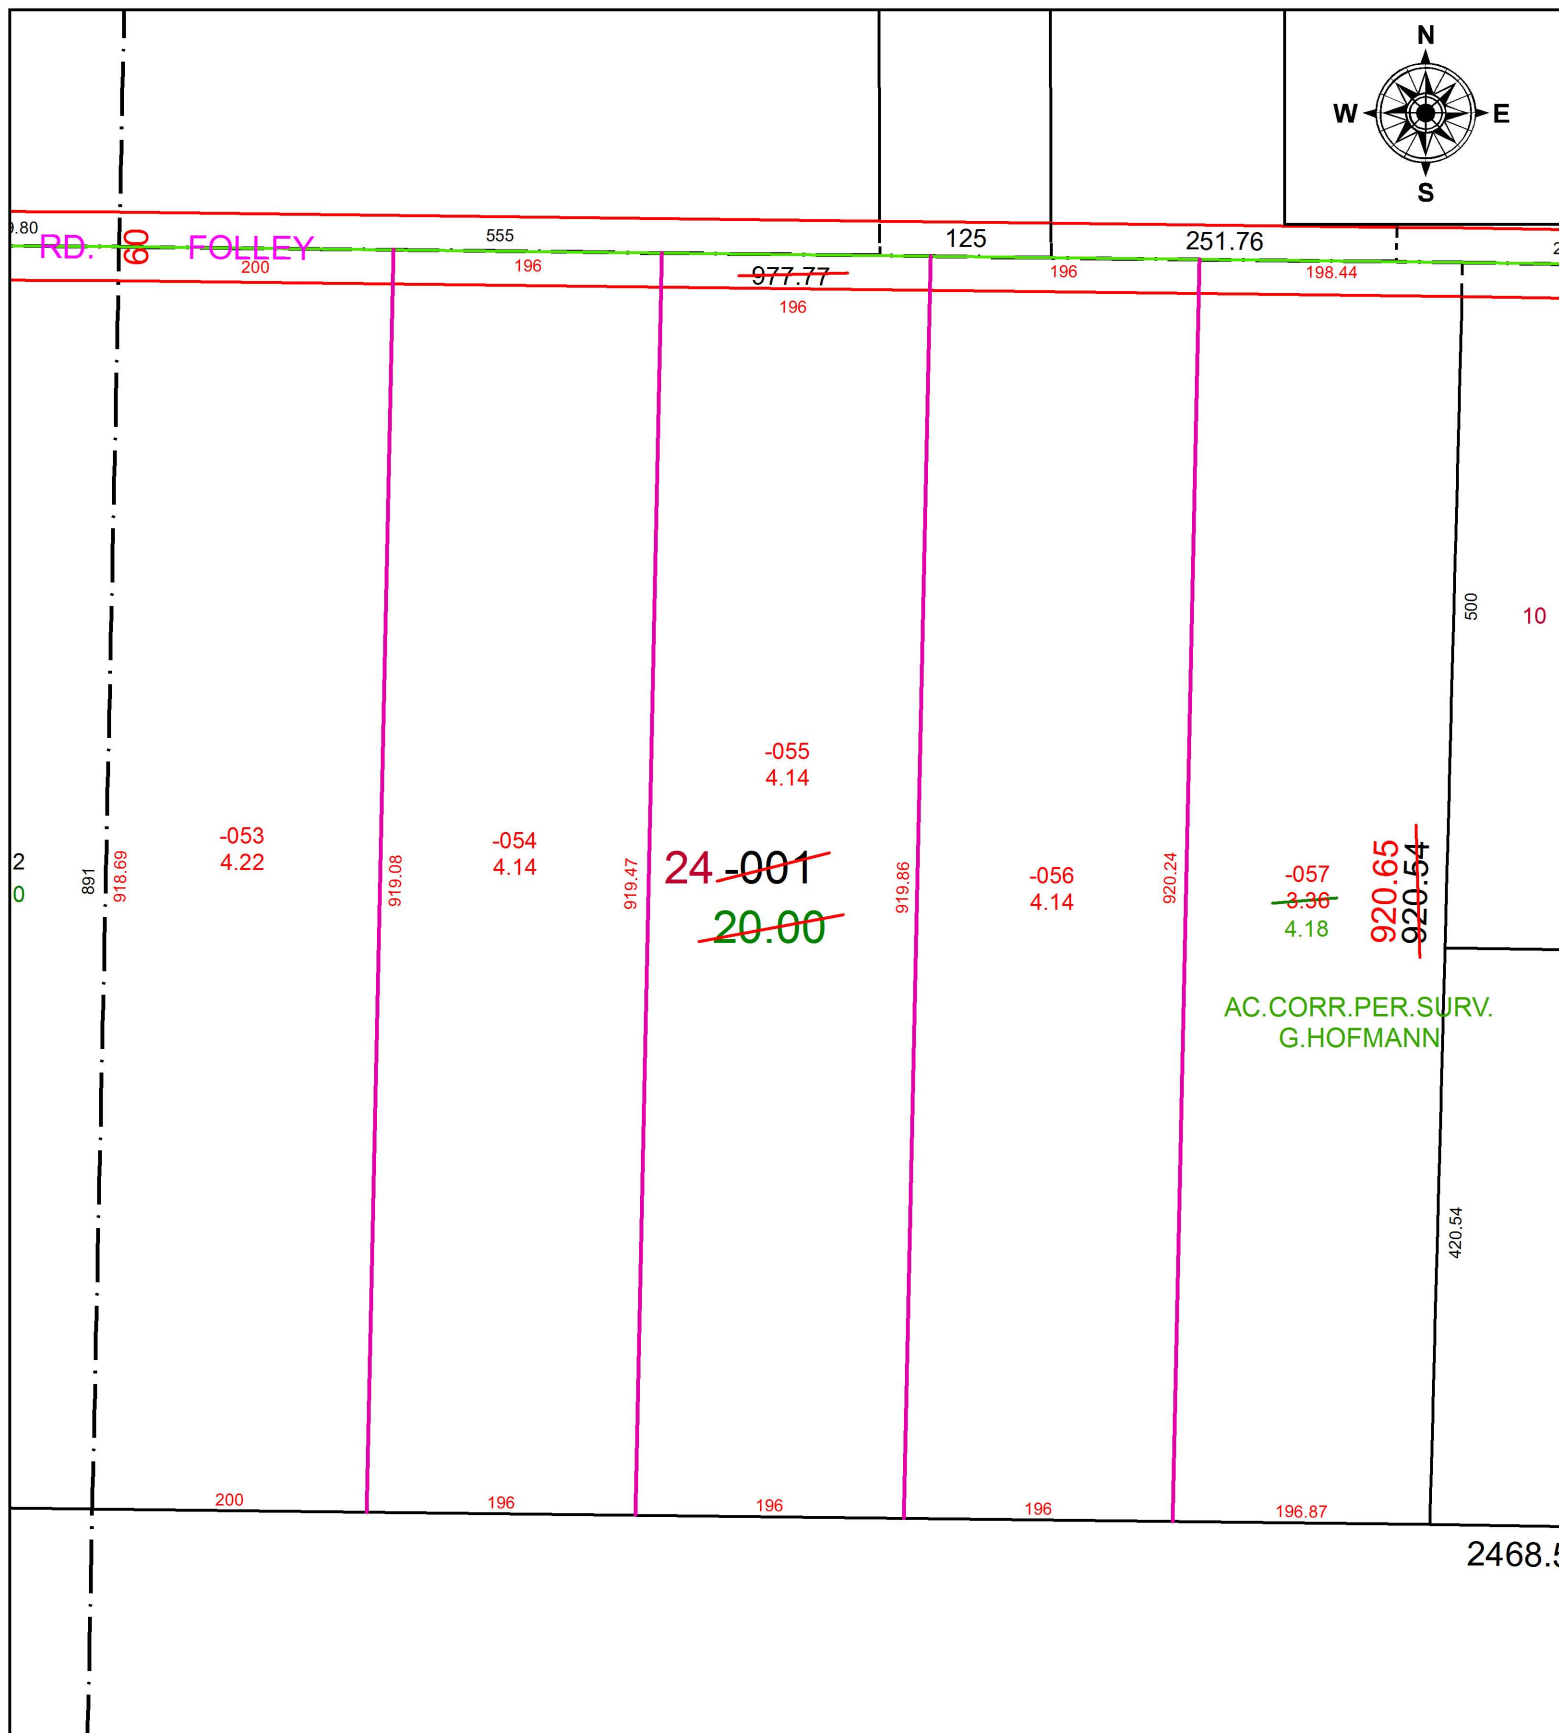


PARENT PARCEL: 12-00-056-000-001

CHILD PARCEL: 12-00-056-000-053 THRU -057

STARTING POINT: NORTHWEST CORNER OF O.L.56

17-03697

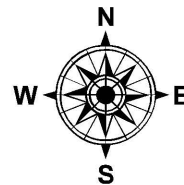

**SPLITS/DEEDS PROCESSED**  
 LORAIN COUNTY TAX MAP DEPARTMENT  
 226 MIDDLE AVE. ELYRIA, OH

SURVEYED BY: GEORGE HOFMANN  
 CLOSURE: 1: 46,077  
 MAP PAGE(S): 12-00-056  
 APPROVED BY: RRM DATE: 8-8-17  
 SCALE: 1" = 140 PRIOR INSTRUMENT: OR 311/615