
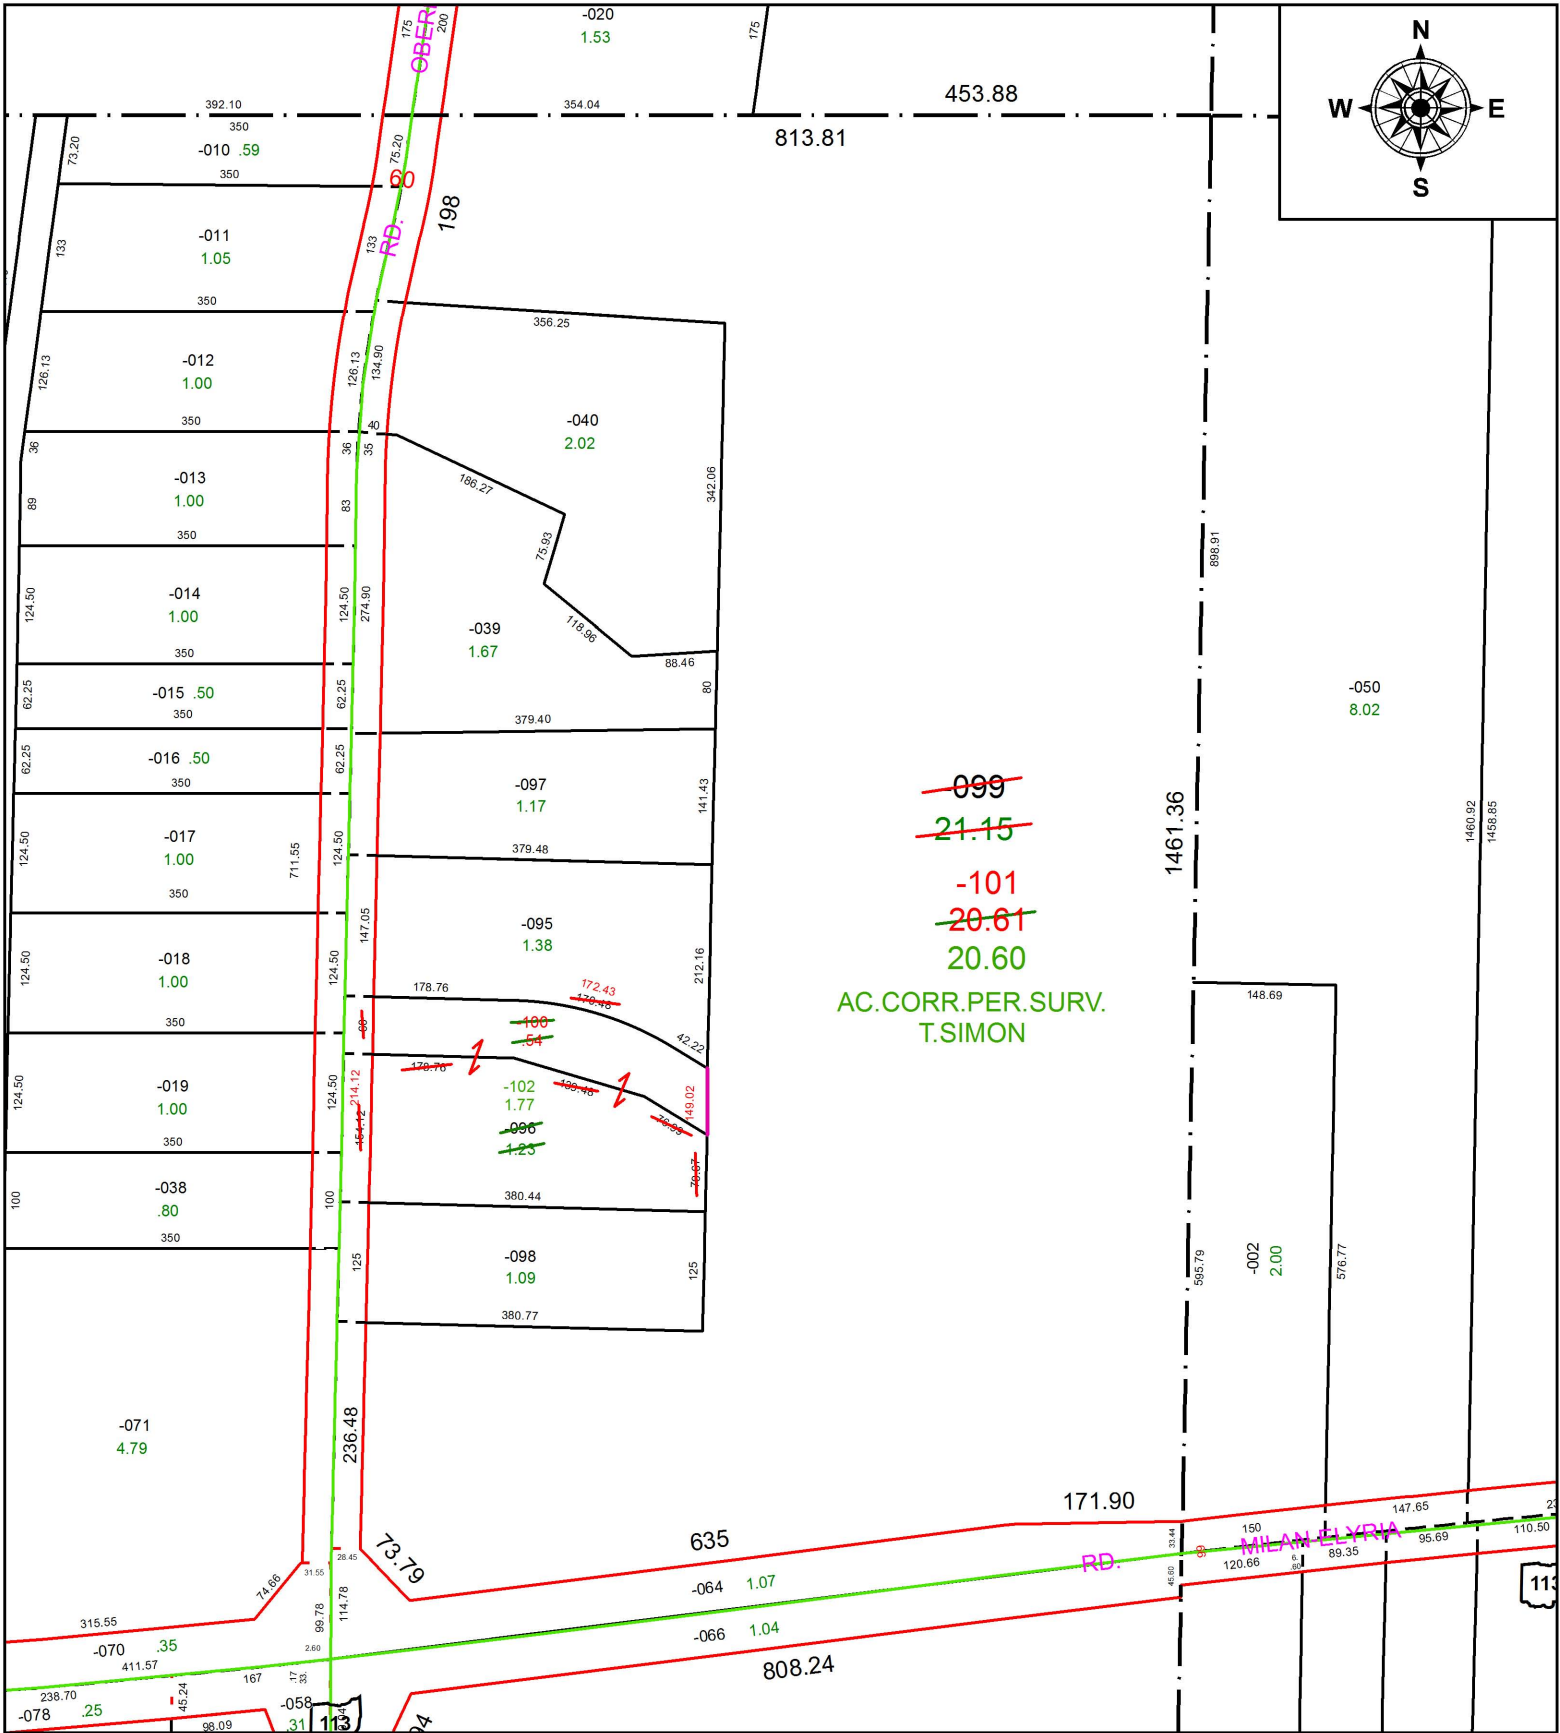


PARENT PARCEL: 05-00-053-000-096, -099


CHILD PARCEL: 05-00-053-000-100 THRU -102

STARTING POINT: INTERSECTION OF C/L OF OBERLIN RD. AND NORTH LINE OF O.L.53

17-03702

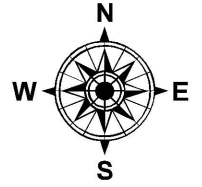

~~099~~
~~21.15~~
~~-101~~
~~20.61~~
20.60
AC.CORR.PER.SURV.
T.SIMON

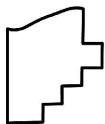

SPLITS/DEEDS PROCESSED
LORAIN COUNTY TAX MAP DEPARTMENT
226 MIDDLE AVE. ELYRIA, OH

SURVEYED BY: THOMAS A. SIMON

CLOSURE: 1: 71,764

MAP PAGE(S): 5-00-053

APPROVED BY: RRM DATE: 7-24-17

SCALE: 1" = 200 PRIOR INSTRUMENT: 20070190202