


PARENT PARCEL: 05-00-022-102-016


CHILD PARCEL: 05-00-022-102-032, -033

STARTING POINT: NORTHWEST CORNER OF WASHINGTON PARK SUB. NO.1

17-03703-U

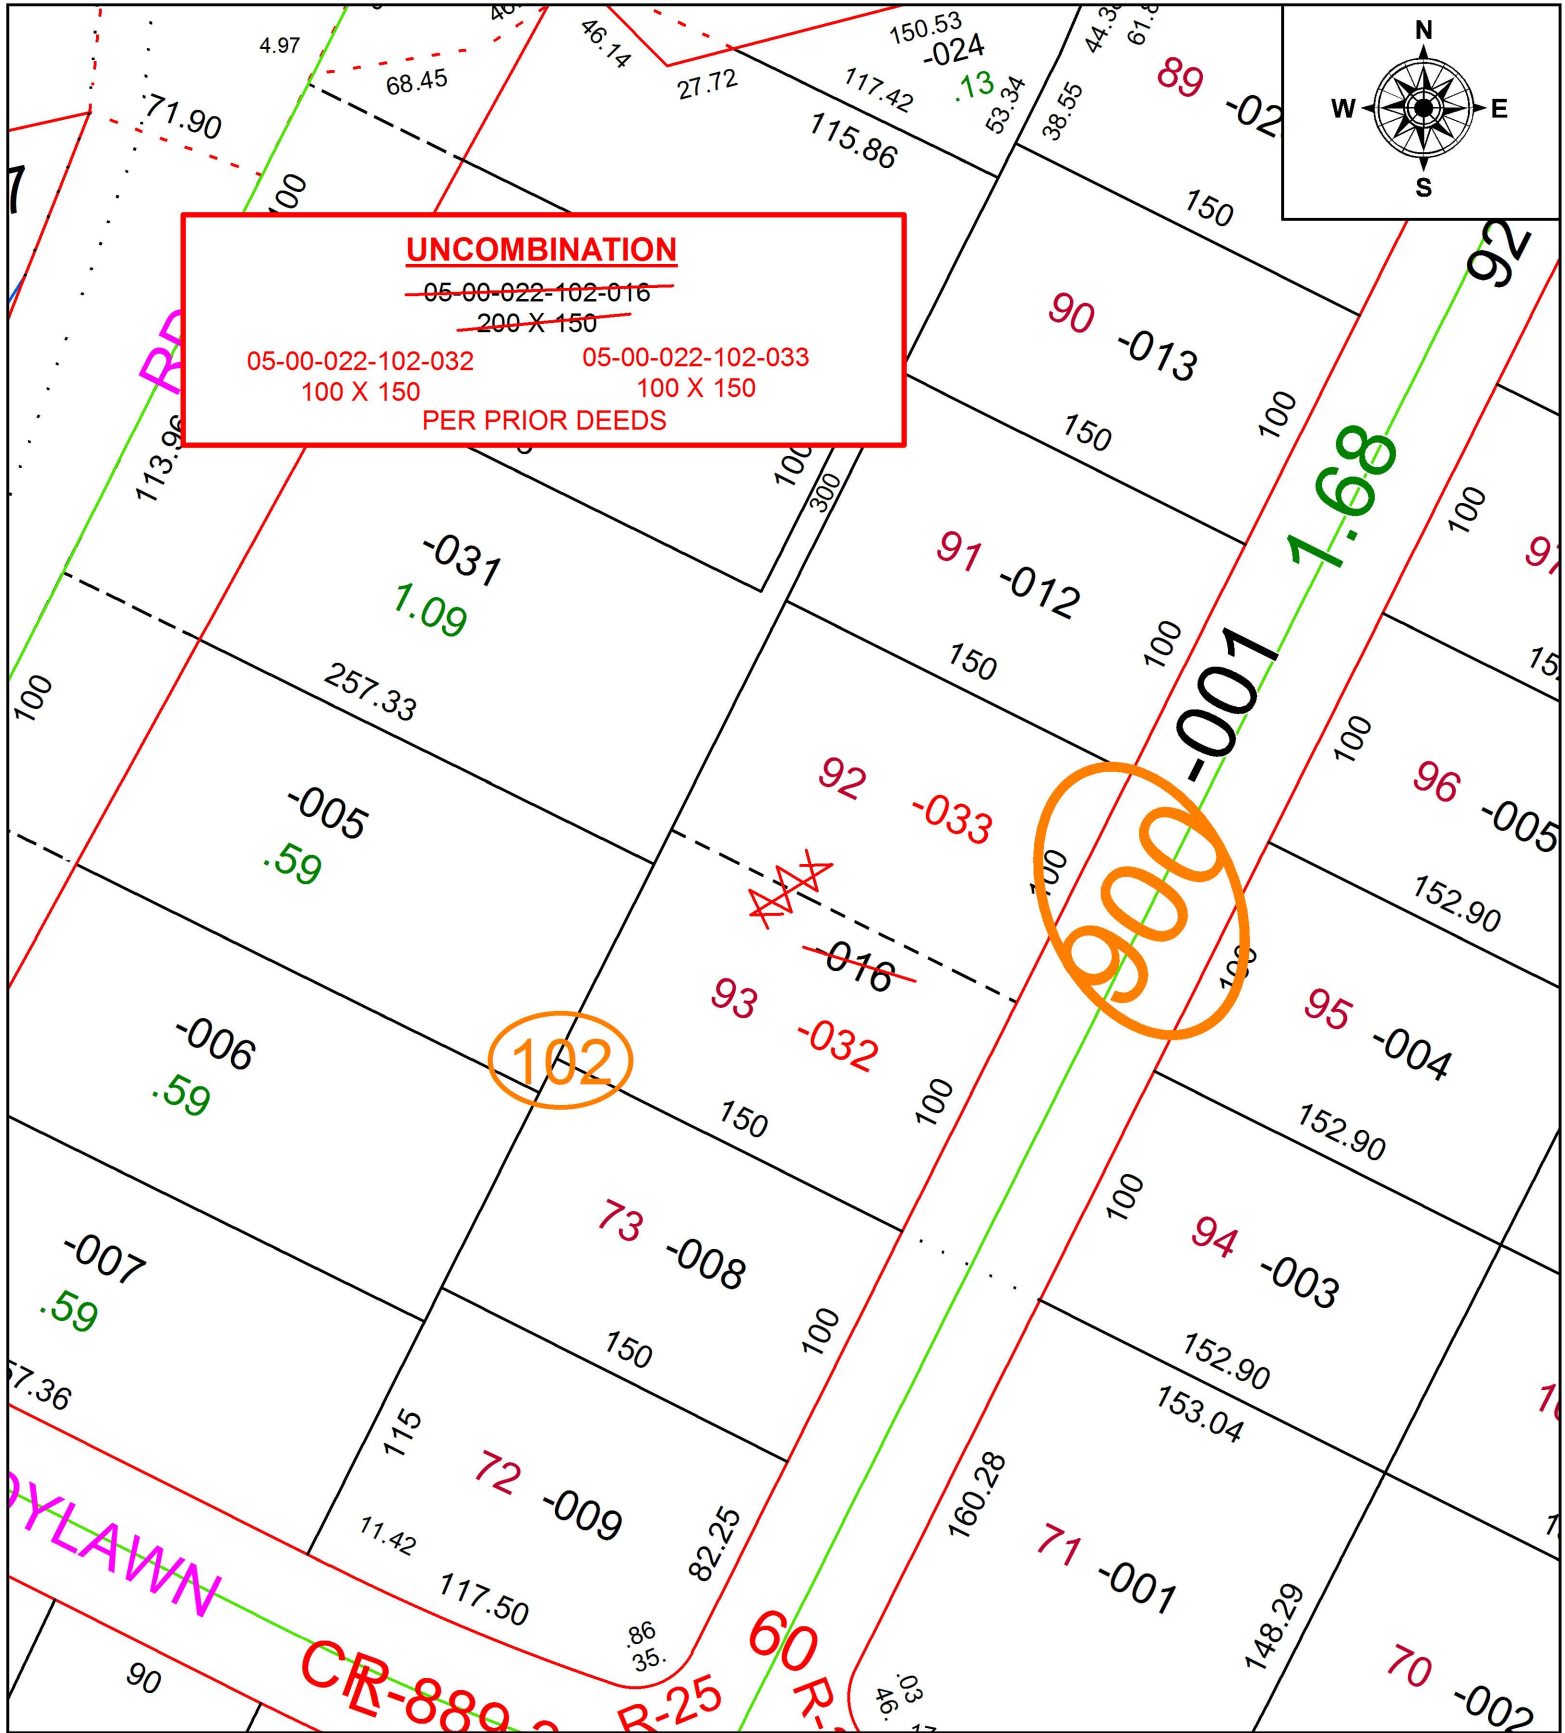


UNCOMBINATION
~~05-00-022-102-016~~
~~200 X 150~~
 05-00-022-102-032 05-00-022-102-033
 100 X 150 100 X 150
 PER PRIOR DEEDS

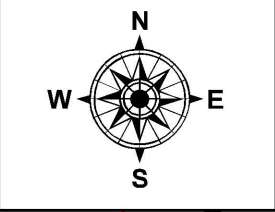

102

900

1.68

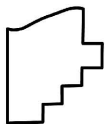

SPLITS/DEEDS PROCESSED
 LORAIN COUNTY TAX MAP DEPARTMENT
 226 MIDDLE AVE. ELYRIA, OH

SURVEYED BY: RAY E. HOLLIS
 CLOSURE: 1: 2147483648
 MAP PAGE(S): 5-00-022
 APPROVED BY: RRM DATE: 7-6-17
 SCALE: 1" = 75 PRIOR INSTRUMENT: 20170633452